


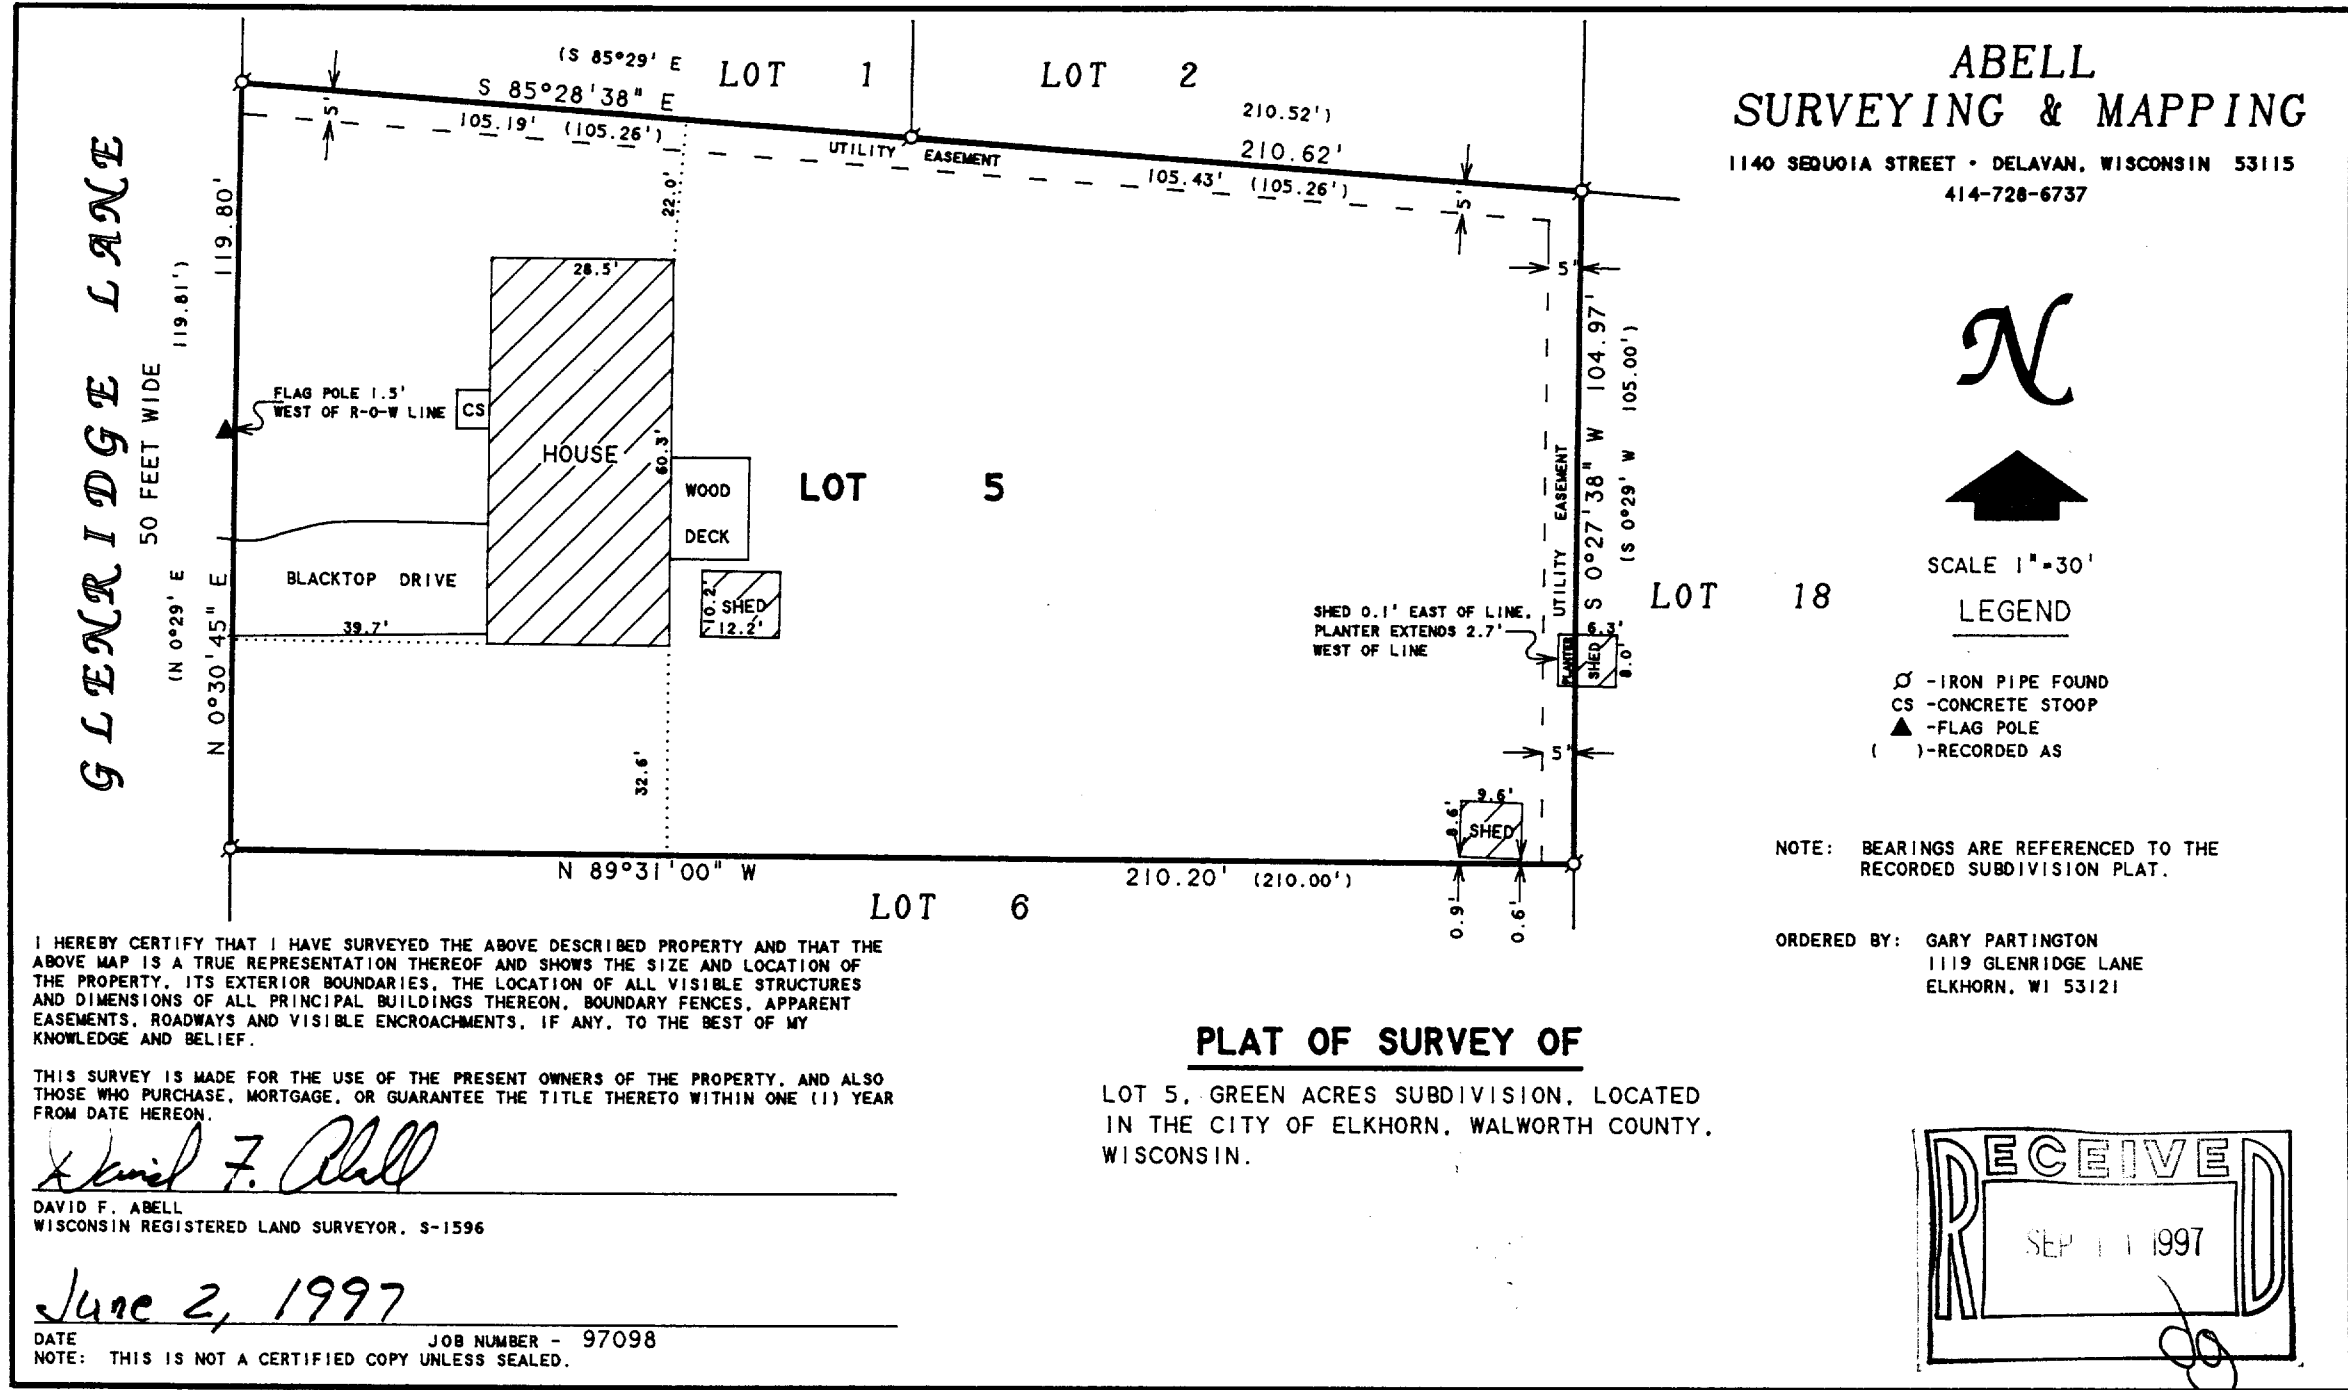

VGR-5
004-1060