


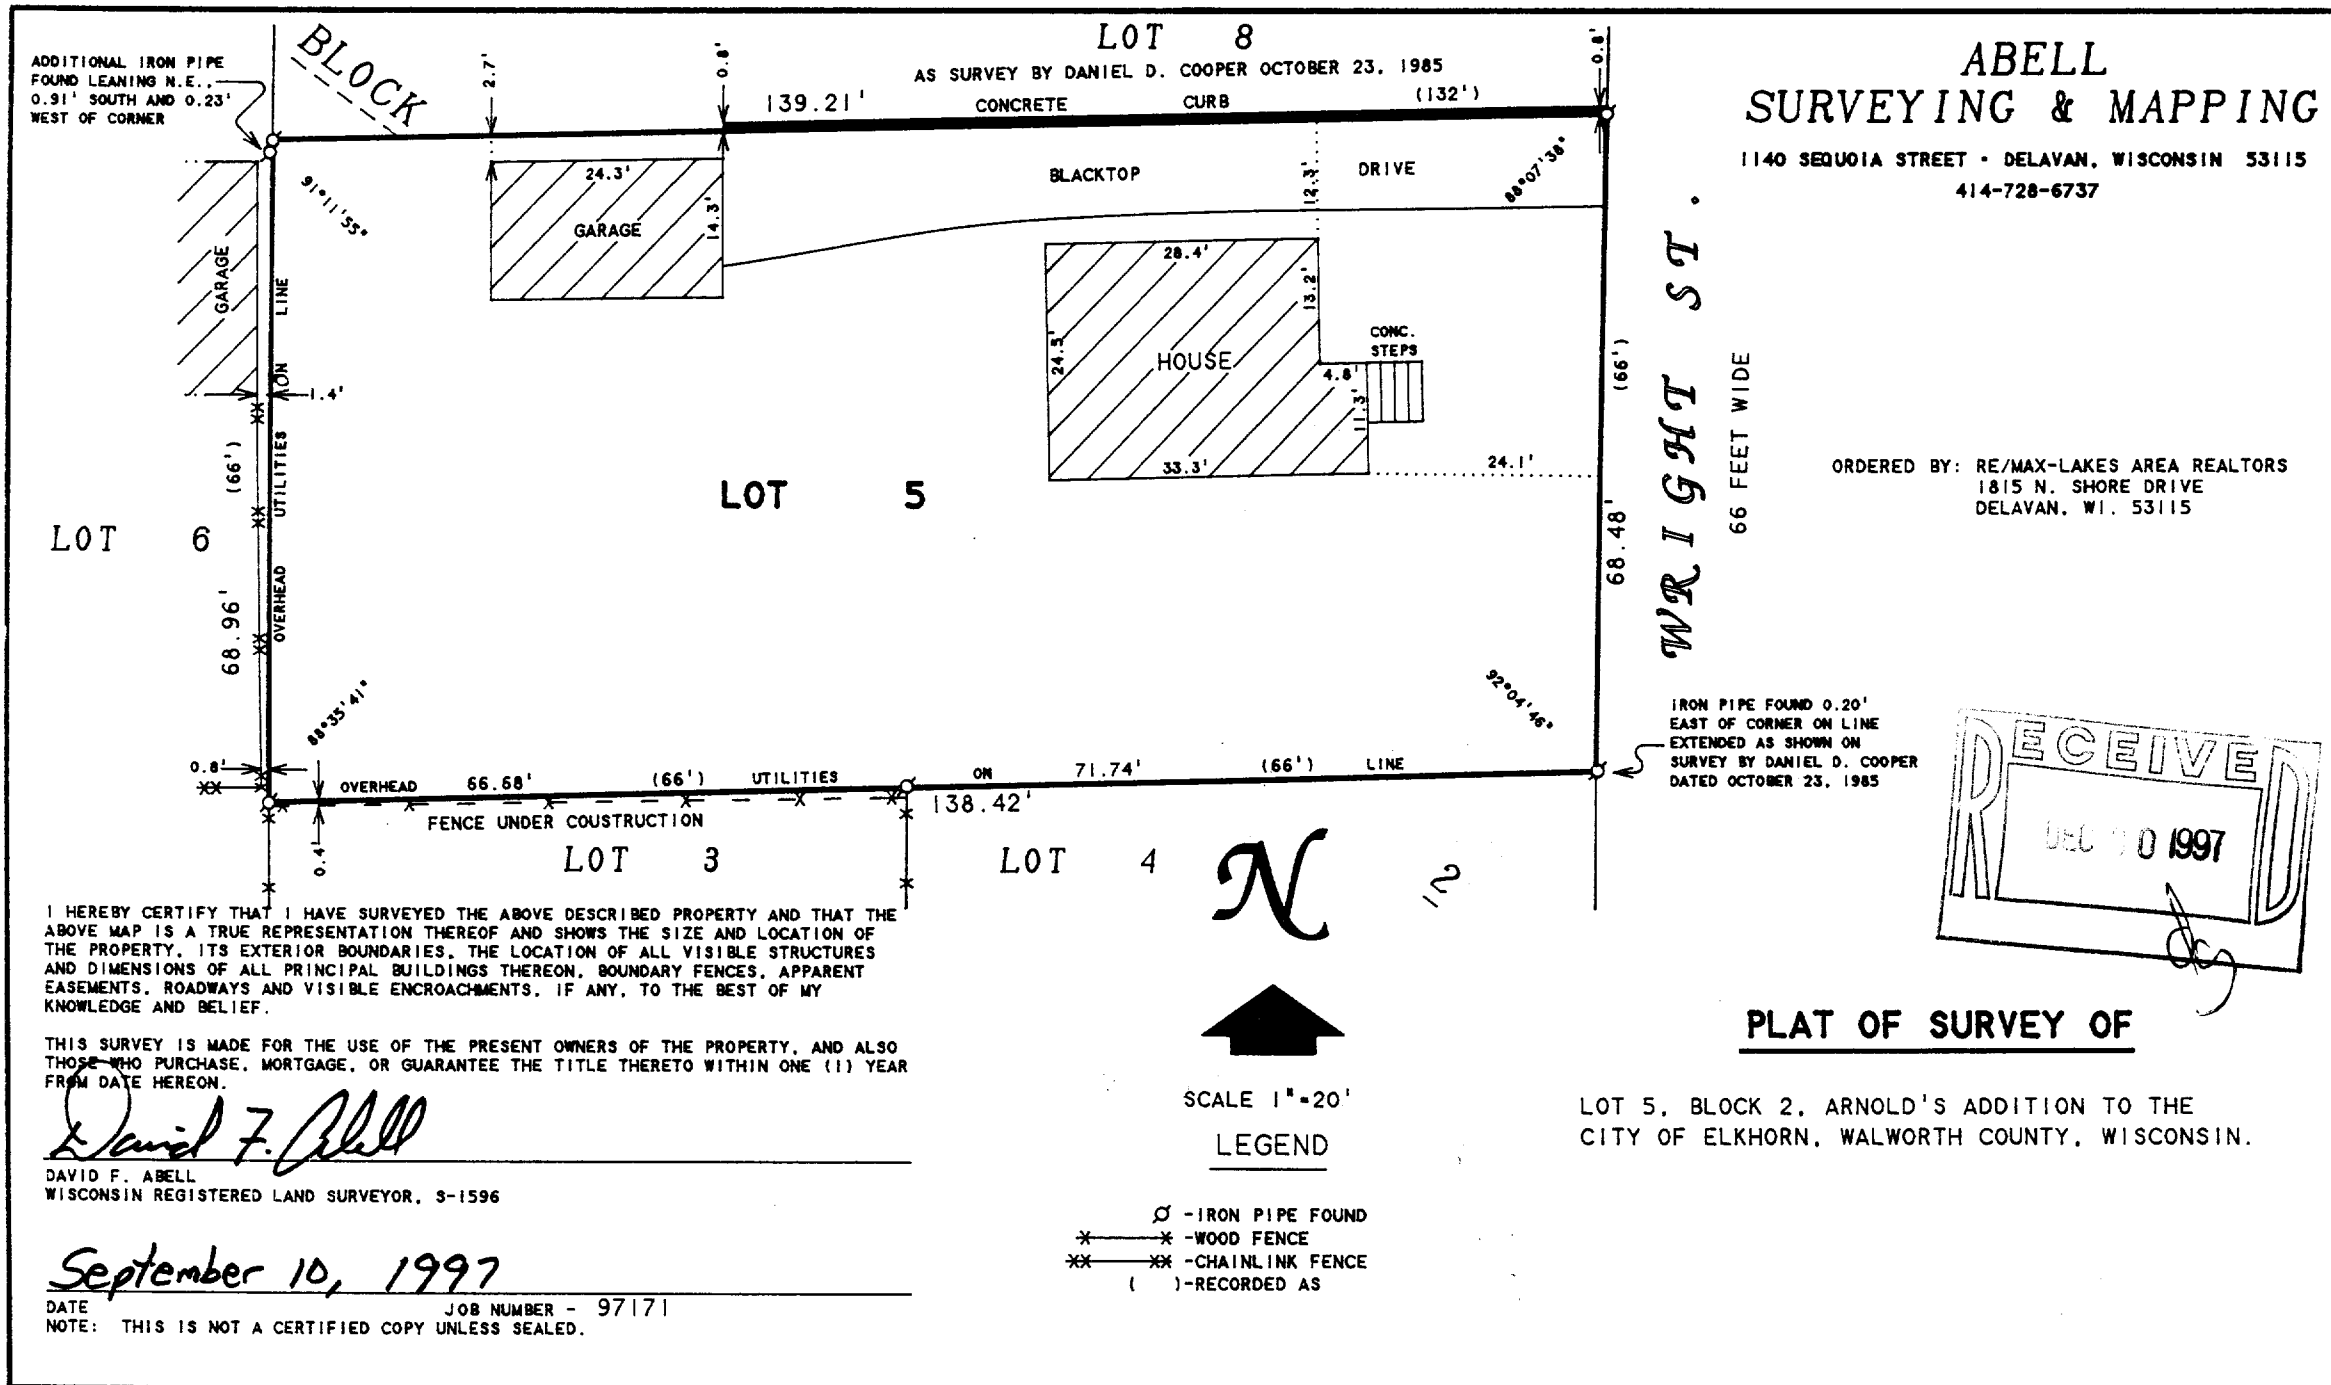

YAB-12
004-1077