



PLAT OF SURVEY
-OF-

THE SOUTH 50.10 FEET OF LOT 27 OF RENDON SUBDIVISION, LOCATED IN ALL QUARTERS OF THE SECTION 31, TOWNSHIP 3 NORTH, RANGE 17 EAST, IN THE CITY OF ELKHORN, WALWORTH COUNTY, WISCONSIN.



SURVEY FOR: SOUTHEAST WISCONSIN HOUSING CORP.

PATRICIA — STREET

66' WIDE

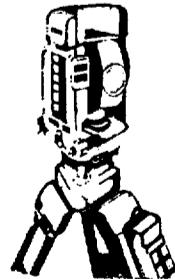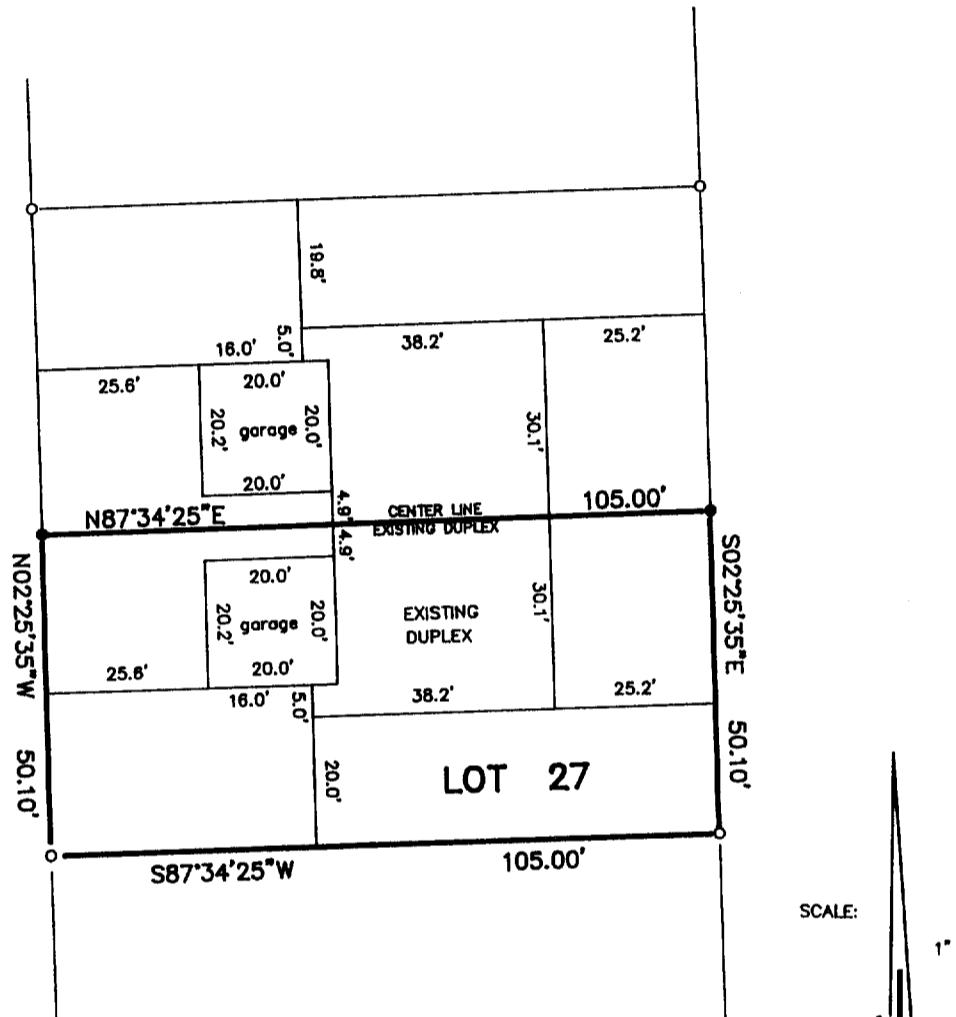

B.W. SURVEYING
Land Surveys
Mapping And Planning
425 Milwaukee Avenue
Burlington, WI 53105
(414) 767-0225

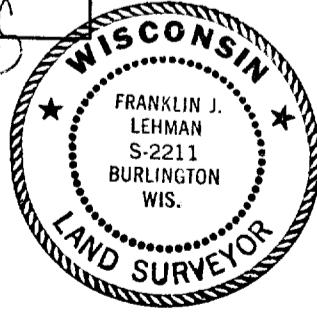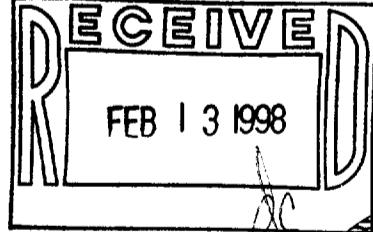

"I hereby certify that I have surveyed the above described property and that the above map is a true representation thereof and shows the size and location of the property, its exterior boundaries, the location of all visible structures and dimensions of all principal buildings thereon, boundary fences, apparent easements, roadways and encroachments, if any."

"This survey is made for the use of the present owners of the property, and those who purchase, mortgage, or guarantee the title thereto within one year from the date hereof."

THIS IS NOT AN ORIGINAL PRINT
UNLESS THIS SEAL IS RED

Franklin J. Lehman
FRANKLIN J. LEHMAN
REGISTERED LAND SURVEYOR - 2211

9-3-96

DATE
04/11/96

2685

JOB NUMBER

VRE-27A