

FARRIS, HANSEN & ASSOCIATES, INC.


ENGINEERING, ARCHITECTURE, SURVEYING
7 RIDGEWAY COURT – P.O. BOX 437, ELKHORN, WISCONSIN, 53121
PHONE: (414) 723-2098 FAX: (414) 723-5886

PLAT OF SURVEY

LOT 1 OF CERTIFIED SURVEY MAP NO. 1451
REC. IN VOL. 7 ON PG. 1 OF WALWORTH COUNTY CERTIFIED SURVEYS
DOC. NO. 122243, LOCATED IN THE CITY OF ELKHORN
WALWORTH COUNTY, WISCONSIN



WORK ORDERED BY: PETER VEN HOUSEN
W 5549 PLANTATION RD
ELKHORN, WI. 53121

LOT 4 CSM 2247

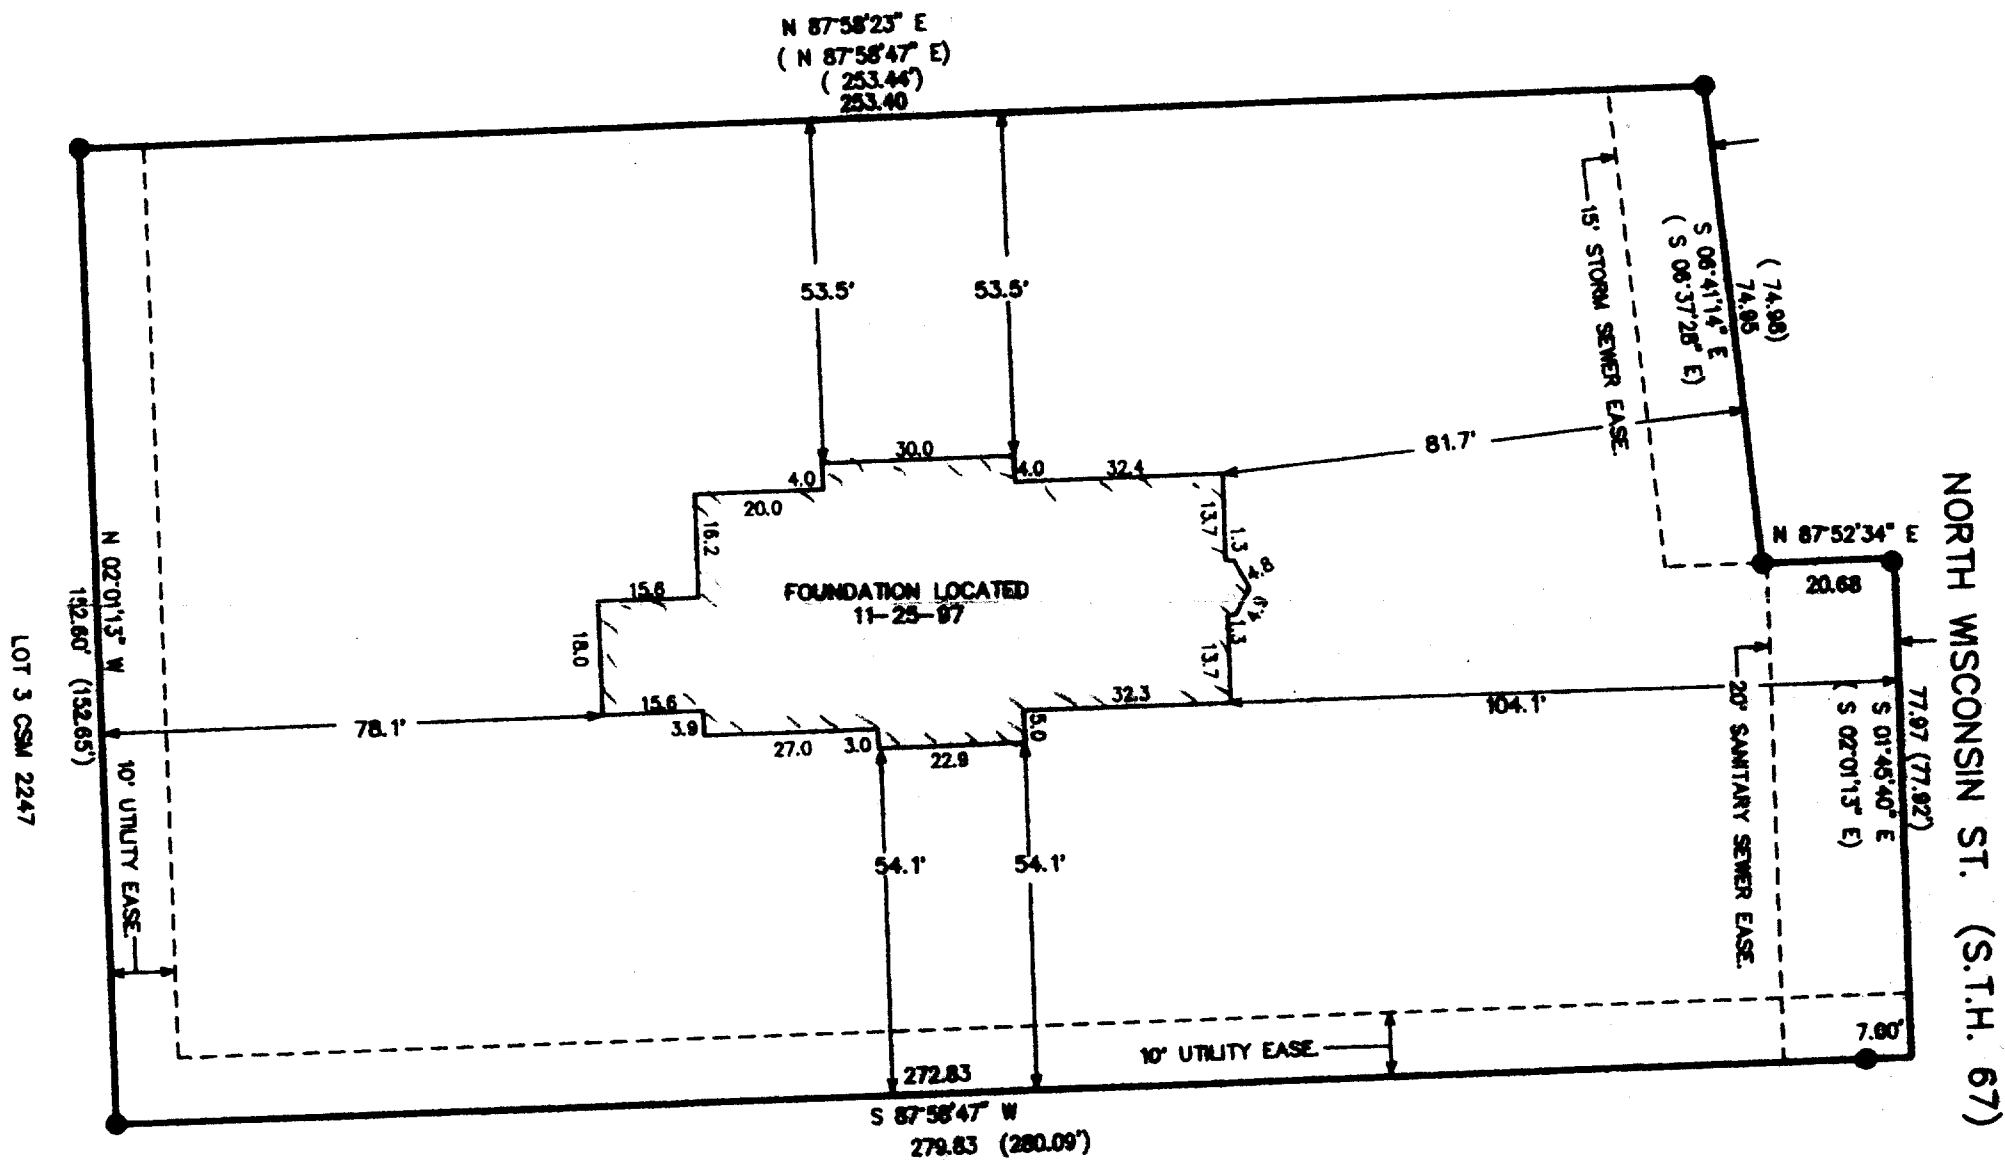

● = FOUND IRON REBAR STAKE
(XXX) = RECORDED AS

LOT 2 CSM 2247

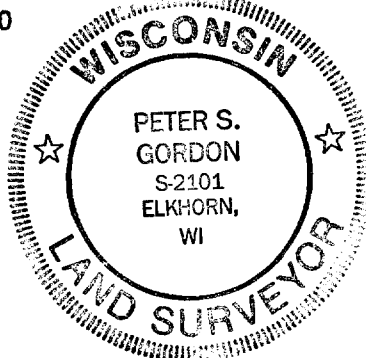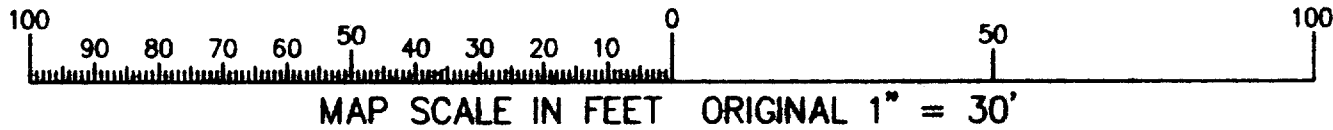


ASSIGNED SOUTH LINE CSM 1451

NOTE: COPIES OF THIS MAP TO WHICH THE FOLLOWING CERTIFICATE WILL APPLY ARE BLUE LINE PRINTS SHOWING SURVEYOR'S ORIGINAL SEAL AND SIGNATURE IN BLACK INK. COPIES BY ANY OTHER MEANS MAY HAVE ALTERATIONS WHICH DO NOT REPRESENT THE SURVEYOR'S WORK PRODUCT.

I HEREBY CERTIFY THAT THE ABOVE DESCRIBED PROPERTY HAS BEEN SURVEYED UNDER MY DIRECTION AND THAT THE ABOVE MAP IS A TRUE REPRESENTATION THEREOF AND SHOWS THE SIZE AND LOCATION OF THE PROPERTY AND ITS EXTERIOR BOUNDARIES. THIS SURVEY IS MADE FOR THE USE OF THE PRESENT OWNERS OF THE PROPERTY, AND ALSO THOSE WHO PURCHASE, MORTGAGE, OR GUARANTEE THE TITLE THERETO WITHIN ONE YEAR FROM THE DATE HEREOF.

DATED: 11-26-97


PETER S. GORDON R.L.S. 2101

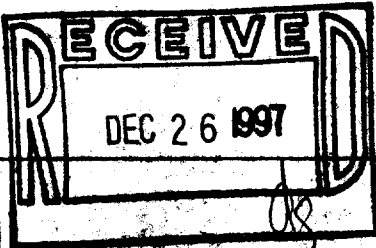

PROJECT 4741

SHEET 1 OF 1

VA-1451-T
004-1089