


PATHFINDER SURVEYING
FORMERLY KOLB LAND CONSULTING
929 WILLIAMS STREET LAKE GENEVA, WI. 53147
(414) 248-3697

DATE: 4 / 2 / 1998

DESCRIPTION: LOT 42 OF JACKSON CREEK SUBDIVISION LOCATED IN THE SW 1/4 OF SECTION 7 , T.2.N. , R. 17. E. CITY OF ELKHORN , WALWORTH COUNTY , WISCONSIN.

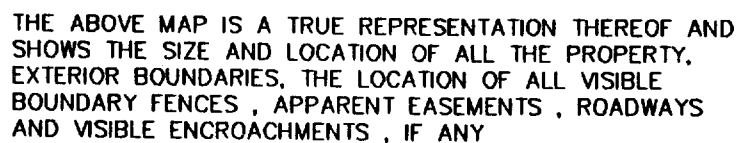


THIS SURVEY IS MADE FOR THE USE OF THE PRESENT OWNERS OF THE PROPERTY , AND ALSO THOSE WHO PURCHASE , MORTGAGE OR GURANTEE TITLE THERETO WITHIN ONE (1) YEAR FROM DATE HERETO.

John P. Krott
JOHN P. KROTT, R.L.S. 2258

LEGEND

- FOUND 5/8" DIA. REBAR
 SET 2" DIA. IRON PIPE
 (XXXX) RECORDED AS

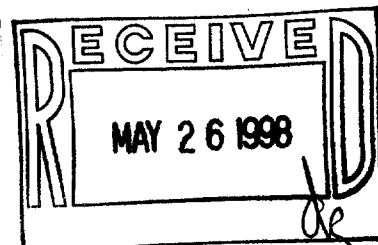

NOTE: THIS IS NOT A CERTIFIED COPY
UNLESS SEAL IS IN RED.

JOB NUMBER: 98051 ELK YJC42

YJC-42
004-1095