


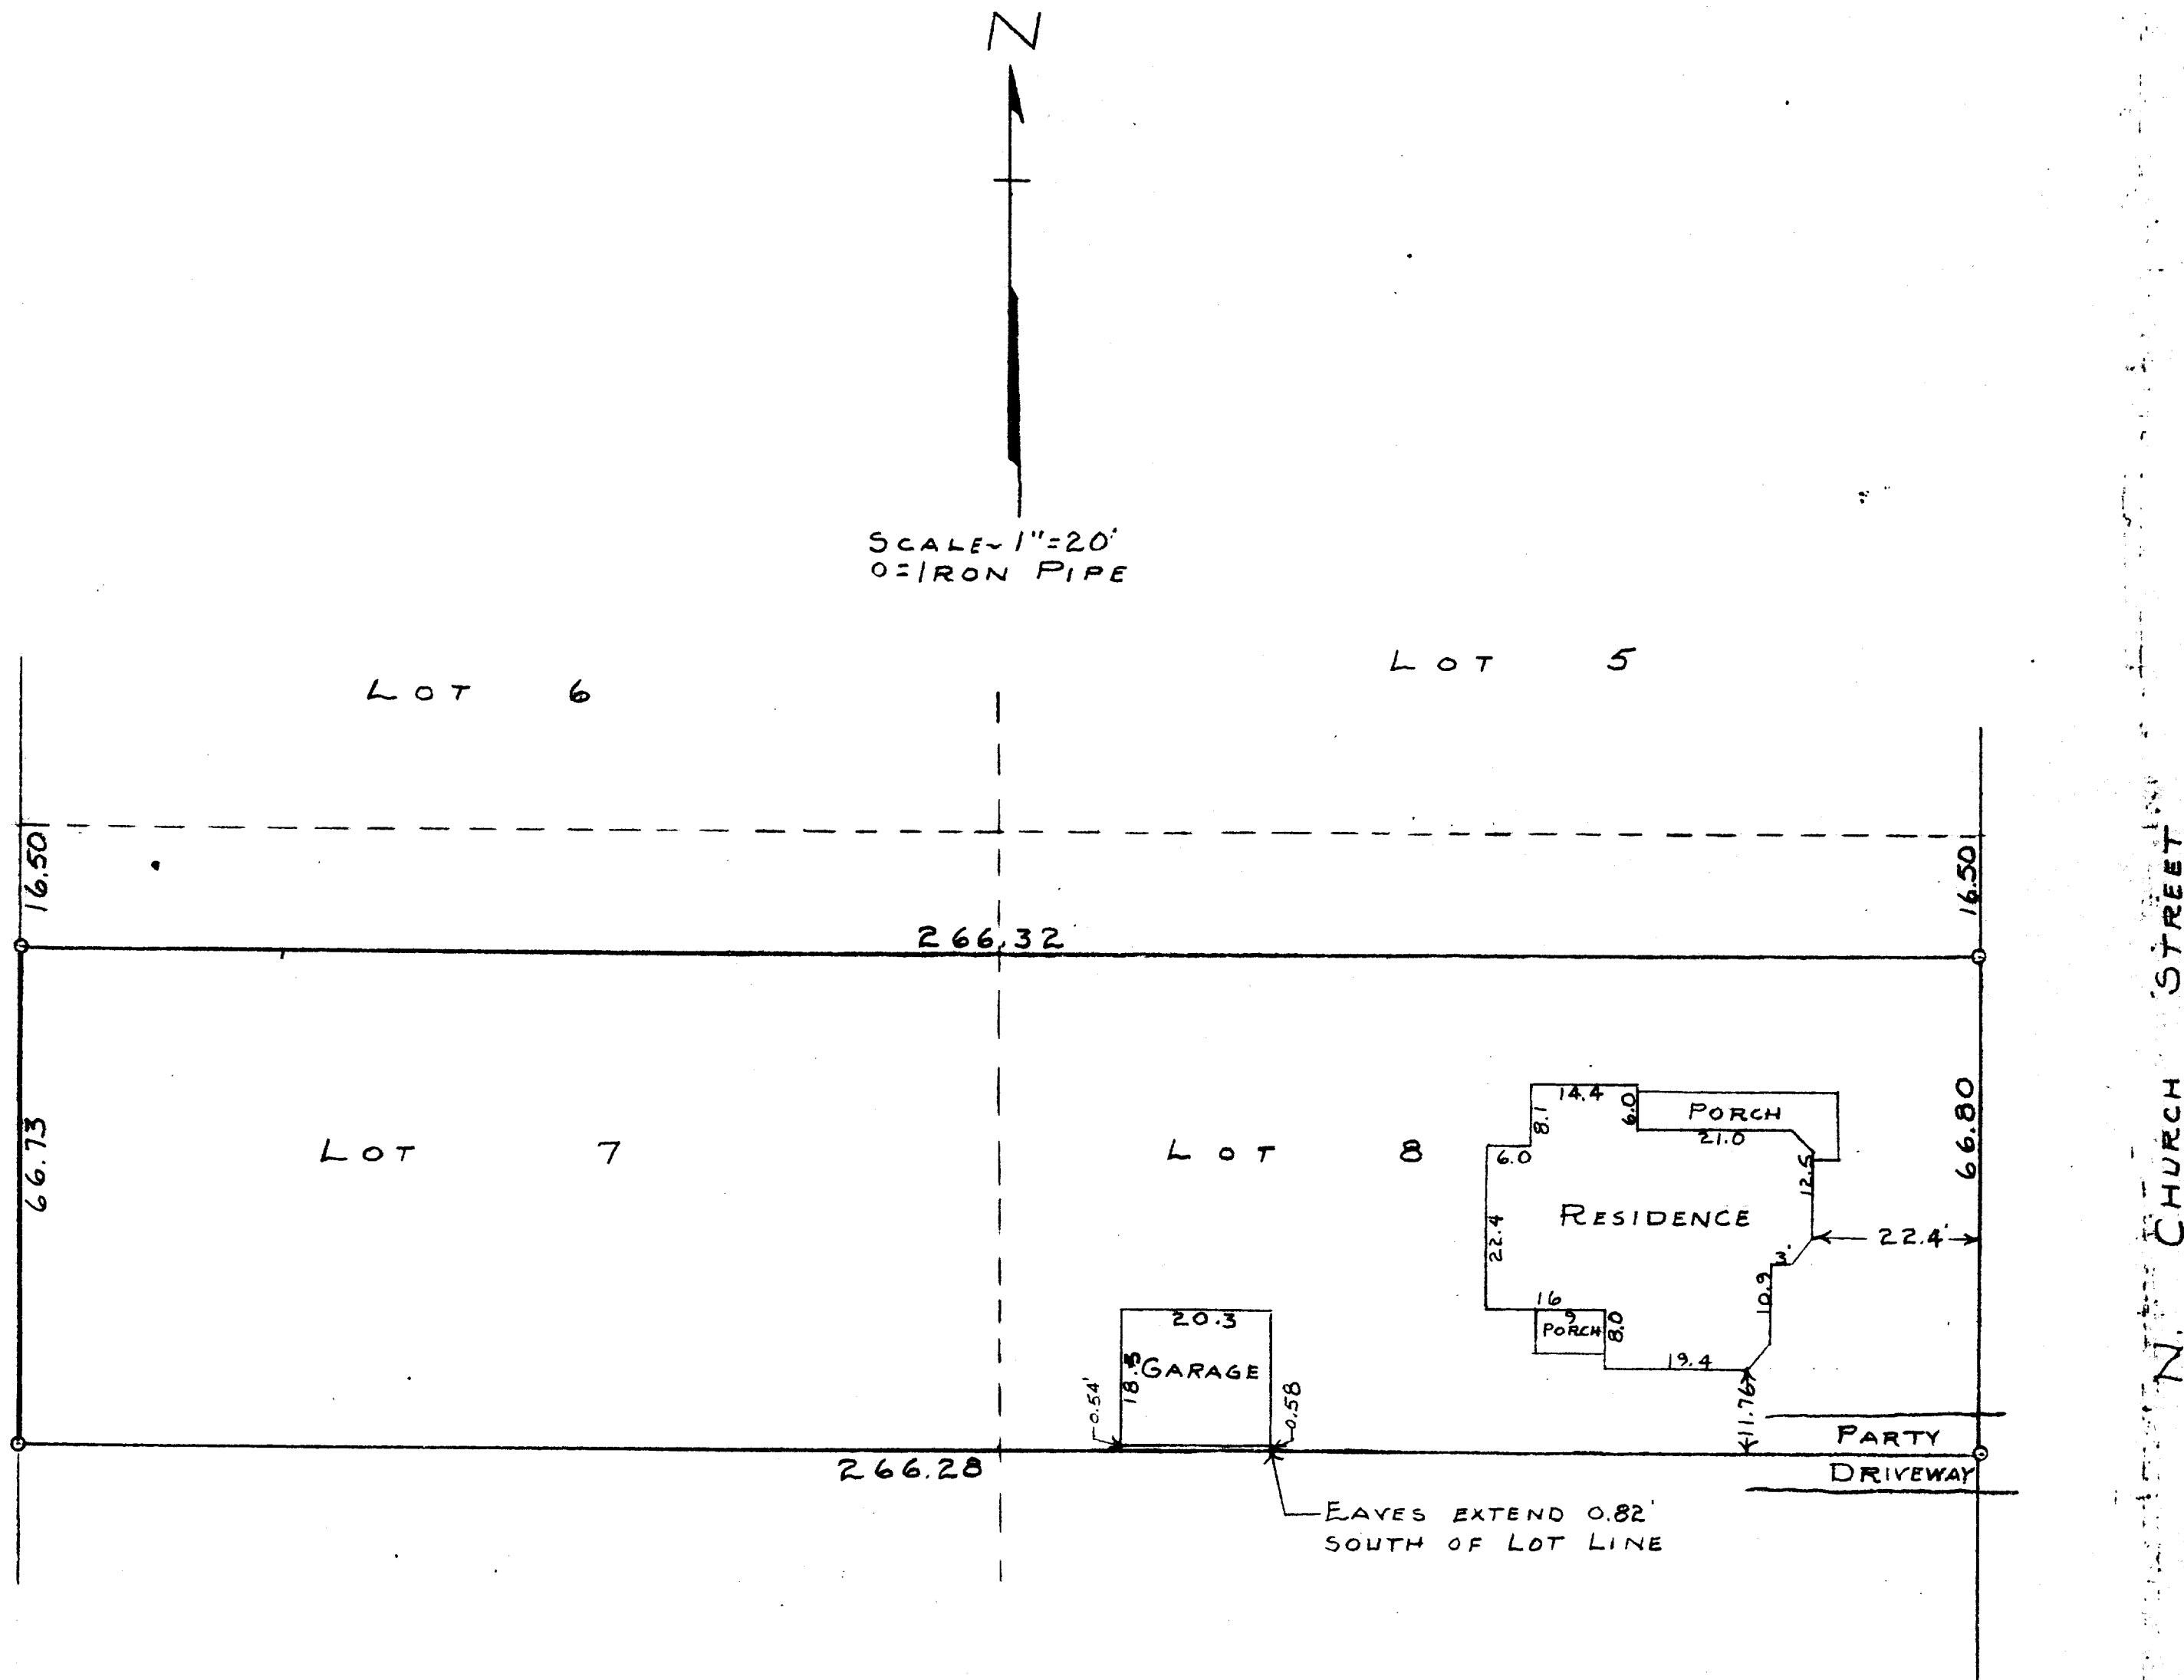

STATE OF WISCONSIN)ss
WALWORTH COUNTY)

I, GEORGE T. DUNHAM, DO HEREBY CERTIFY THAT I HAVE
SURVEYED THE PROPERTY DESCRIBED AS FOLLOWS:

LOTS 7 AND 8 EXCEPT THE NORTH 1 ROD THEREOF IN BLOCK
18 OF THE ORIGINAL PLAT OF THE CITY OF ELKHORN, WALWORTH
COUNTY, WISCONSIN.

AND THAT THE PLAT SHOWN ABOVE IS A CORRECT REPRESENTATION OF
THE PROPERTY AND OF THE IMPROVEMENTS LOCATED THEREON.

JAN. 31, 1958

George T. Dunham
GEORGE T. DUNHAM, SURVEYOR
DELAVER, WISCONSIN

4-11