


FARRIS, HANSEN & ASSOCIATES, INC.
7 RIDGWAY COURT - P.O. BOX 437, ELKHORN, WISCONSIN, 53121
ENGINEERING, ARCHITECTURE, SURVEYING
PHONE: (414) 723-2098 FAX: (414) 723-5886

PLAT OF SURVEY

LOTS 5 and 6 and THE NORTH 15 FEET OF LOT 4, OAKLAND SUBDIVISION
LOCATED IN THE SOUTHEAST 1/4 OF THE SOUTHWEST 1/4 OF
SECTION 36, TOWN 3 NORTH, RANGE 16 EAST,
CITY OF ELKHORN, WALWORTH COUNTY, WISCONSIN

- WORK ORDERED BY -
DONNA BAKER
COLDWELL BANKER
BEARDSLEY & ASSOCIATES
102 NORTH WISCONSIN STREET
ELKHORN, WISCONSIN 53121

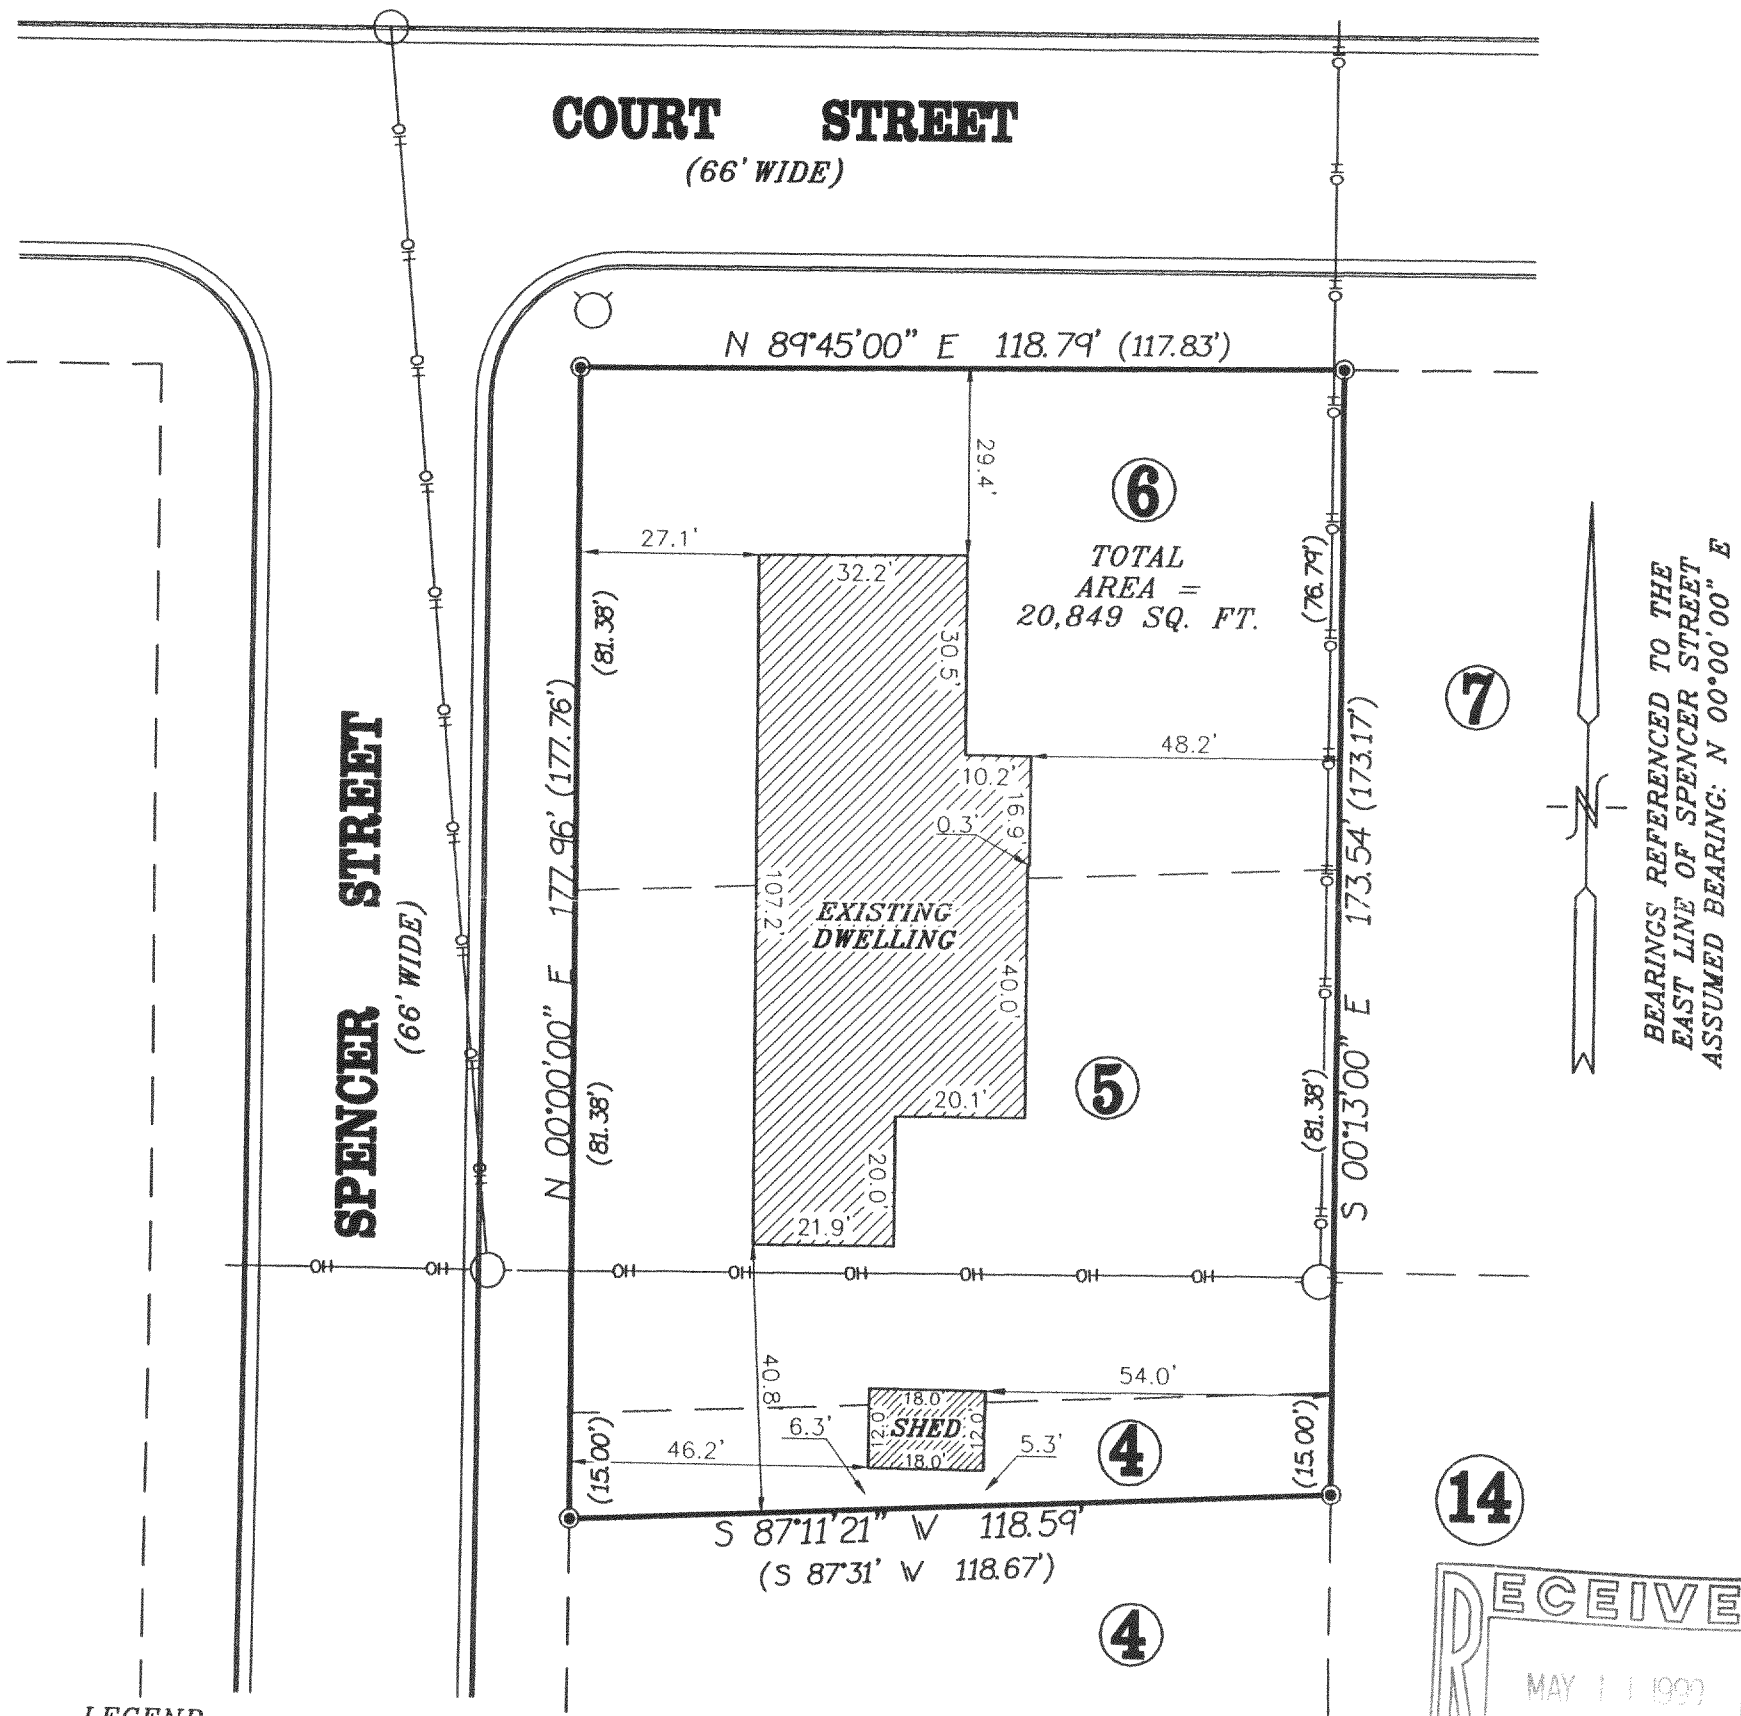


NOTE: COPIES OF THIS MAP TO WHICH THE FOLLOWING CERTIFICATE WILL APPLY SHOW SURVEYOR'S ORIGINAL SEAL AND SIGNATURE IN BLACK INK. COPIES BY ANY OTHER MEANS MAY HAVE ALTERATIONS WHICH DO NOT REPRESENT THE SURVEYOR'S WORK PRODUCT.

I HEREBY CERTIFY THAT THE ABOVE DESCRIBED PROPERTY HAS BEEN SURVEYED UNDER MY DIRECTION AND THAT THE ABOVE MAP IS A TRUE REPRESENTATION THEREOF AND SHOWS THE SIZE AND LOCATION OF THE PROPERTY AND ITS EXTERIOR BOUNDARIES. THIS SURVEY IS MADE FOR THE USE OF THE PRESENT OWNERS OF THE PROPERTY, AND ALSO THOSE WHO PURCHASE, MORTGAGE, OR GUARANTEE THE TITLE THERETO WITHIN ONE YEAR FROM THE DATE HEREOF.

DATED: JANUARY 26, 1999

RANDAL J. MATHWICK RLS 2411

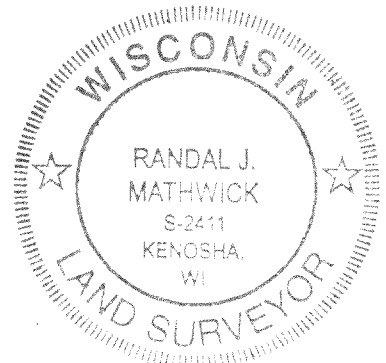

PROJECT 5202
DATE: 1/26/1999
SHEET 1 OF 1

10-5

004-1151