


Survey For: JOHN SPRAGIA
Location: Sandy Lane

Description: LOT 4 in BLOCK 5 in FAIRLANE SUBDIVISION ADDITION NO. 1 being a subdivision of a part of the S.W. 1/4 of the N.W. 1/4 of Section 31, T. 3 N., R. 17 E., in the City of Elkhorn, Walworth County, Wisconsin.

Pin 1019.15
F/L - 1011.70

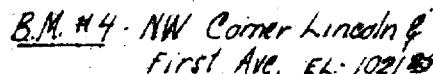

Scale: 1" = 30'



**INMAN ENGINEERING
OF
MILWAUKEE, INC.
ENGINEERS - SURVEYORS**

SURVEY CERTIFICATE

State of Wisconsin) ss I certify that I have surveyed the above described (property) and the above map is a true
Milwaukee County representation thereof and shows the size and location of the Property, its exterior boundaries, the location and
dimensions of all visible structures thereon, fences, apparent easements and roadways and visible encroach-
ments, if any.

This survey is made for the exclusive use of the present owners of the Property, and also those who purchase, mortgage, or guarantee the title thereto within one (1) year from date hereof, and as to them I warrant the accuracy of said survey and map.

Rec 7/6/77

DATE: 6/26/74
JOB NO.: 8806

THOMAS INMAN, Registered Land Surveyor

VFLA-22

4-119