


084-1194
YOP-140A

Copyright © 1999 by Jensen & Olson Land Surveying, LLC
All rights reserved. No part of this survey plat may be reproduced or transmitted in any form by any means - graphic, electronic, or mechanical, including photocopying, tracing, or information storage and retrieval systems - without permission in writing from Douglas G. Olson, Jensen & Olson Land Surveying, LLC.

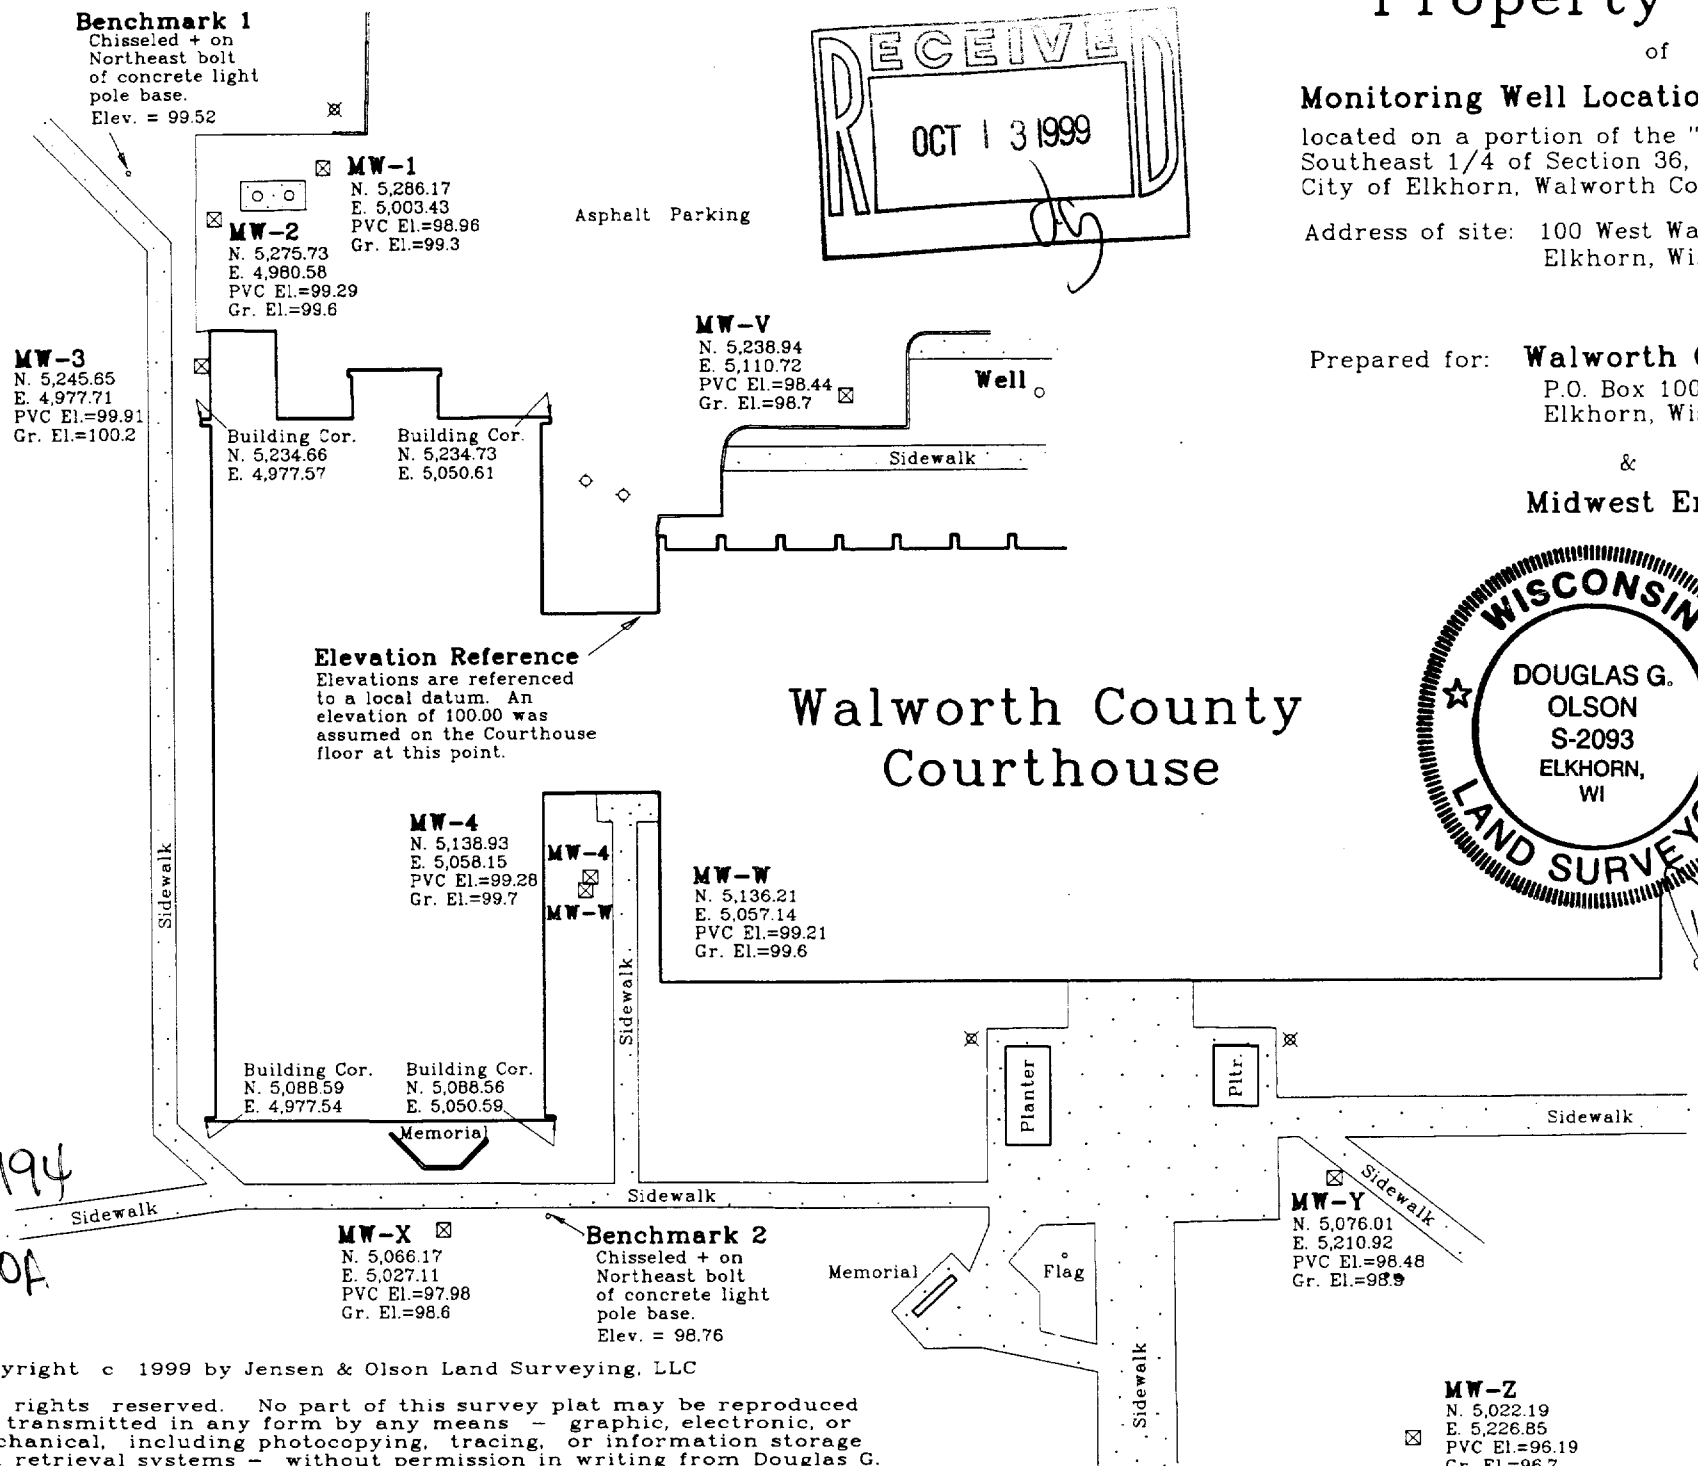


Property Exhibit
of
Monitoring Well Locations and Elevations,
located on a portion of the "Courthouse Square" in the Southeast 1/4 of Section 36, Town 3 North, Range 16 East City of Elkhorn, Walworth County, Wisconsin.
Address of site: 100 West Walworth Street
Elkhorn, Wisconsin. 53121

Prepared for: **Walworth County**
P.O. Box 1001
Elkhorn, Wisconsin. 53121
&
Midwest Enviro-Sciences, Inc.



Bearings are assumed.
Coordinates are referenced to a local datum.

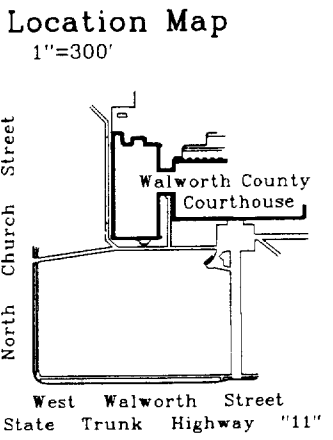

Jensen & Olson Land Surveying, LLC
45 South Wisconsin Street P.O. Box 322
Elkhorn, Wisconsin. 53121
Telephone: (414) 723-3434
Facsimile: (414) 723-8044
Mapping Date: Sept. 11, 1999.
Revisions:
Sheet 1 of 1 Sheets
Job Reference No. **1999.085**

