


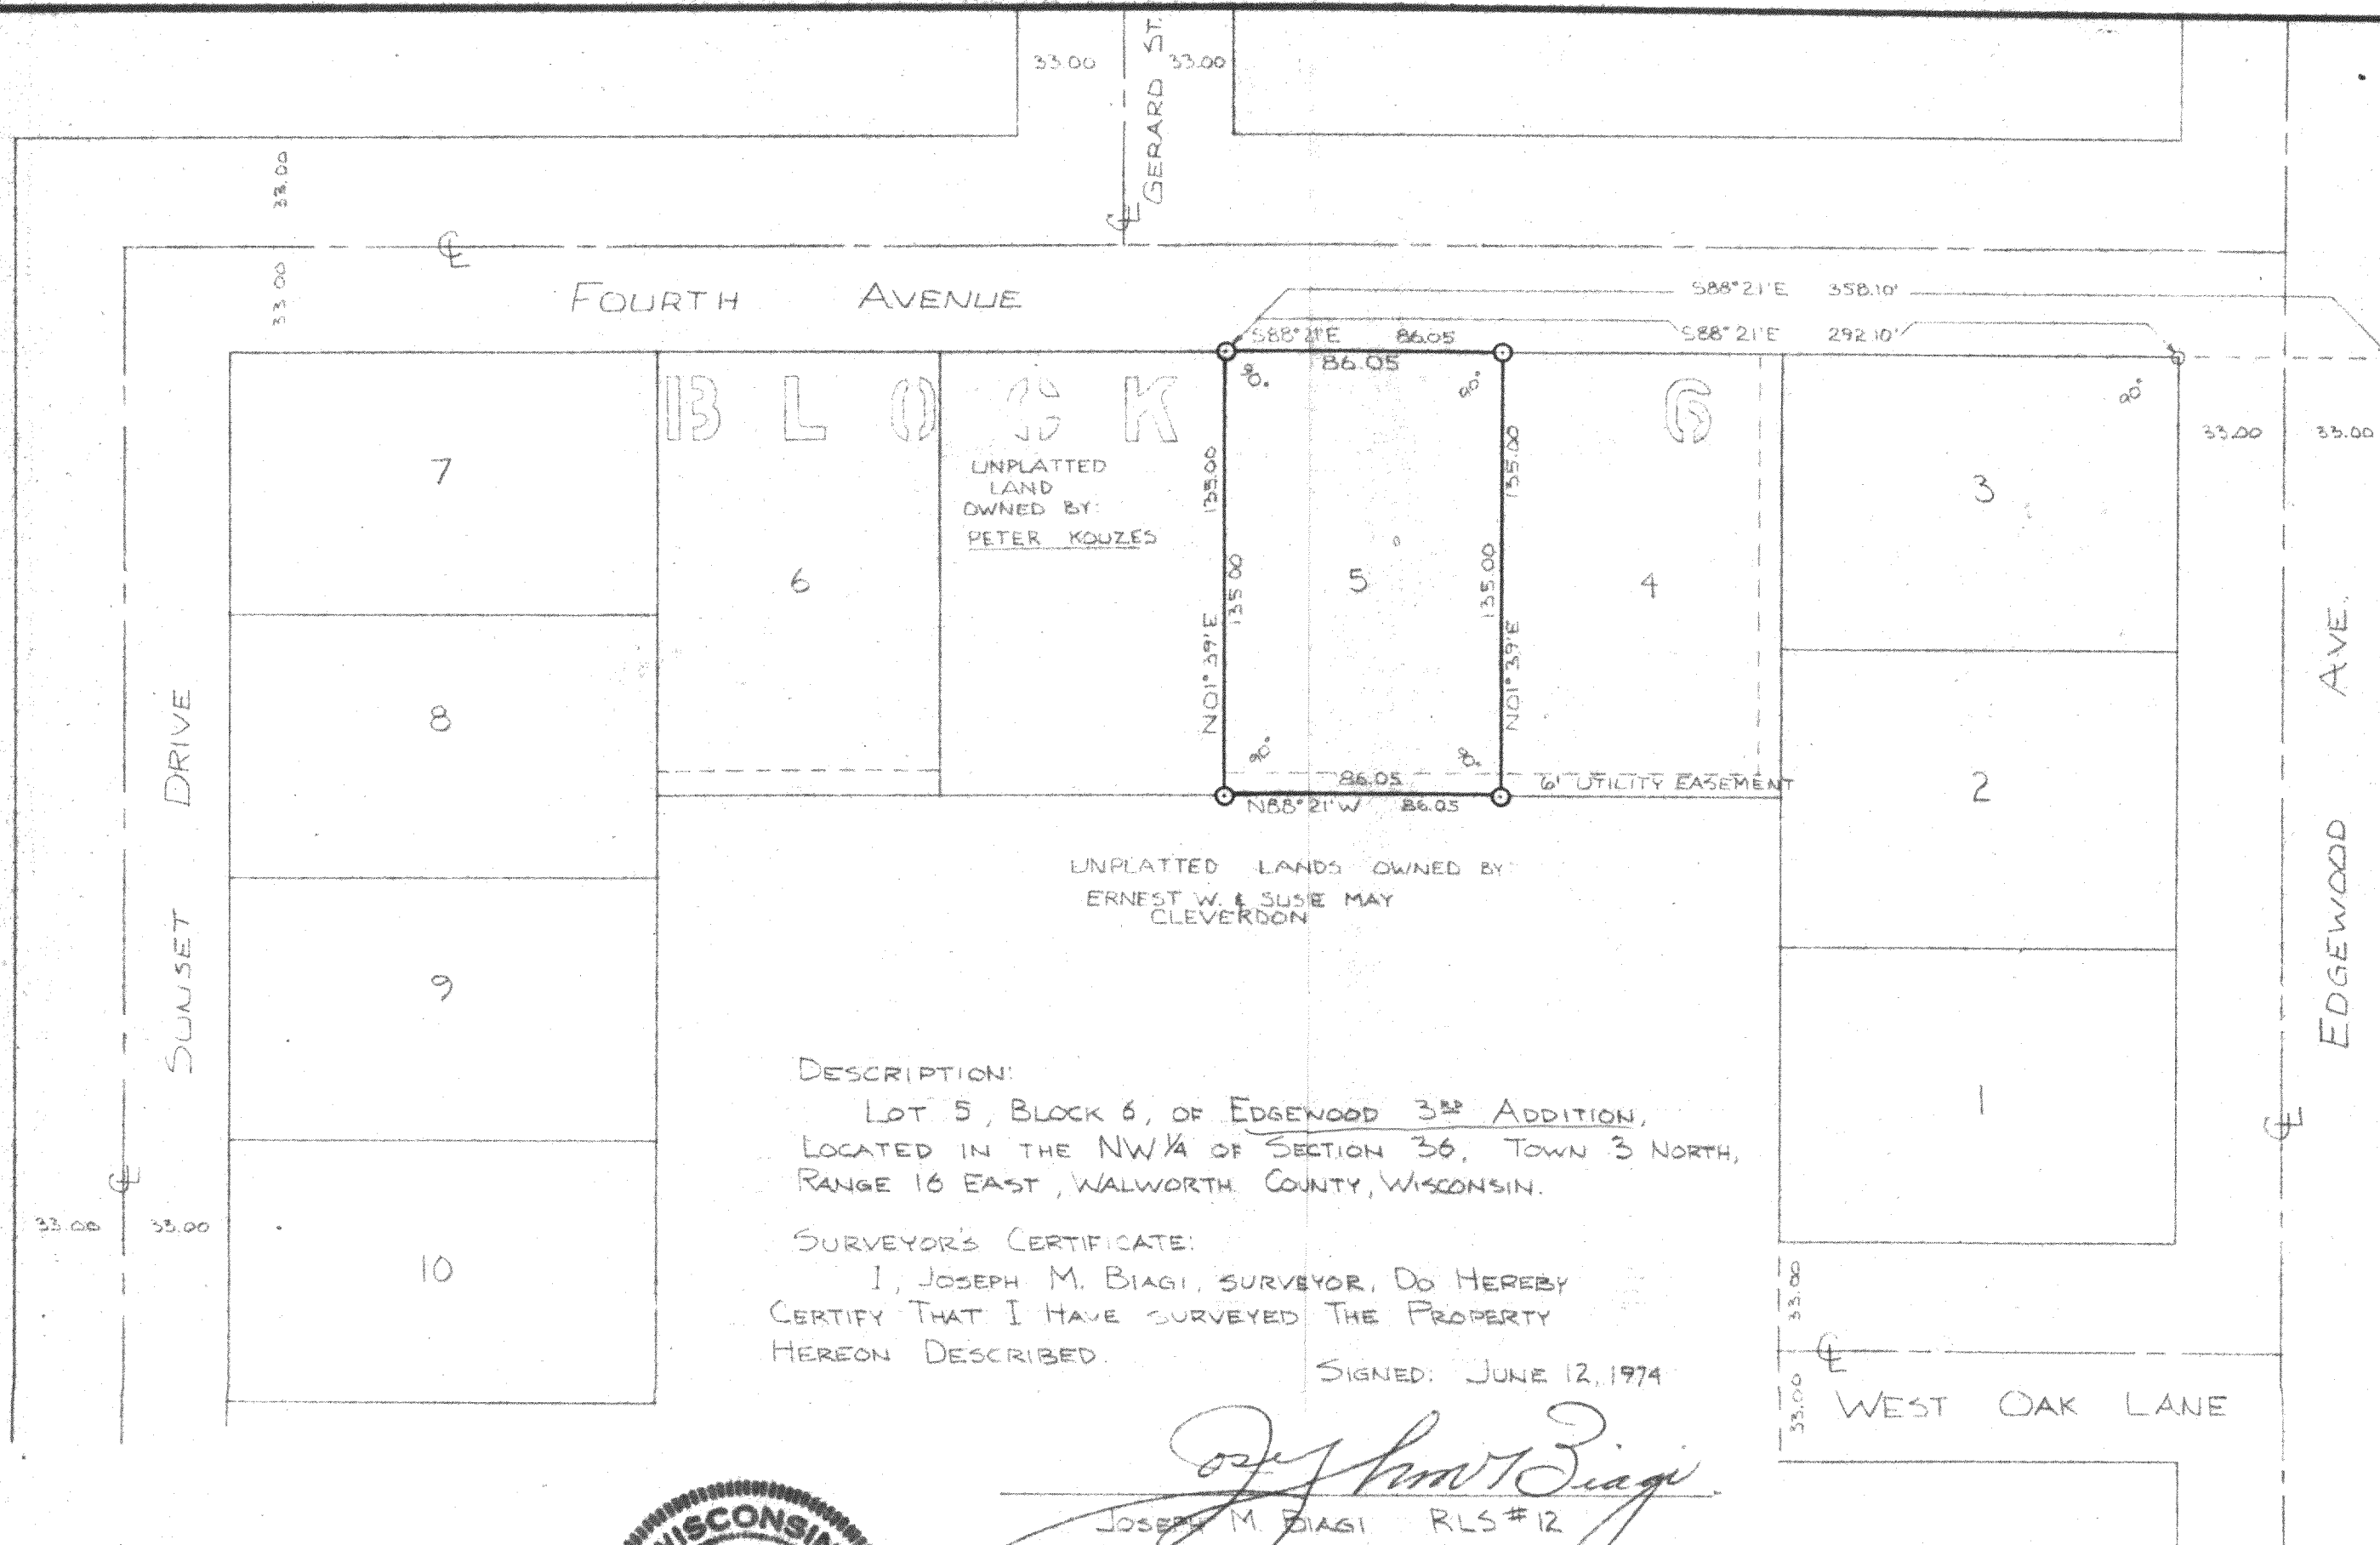

DESCRIPTION:


LOT 5, BLOCK 6, OF EDGEWOOD 3RD ADDITION,
 LOCATED IN THE NW 1/4 OF SECTION 36, TOWN 3 NORTH,
 RANGE 16 EAST, WALWORTH COUNTY, WISCONSIN.

SURVEYOR'S CERTIFICATE:

I, JOSEPH M. BIAGI, SURVEYOR, DO HEREBY
 CERTIFY THAT I HAVE SURVEYED THE PROPERTY
 HEREON DESCRIBED.

SIGNED: JUNE 12, 1974

Joseph M. Biagi
 JOSEPH M. BIAGI RLS #12
 ELKHORN, WISC.

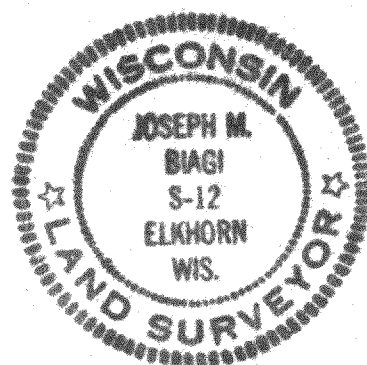

LEGEND

○ - IRON PIPE

SCALE:
 ONE INCH = 50.0'

REVISIONS					
NO.	DATE	BY			
1			LOT 5 BLOCK 6 EDGEWOOD 3 RD ADD. DRAWN BY <i>JPR</i> SCALE 1" = 50' DATE 6-12-74 TRACED APP'D MATERIAL DRAWING NO. 69-74		
2					
3					
4					
5					

VEA3-8

69-74