
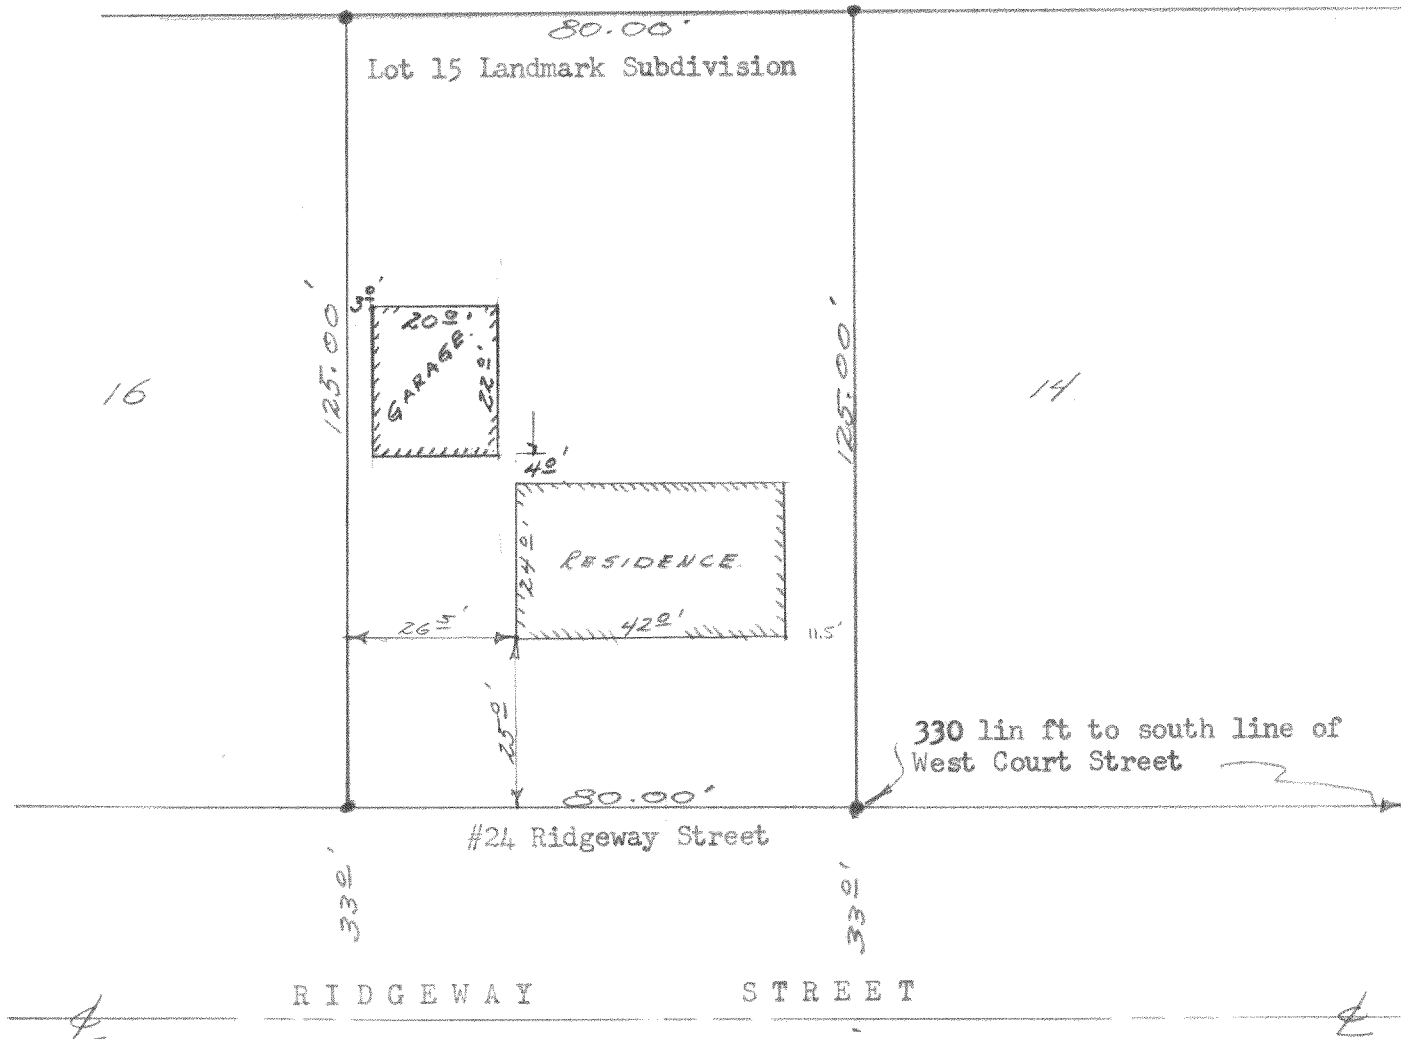


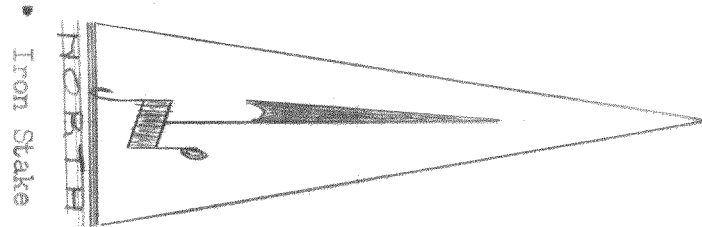


DESCRIPTION:

Lot 15 Land mark Subdivision of the City of Elkhorn, Walworth County, Wisconsin.

CERTIFICATE:

I, hereby certify that I have surveyed the above mentioned property and that the above plat is an accurate survey and a true representation thereof and correctly shows the exterior boundary lines and location of buildings and other improvements on said property and the correct measurements thereof.

Date: August 21st 1965.

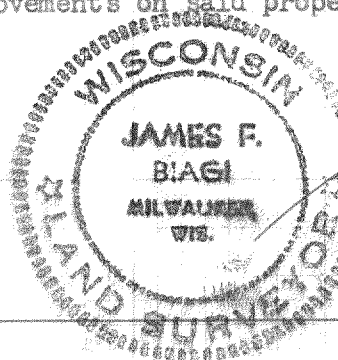

James F. Biagi, RLS 272
Elkhorn, Wisconsin.