



LOT 8, HARVEST POINTE, being a part of Lot 4 of Certified Survey Map No. 2083, and a part of the Northeast $\frac{1}{4}$, Northwest $\frac{1}{4}$, Southeast $\frac{1}{4}$ and the Southwest $\frac{1}{4}$ of the Southwest $\frac{1}{4}$ of Section 30, Town 3 North, Range 17 East, City of Elkhorn, Walworth County, Wisconsin.

Surveyed for: Bielinski Brothers Builders

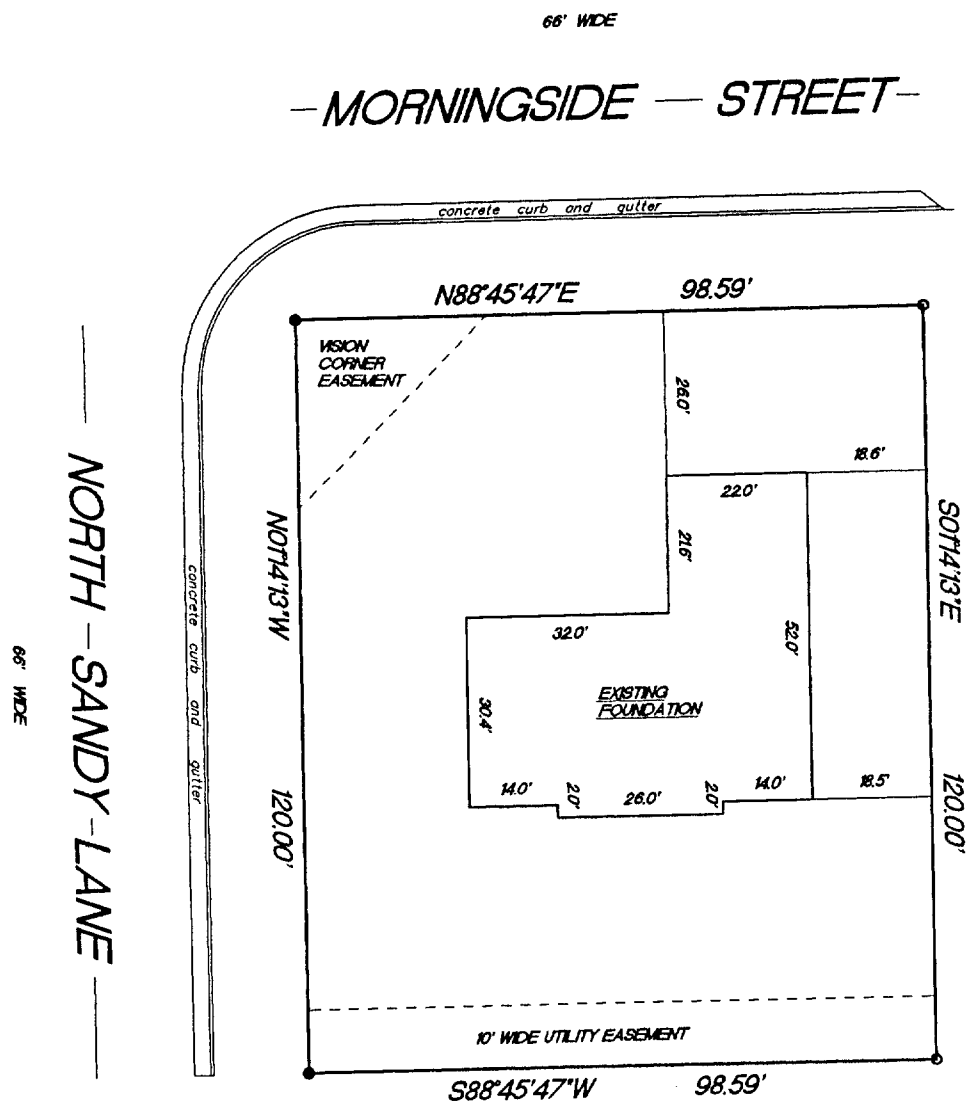

- FOUND 2" IRON PIPE
- FOUND 1" IRON PIPE

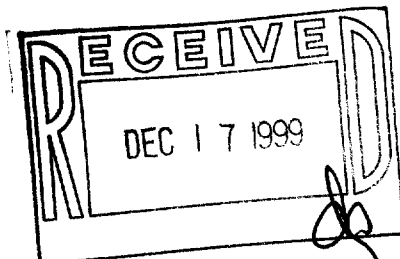

SCALE 1"-30'

"This survey is made for the use of the present owners of the property, and also those who purchase, mortgage or guarantee the title thereto within one year from date hereof."

Terrance E. Pisarek R.L.S.

THIS IS NOT AN ORIGINAL SURVEY UNLESS THE SEAL IS RED.

REV. 12/10/99
10/26/99

DATE _____

TEP/DW
FIELD WORK BY

TEP

DRAWN BY

99259
JOB NUMBER

YHP-8

004-1216