
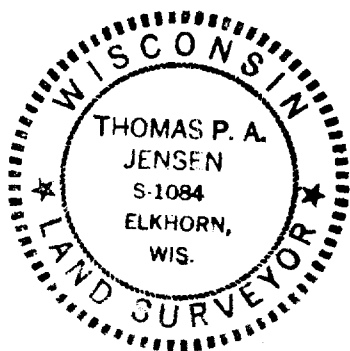


PLAT OF SURVEY

OF

LOT 6, BLOCK 2, TREE TOWNS SUBDIVISION,
LOCATED IN THE N.W. 1/4 OF THE NW 1/4 OF SECTION
31, T3N R17E, CITY OF ELKHORN, WALWORTH
COUNTY, WISCONSIN.

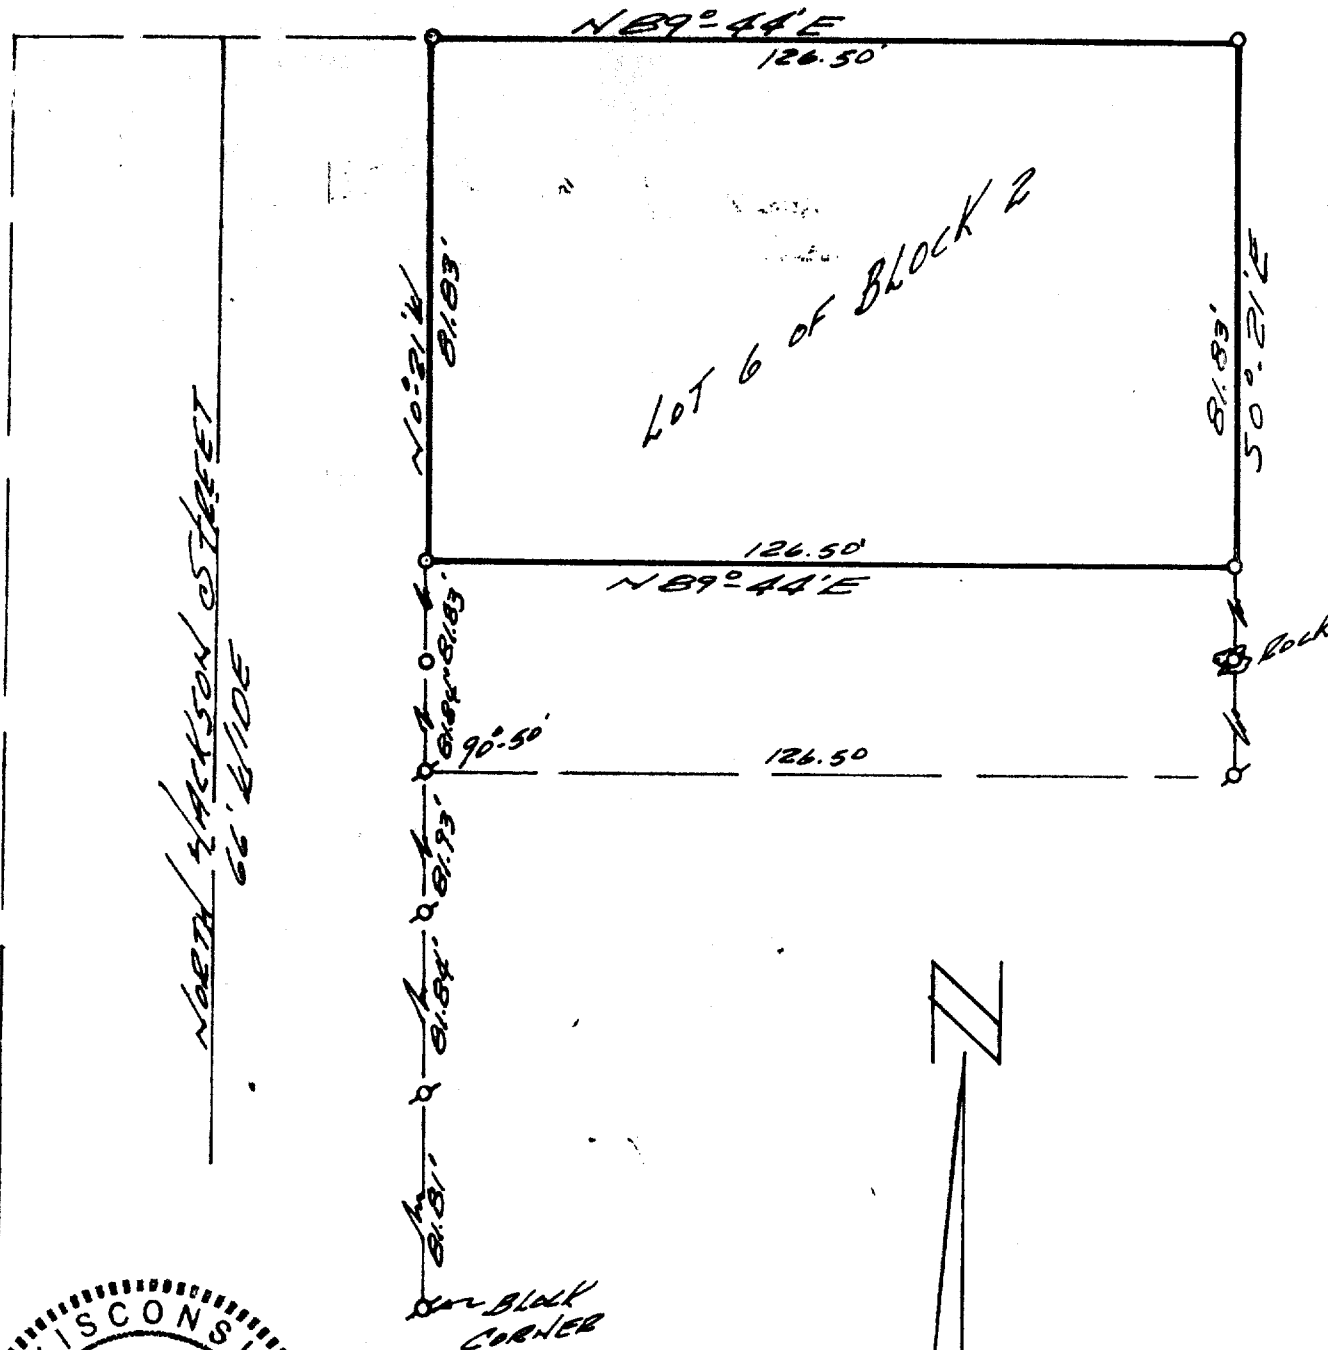

LEGEND

- — Iron Pipe SET
- — Concrete Monument

Scale 1" = 30'

○ — IRON PIPE FOUND

SURVEY AND PLAT BY

JENSEN & JOHNSON, INC.

CIVIL ENGINEERS AND SURVEYORS

Elkhorn, Wisconsin

WE CERTIFY: That we have surveyed the above described property and that the plat shown hereon is an accurate survey and a true representation thereof and correctly shows the exterior boundary lines and all divisions of said property.

Date 4/25/1974 Thomas P. A. Jensen

YTT5-18

4-1225 Wisconsin Registered Land Surveyor, No. S-1084