


PLAT OF SURVEY

LOT 48, HARVEST POINTE, being a part of Lot 4 of Certified Survey Map No. 2083, and a part of the Northeast 1/4, Northwest 1/4, Southeast 1/4 and the Southwest 1/4 of the Southwest 1/4 of Section 30, Town 3 North, Range 17 East, City of Elkhorn, Walworth County, Wisconsin.


Surveyed for: Bielinski Brothers Builders/Dotty Kern

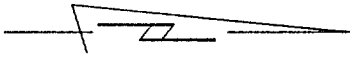

SCALE 1"=30'

FRONT MONUMENTATION HAS NOT YET BEEN SET BY DEVELOPER

o FOUND 1" IRON PIPE

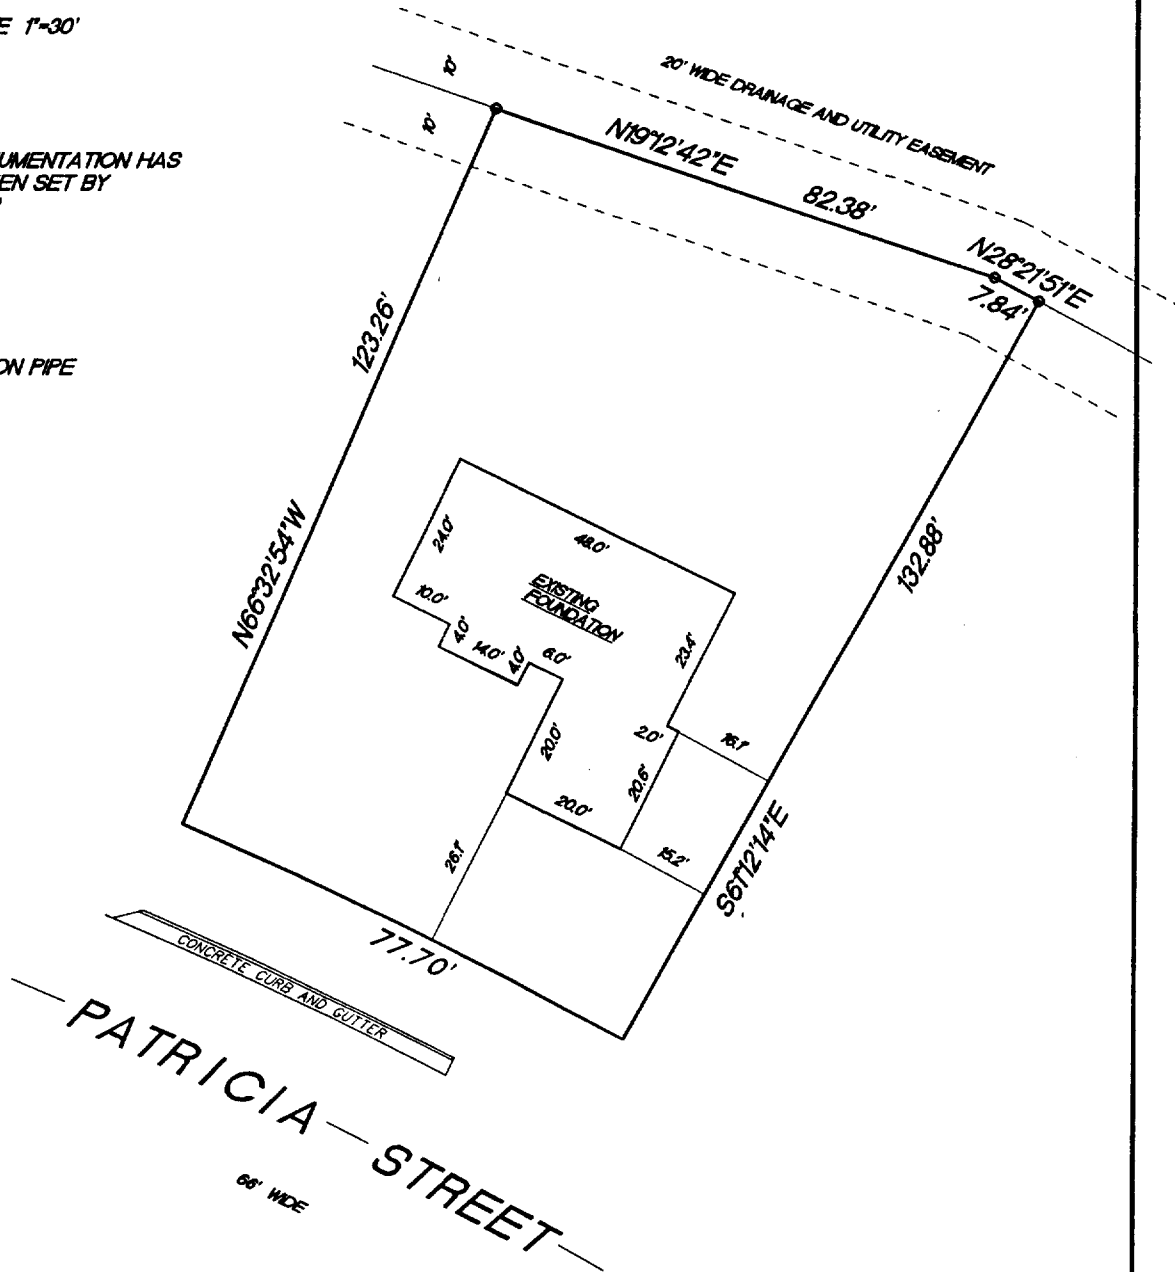

RADIUS	LENGTH	CHORD	BEARING	DELTA
833.00'	77.70'	77.67'	S26°07'26"W	052°0'40"

"I hereby certify that I have surveyed the above described property and that the above map is a true representation thereof and shows the size and location of the property, its exterior boundaries, the location of all visible structures and dimension of all principal buildings thereon, boundary fences, apparent easements, roadways and encroachments if any."

"This survey is made for the use of the present owners of the property, and also those who purchase, mortgage or guarantee the title thereto within one year from date hereof."

KETTLE MORaine SURVEYING
W356 S9050 Godfrey Lane
Eagle Wisconsin 53119
P.O. Box 357
(262) 594-3484
Terrance E. Pisarek R.L.S.

THIS IS NOT AN ORIGINAL SURVEY UNLESS THE SEAL IS RED.

REV. 4/11/00
3/2/00

DATE

TEP/DW

FIELD WORK BY

TEP

DRAWN BY

00043

JOB NUMBER

YHP-48


004-1230

PLAT OF SURVEY

LOT 48, HARVEST POINTE, being a part of Lot 4 of Certified Survey Map No. 2083, and a part of the Northeast 1/4, Northwest 1/4, Southeast 1/4 and the Southwest 1/4 of the Southwest 1/4 of Section 30, Town 3 North, Range 17 East, City of Elkhorn, Walworth County, Wisconsin.

Surveyed for: Bielinski Brothers Builders/Dotty Kern

Suggested yard grade per grading plan: 1013.3


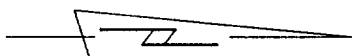


SCALE 1"=30'

FRONT MONUMENTATION HAS NOT YET BEEN SET BY DEVELOPER

○ FOUND 1" IRON PIPE
EXISTING SPOT ELEVATIONS

BM SAN MH FM 1011.58

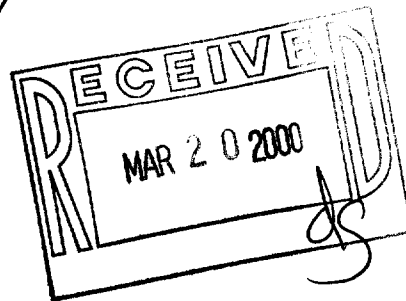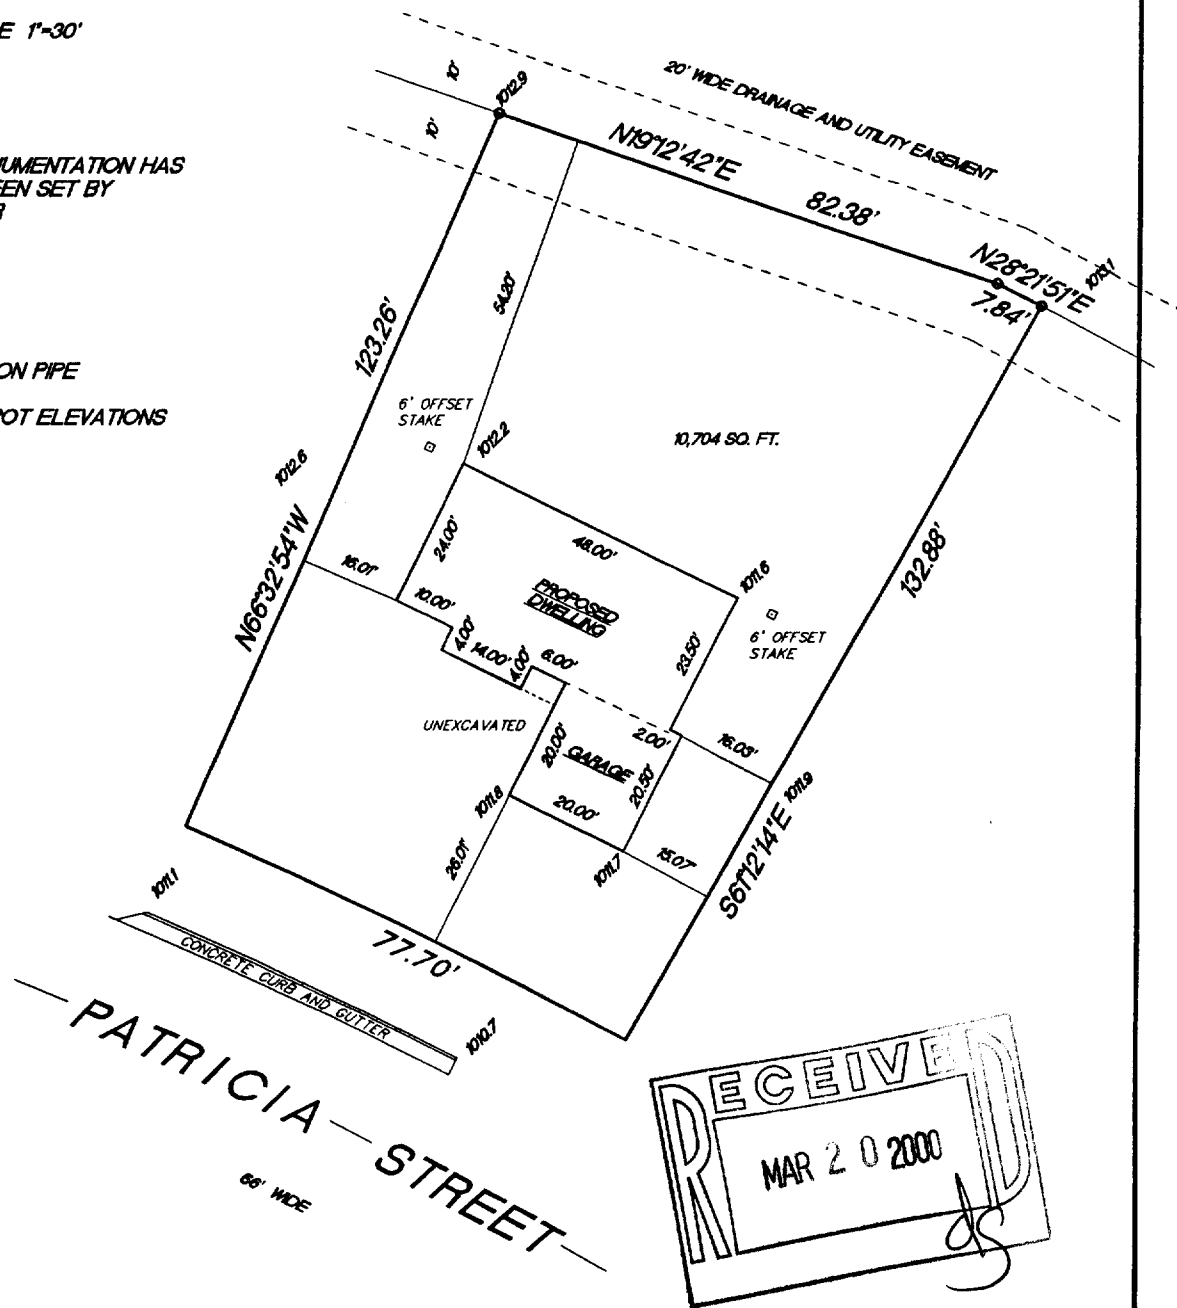

RADIUS	LENGTH	CHORD	BEARING	DELTA
833.00'	77.70'	77.67'	S26°07'26"W	05°20'40"

"I hereby certify that I have surveyed the above described property and that the above map is a true representation thereof and shows the size and location of the property, its exterior boundaries, the location of all visible structures and dimension of all principal buildings thereon, boundary fences, apparent easements, roadways and encroachments if any."

"This survey is made for the use of the present owners of the property, and also those who purchase, mortgage or guarantee the title thereto within one year from date hereof."

KETTLE MORaine SURVEYING
W356 S9050 Godfrey Lane
Eagle Wisconsin 53119
P.O. Box 357
(262) 594-3484
Terrance E. Pisarek R.L.S.

THIS IS NOT AN ORIGINAL SURVEY UNLESS THE SEAL IS RED.

3/2/00 DATE TEP/DW FIELD WORK BY TEP DRAWN BY 00043 JOB NUMBER

YHP-48

004-1230