



#100-63

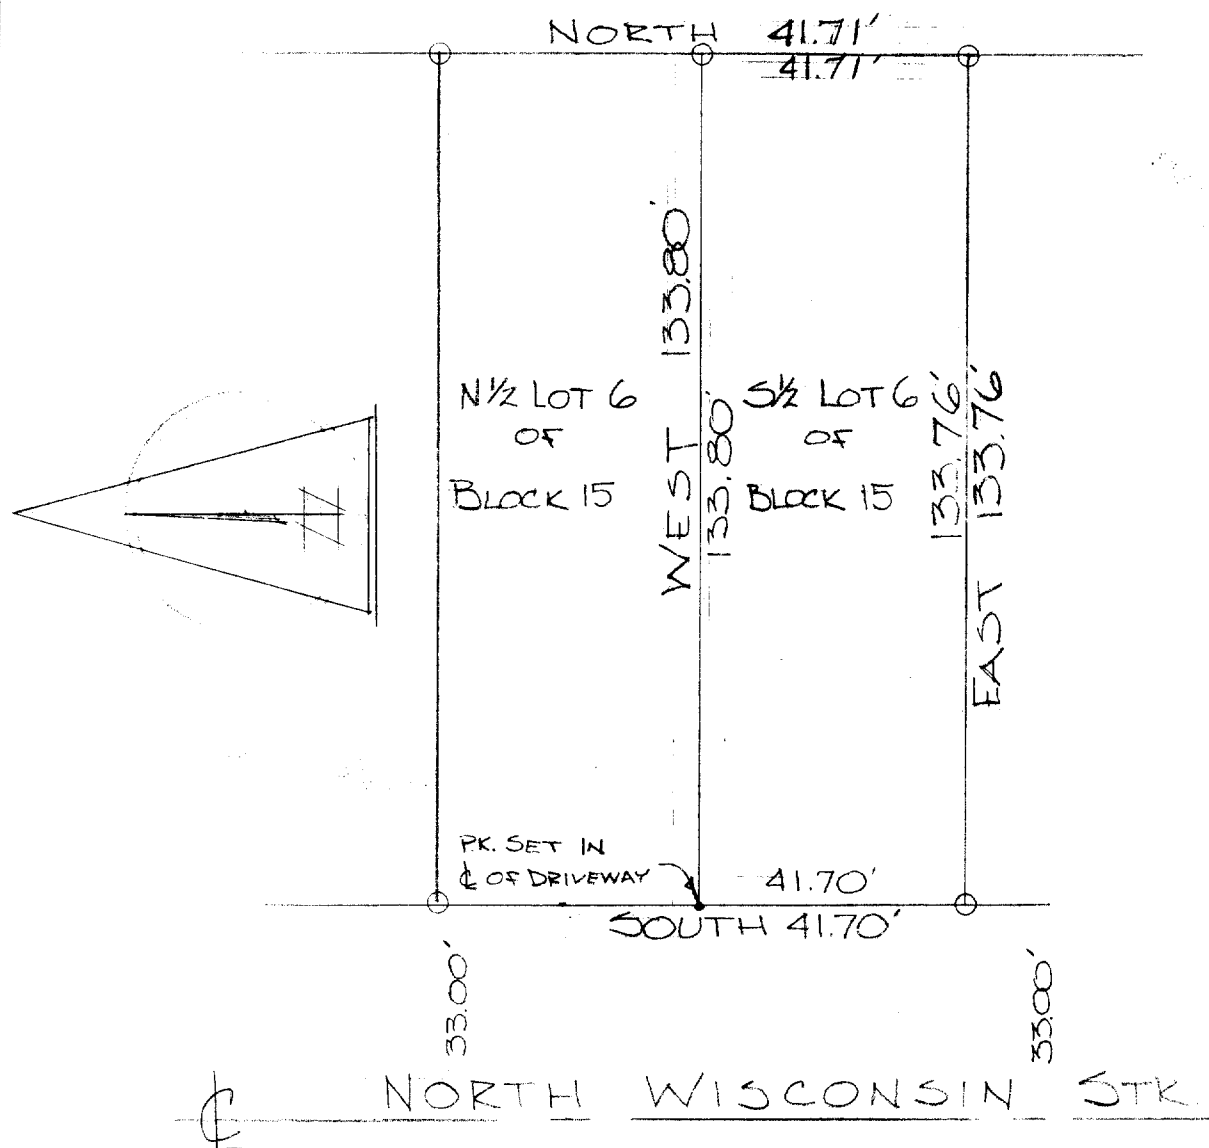

DESCRIPTION: The S $\frac{1}{2}$ of Lot #6 of Block 15 of the Original Plat
of the City of Elkhorn, Walworth County, Wisconsin.

CERTIFICATE: I, James F. Biagi, surveyor, do hereby certify that
I have surveyed the property hereon described.

August 26, 1963.

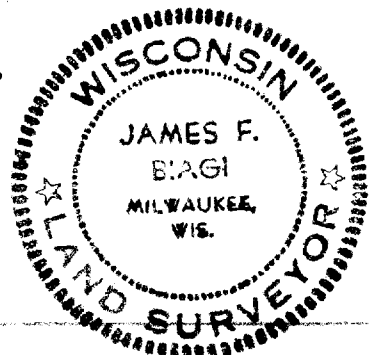

James F. Biagi

OP-94

4-125B