


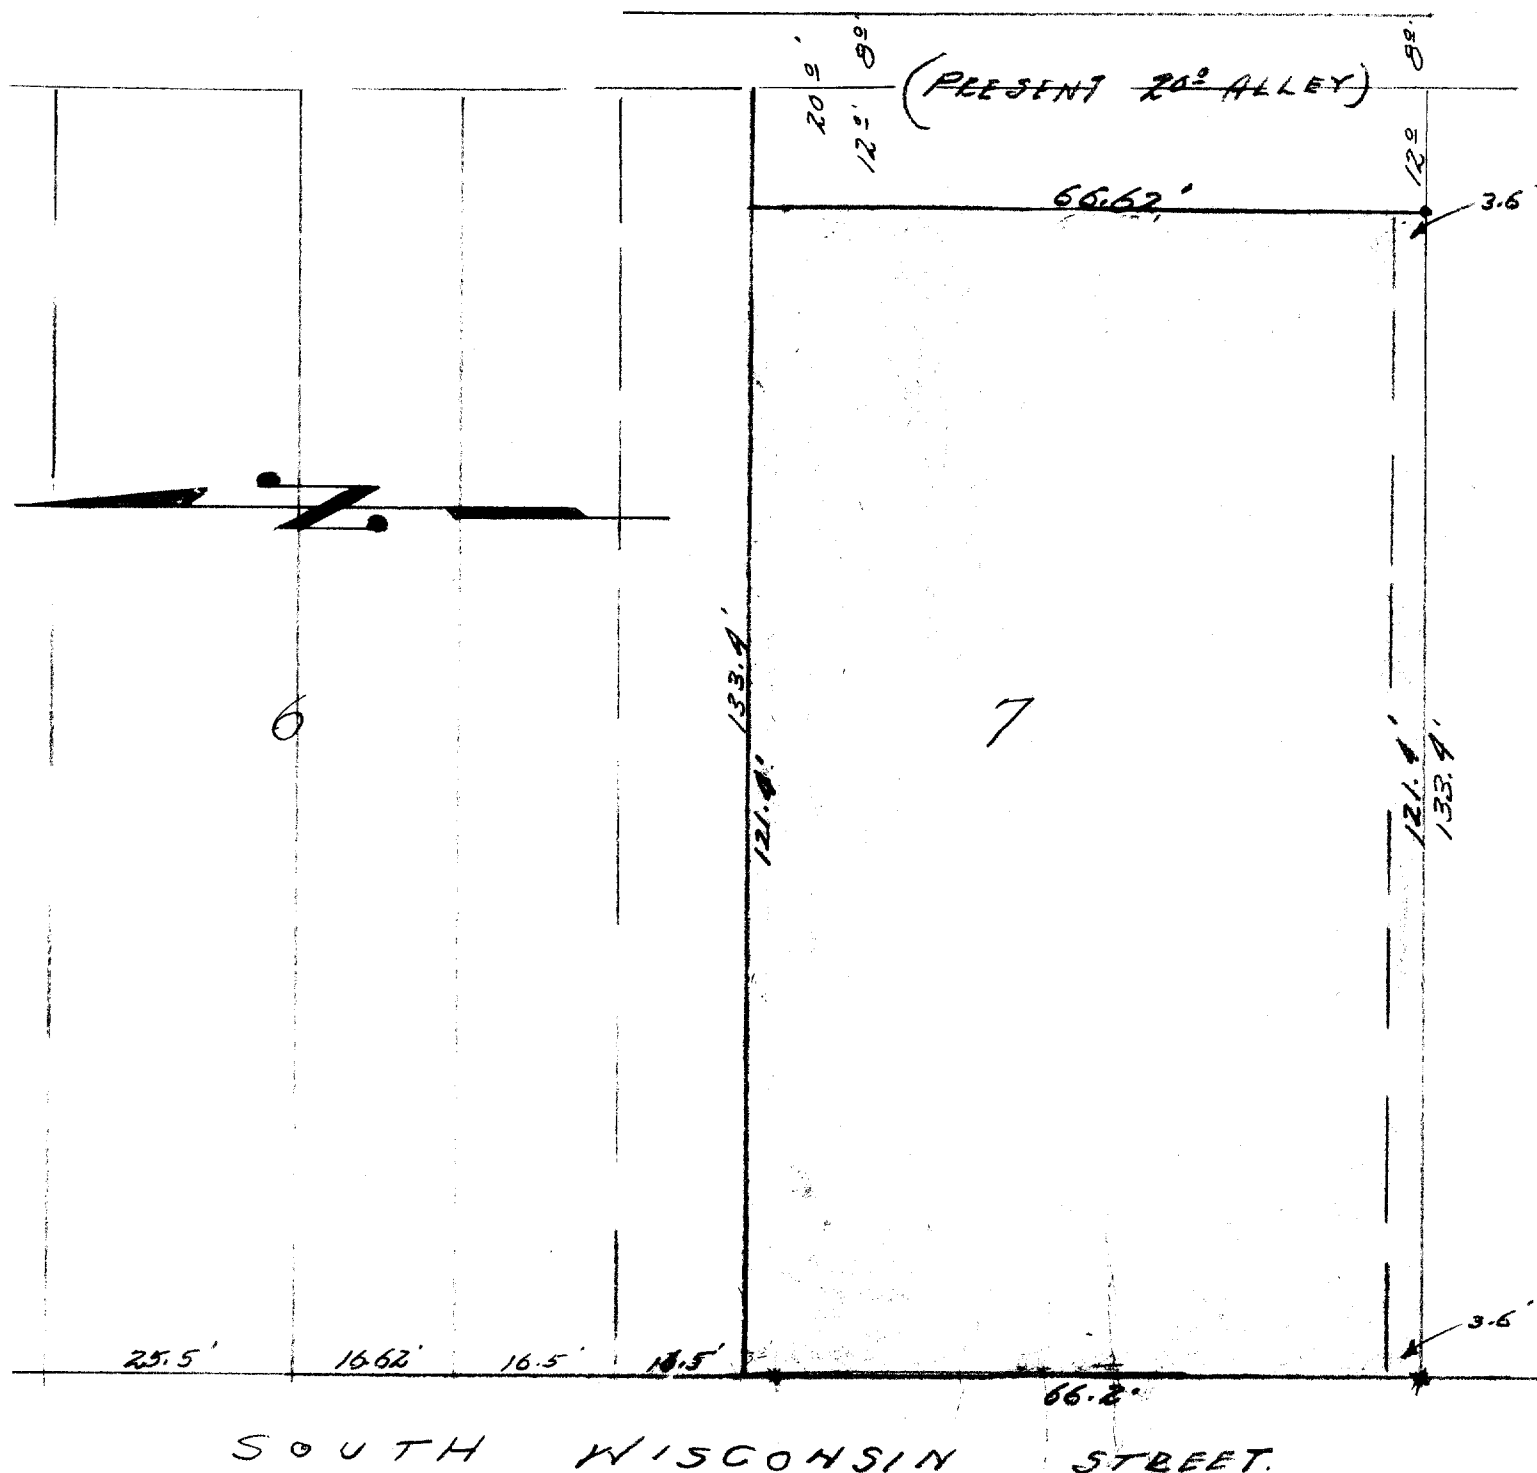

DESCRIPTION:

Lot 7 Block 25 Original Plat of the City of Elkhorn, Walworth County, Wisconsin; except the East 12 feet thereof and except the North 16.5 feet thereof.

CERTIFICATE:

I, hereby certify that I have on this the 30th day of August, 1955, surveyed the above described property according to the official record on file in the office of the Recorder of Deeds in and for Walworth County, Wisconsin, and the above portrayal is a correct representation of said survey.

SIGNED AND SEALED ON THIS THE 31ST DAY OF AUGUST 1955.

Joseph M. Bagg Professional Engineer
Elkhorn Wisconsin.