




SCALE - 1" = 50'
○ = IRON PIPE
● = CONC. MONU.

SECOND AVENUE

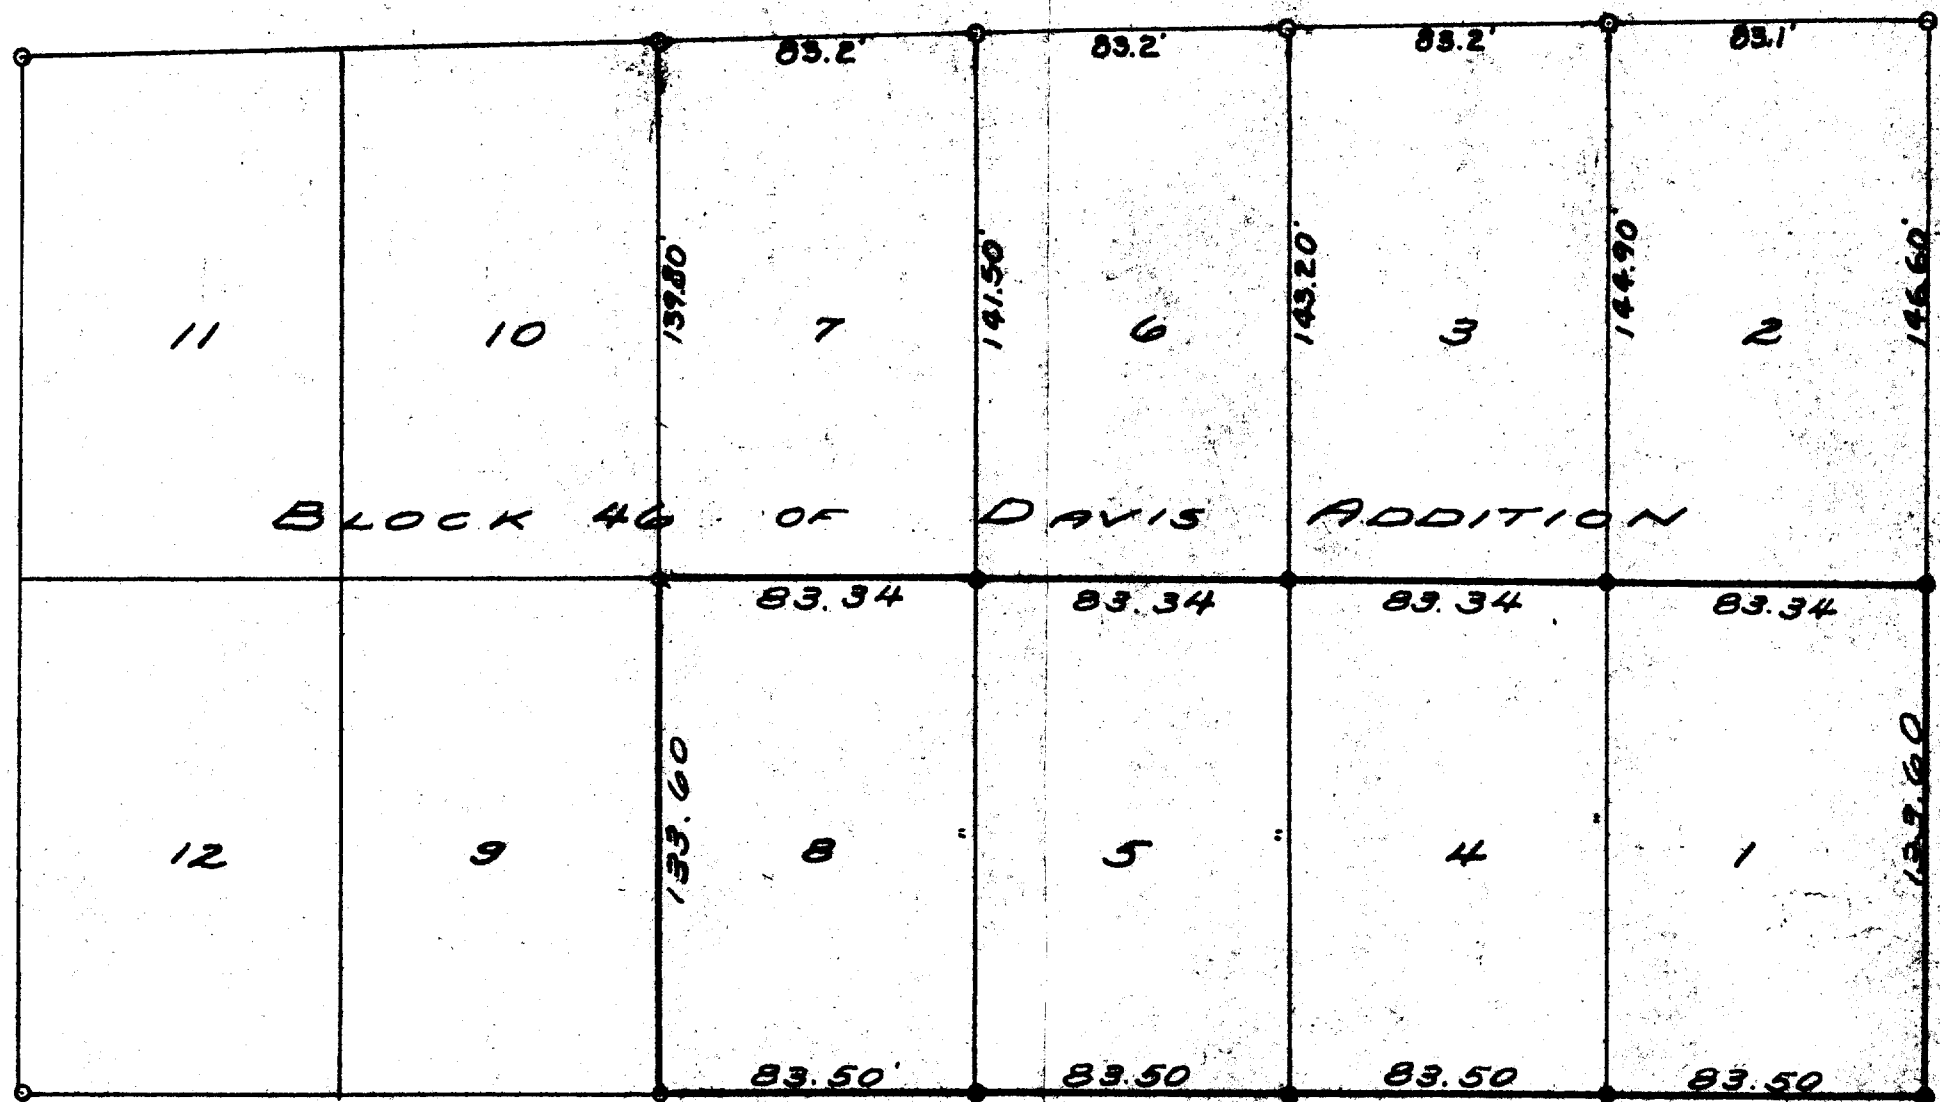

THIRD AVENUE

NORTH BROAD STREET

PLAT OF SURVEY OF LOTS 1, 4, 5 & 8, BLK. 46, DAVIS' ADDITION TO THE CITY OF ELKHORN, WALWORTH COUNTY, WISCONSIN.

MAY 29, 1946

H. E. Johnson
SURVEYOR