
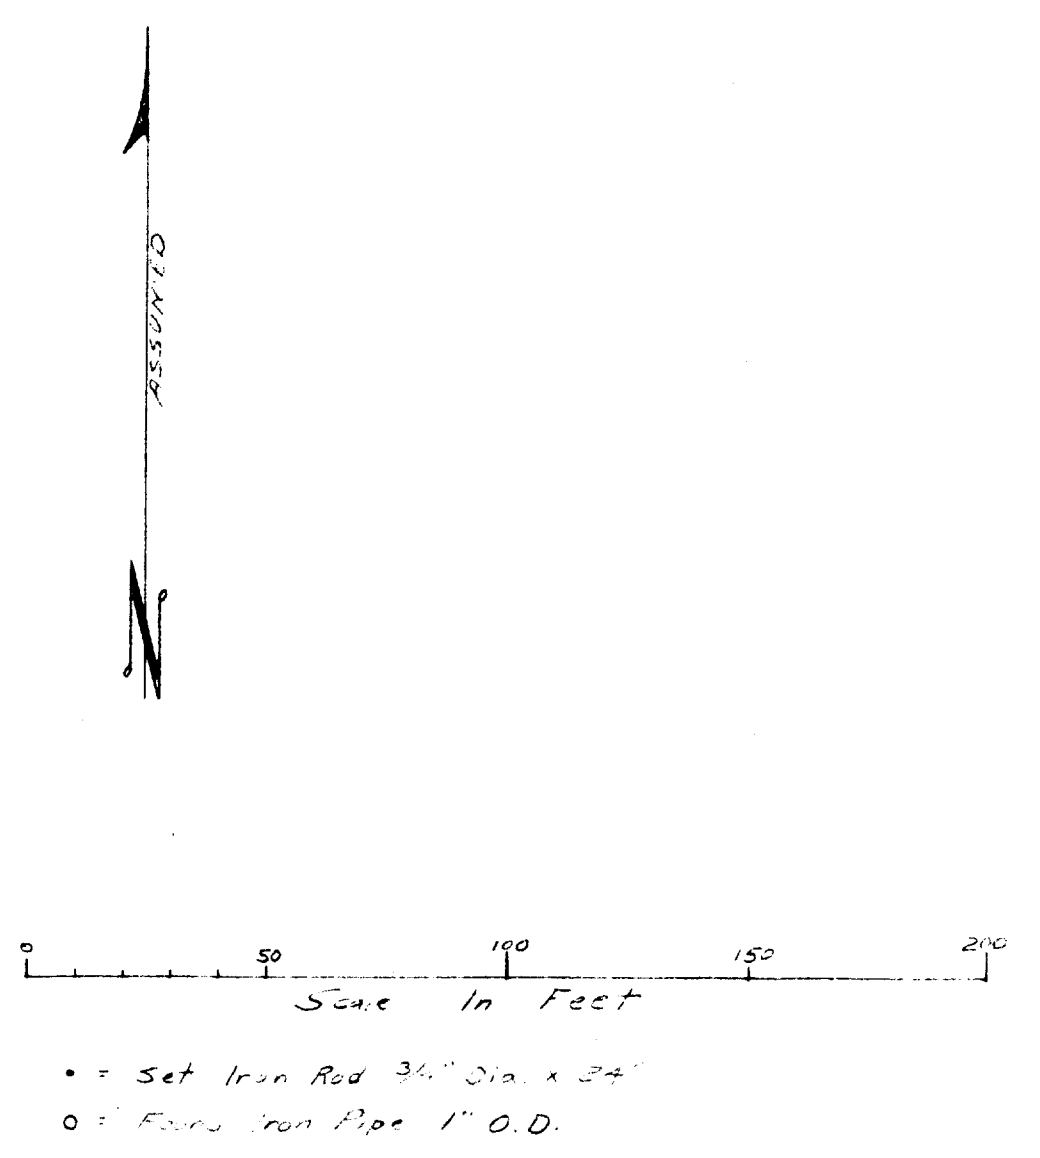


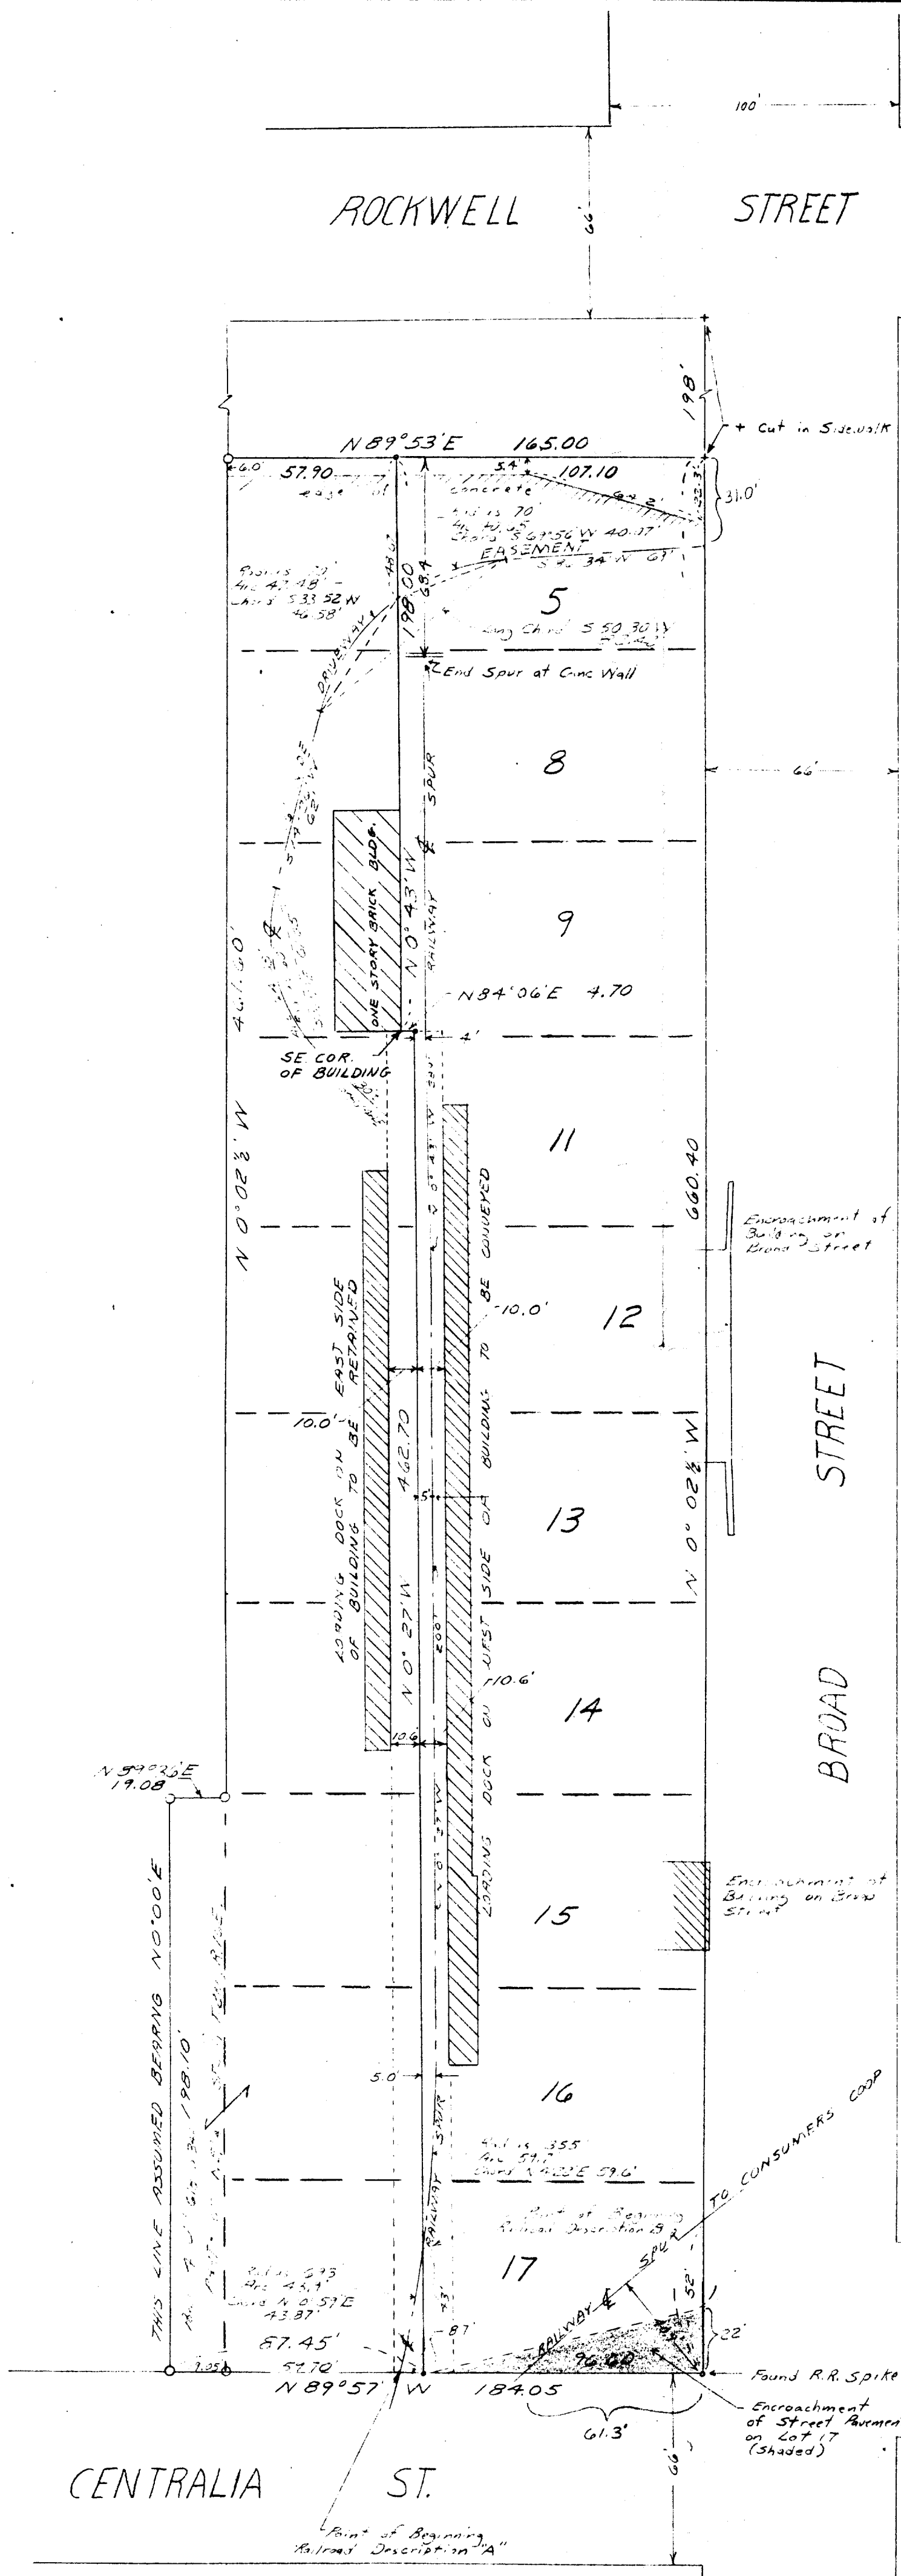

PART OF THE NE 1/4 SEC. 1, T.2N, R.16E.
CITY OF ELKHORN, WALWORTH CO., WISCONSIN

PLAT OF SURVEY

LOTS 5, 8, 9, 11, 12, 13, 14, 15, 16, & 17 Block 1, Rockwell Bros. Addition to the City of Elkhorn

ALSO
Parcel 4 as Recorded in Vol. 618 Page 378

DRAWN BY R.R.F.	JENSEN & JOHNSON CIVIL ENGINEERS ELKHORN, WIS.	ORIG. SCALE: 1" = 40'
CHECKED BY		REVISED 9 July 1975
APPROVED BY <i>Lloyd L. Jensen</i>		SHEET NO. OF

DATE 30 JUNE 1975