




PLAT OF SURVEY
LOT 2 OF CERTIFIED SURVEY MAP NO. 2154

RECORDED IN VOL. 10, ON PAGE NO. 198


AS DOCUMENT NO. 235431

CITY OF ELKHORN

WALWORTH COUNTY, WISCONSIN

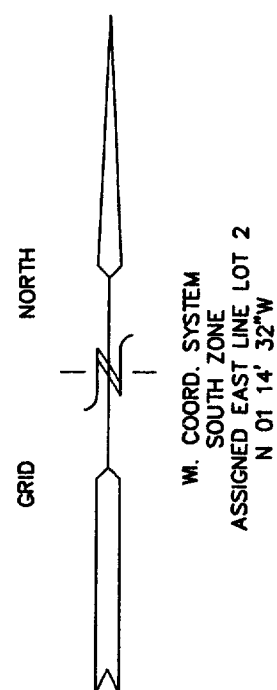


STATE TRUNK HIGHWAY "67"
(N ACCESS PERMITTED)

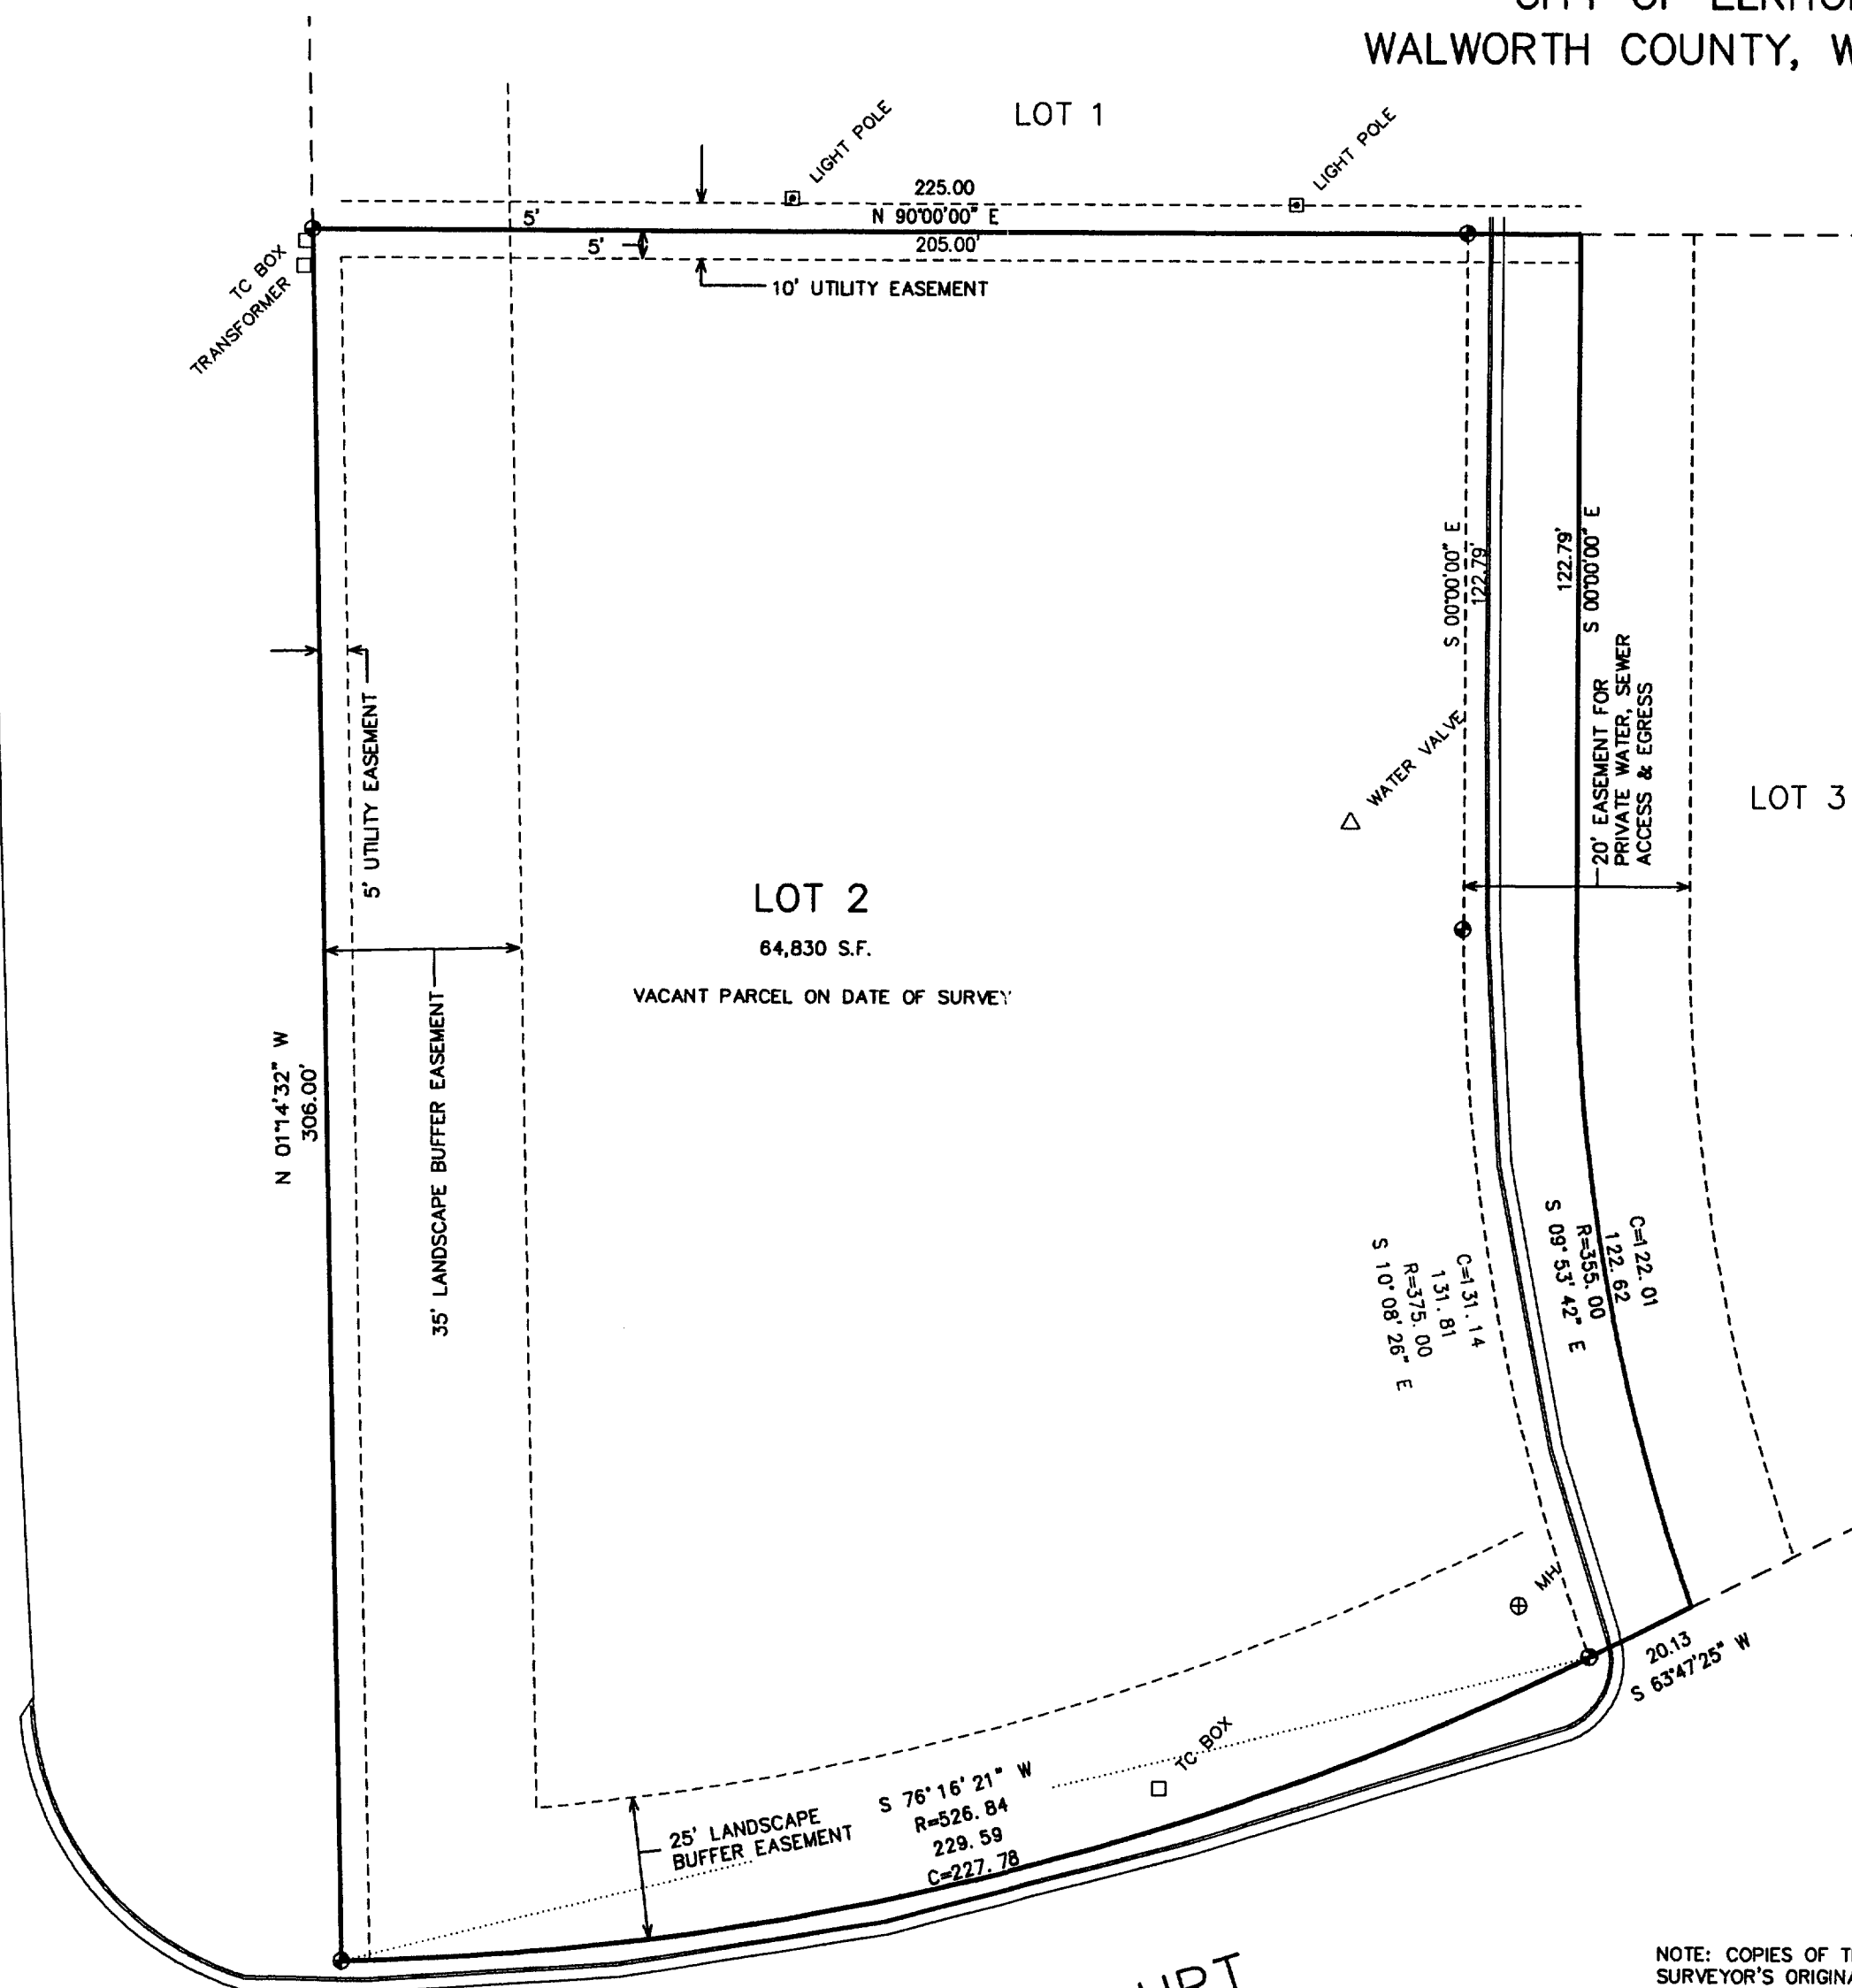

LEGEND

● = FOUND IRON REBAR STAKE
(xxx) = RECORDED AS

COMMERCE COURT
66' WIDE PUBLIC STREET

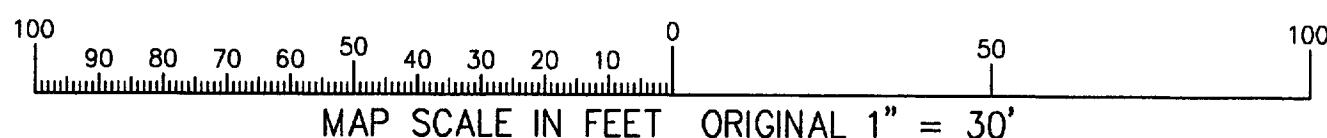


NOTE: COPIES OF THIS MAP TO WHICH THE FOLLOWING CERTIFICATE WILL APPLY SHOW SURVEYOR'S ORIGINAL SEAL AND SIGNATURE IN RED INK. COPIES BY ANY OTHER MEANS MAY HAVE ALTERATIONS WHICH DO NOT REPRESENT THE SURVEYOR'S WORK PRODUCT.

I HEREBY CERTIFY THAT THE ABOVE DESCRIBED PROPERTY HAS BEEN SURVEYED UNDER MY DIRECTION AND THAT THE ABOVE MAP IS A TRUE REPRESENTATION THEREOF AND SHOWS THE SIZE AND LOCATION OF THE PROPERTY, ITS EXTERIOR BOUNDARIES, THE LOCATION OF ALL VISIBLE STRUCTURES, AND DIMENSIONS OF ALL PRINCIPLE BUILDINGS THEREON, BOUNDARY FENCES, APPARENT EASEMENTS, ROADWAYS, AND VISIBLE ENCROACHMENTS, IF ANY. THIS SURVEY IS MADE FOR THE USE OF THE PRESENT OWNERS OF THE PROPERTY, AND ALSO THOSE WHO PURCHASE, MORTGAGE, OR GUARANTEE THE TITLE THERETO WITHIN ONE YEAR FROM THE DATE HEREOF.

DATED: JAN. 19, 2001

PETER S. GORDON R.L.S. 2101

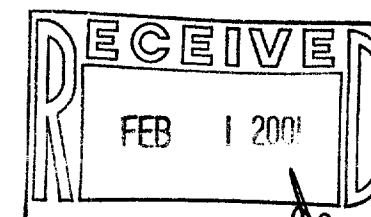

WORK ORDERED BY: LOWELL SWEET
FOR THE CITY OF ELKHORN
ELKHORN, WISCONSIN

FARRIS, HANSEN & ASSOCIATES, INC.
Engineering, Architecture, Surveying
7 Ridgway Court P.O. Box 437
ELKHORN, WISCONSIN 53121
Office: (414) 723-2098
Fax: (414) 723-5886

REVISIONS

PROJECT NO.
5731
DATE:
01-19-01
SHEET NO.
1 OF 1

YA-2154-2

004-1321