
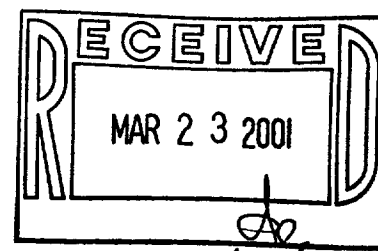
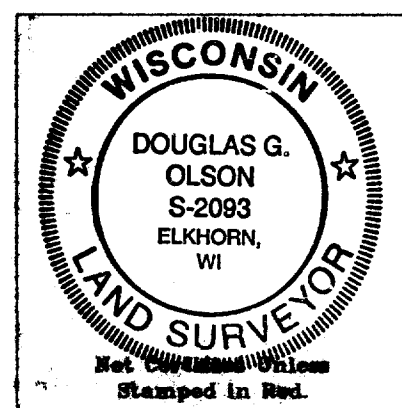


Plat of Survey

of
The South 2 1/2 feet of Lot 3, the North 1/2 of Lot 6
and the North 4 feet of the South 1/2 of Lot 6 all in
Block 15 of the Original Plat of the Village (now City)
of Elkhorn, located in the Southeast 1/4 of Section 38,
Town 3 North, Range 16 East, City of Elkhorn, Walworth
County, Wisconsin.

Surveyed for: **Elroy Sommer**
311 North Lincoln Street
Elkhorn, Wisconsin. 53121

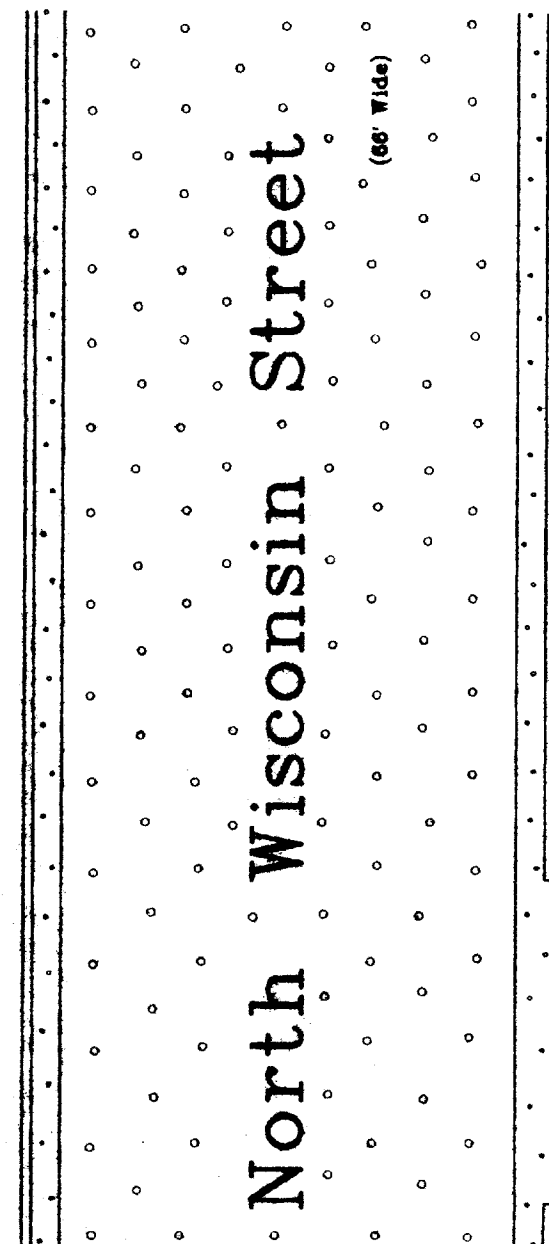

Notes: 1) This survey plat is not
certified unless signed
and sealed in red ink.


2) This survey is subject to Wisconsin lien laws.
This Plat of Survey is the notice of intent
to file lien. Lien waiver required.

Copyright © 2000 by Jensen & Olson Land Surveying, LLC.


All rights reserved. No part of this survey plat may be reproduced
or transmitted in any form by any means - graphic, electronic, or
mechanical, including photocopying, tracing, or information storage
and retrieval systems - without permission in writing from Douglas
G. Olson, Jensen & Olson Land Surveying, LLC.

I, Douglas G. Olson, Wisconsin Registered Land Surveyor,
do hereby certify that this survey was performed by me or under my
direction in full compliance with the owner's/agent's instructions
and Chapter A-E 7 of the Wisconsin Administrative Code "Minimum
Standards for Property Surveys", and that this map is an accurate
representation thereof to the best of my knowledge and belief.

Douglas G. Olson
Wisconsin Registered Land Surveyor - 2093

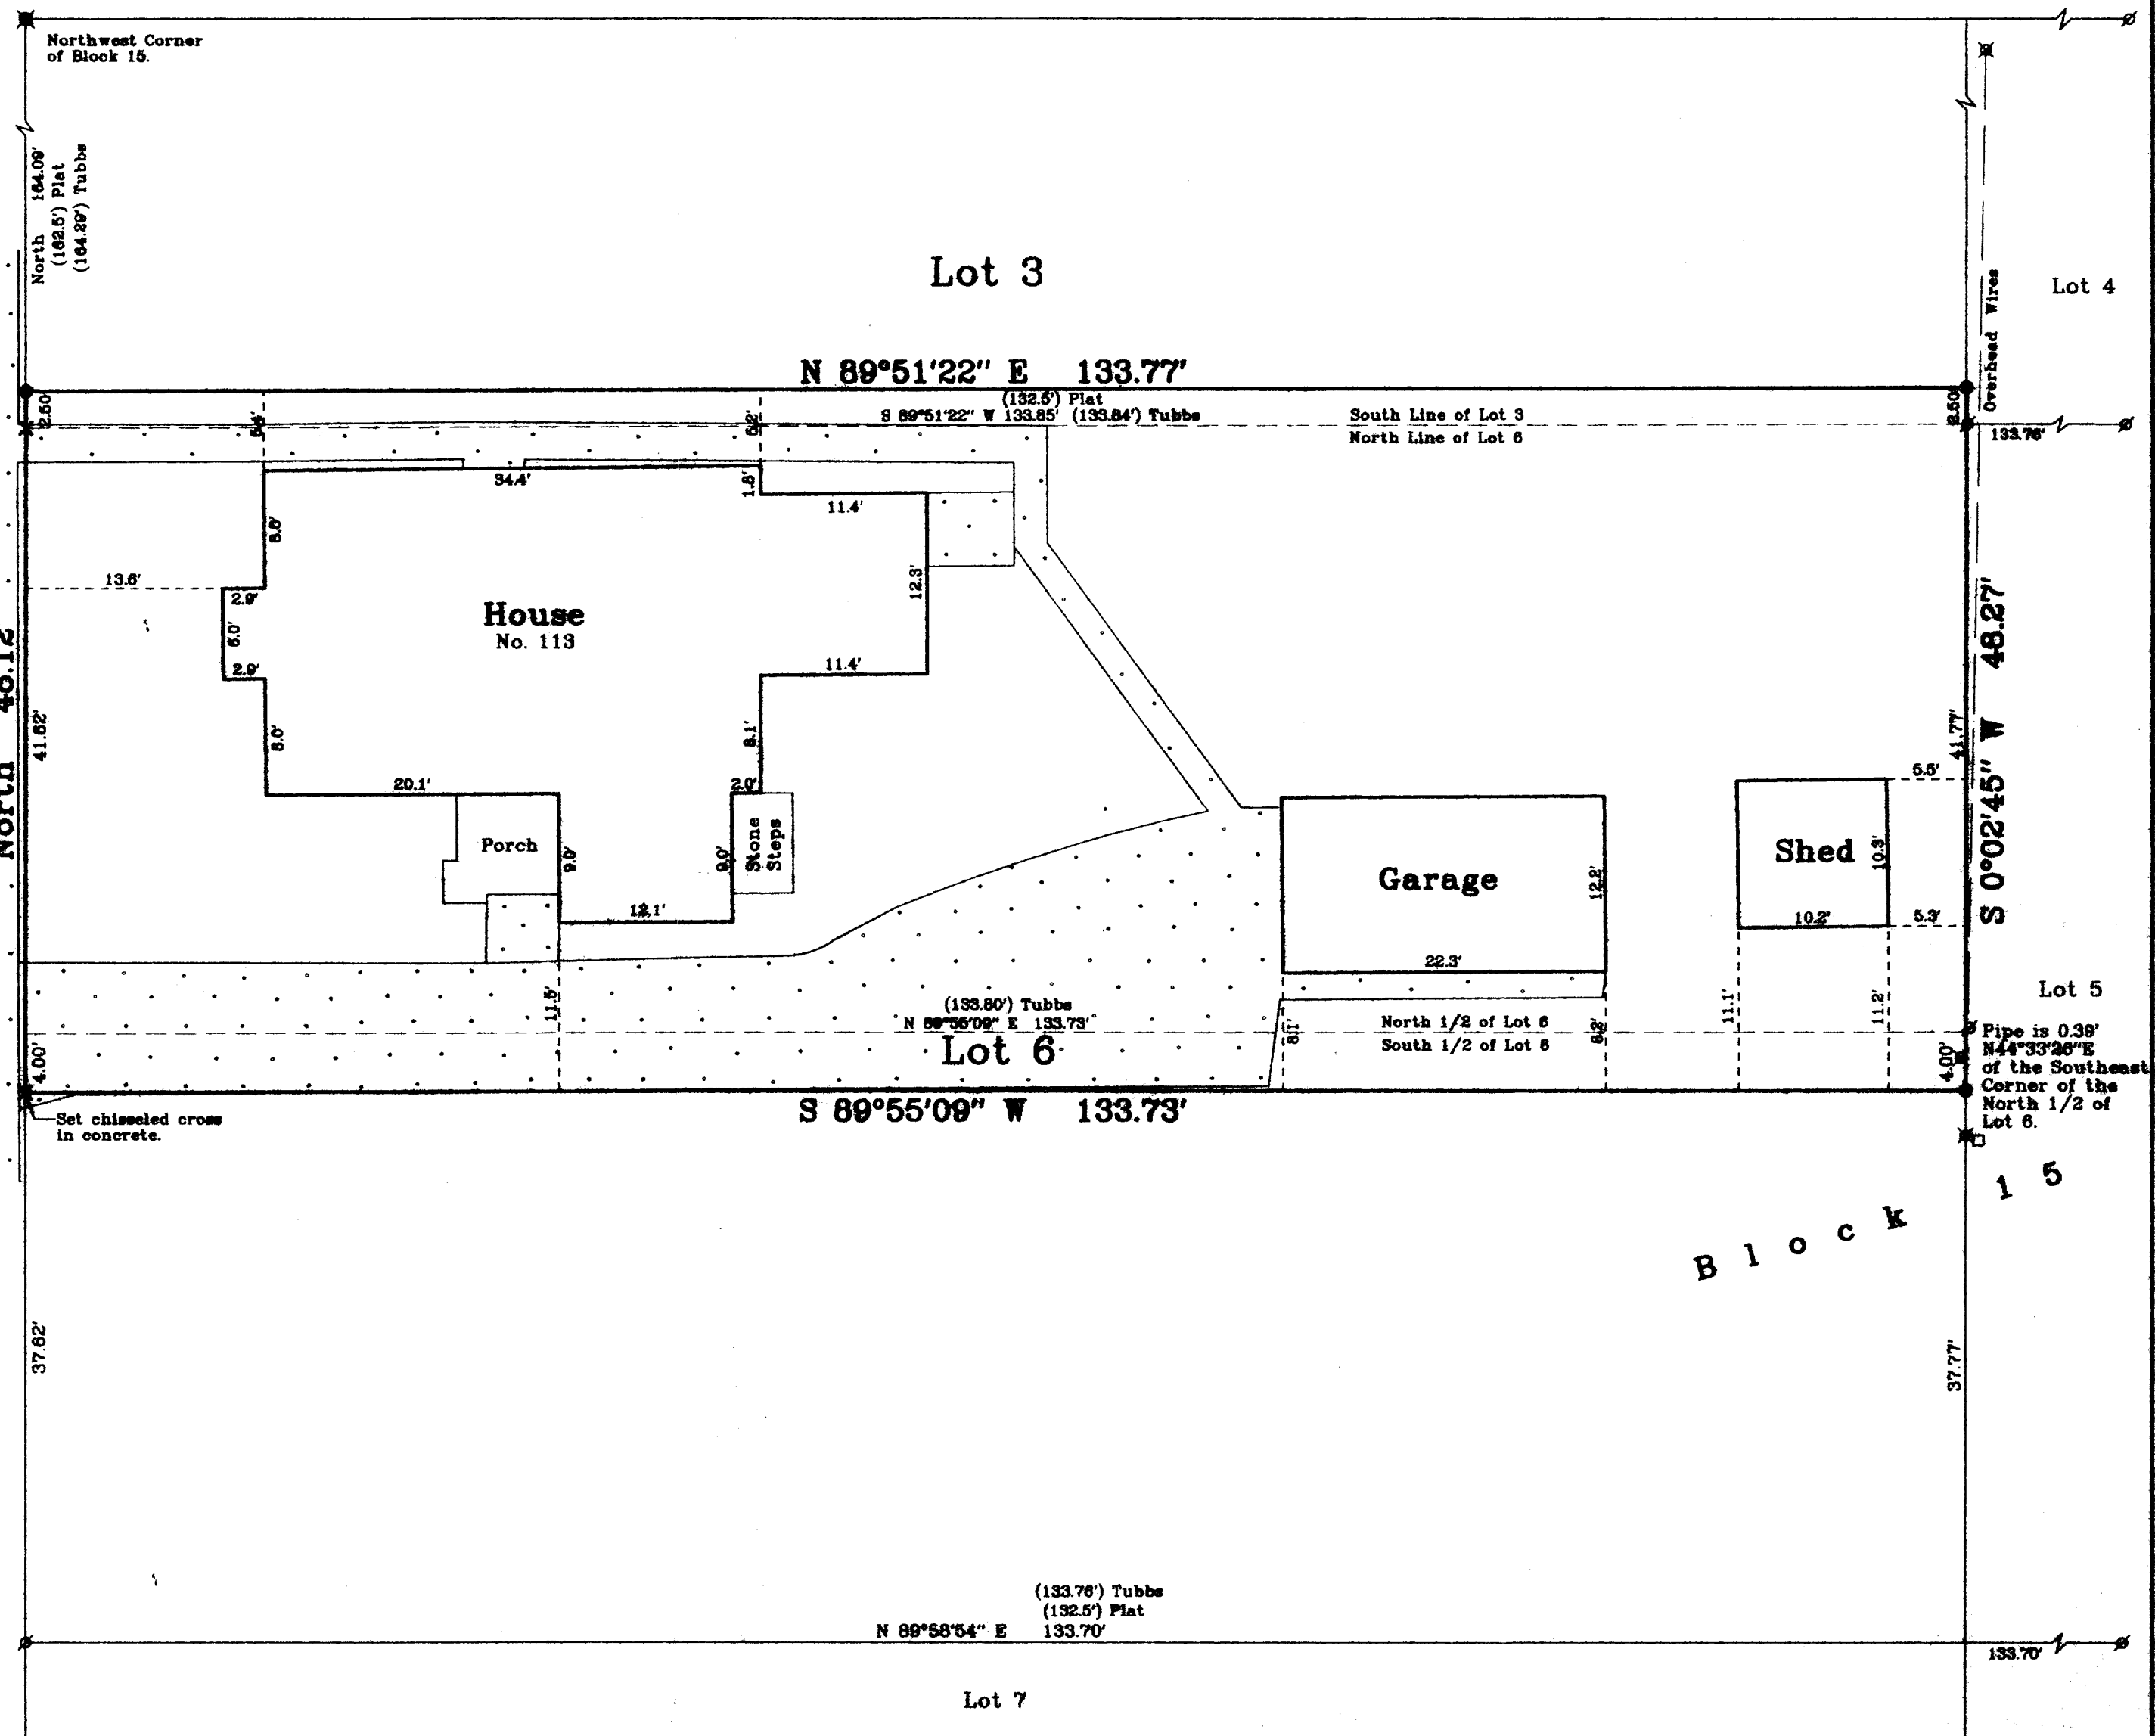

Survey Date: Nov. 10, 2000.
Revisions:

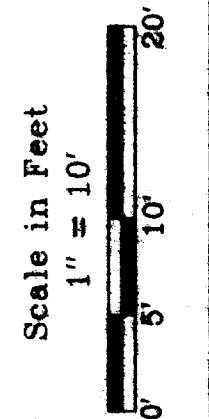

Jensen & Olson Land Surveying, LLC
45 South Wisconsin Street P.O. Box 322
Elkhorn, Wisconsin 53121
Telephone (262) 723-3434
Facsimile (262) 723-8044

Legend
Found Iron Pipe
Found Iron Rod
Found Chiseled Crosscut Nail
Found Chiseled Nail
Found Iron Rod, 3/4" dia.
Recorded Information
Concrete Surface
Asphalt Surface
Utility Pole
Utility Ped.

Sheet 1 of 1 Sheets
Job Reference Number
2000.149

2000.149