


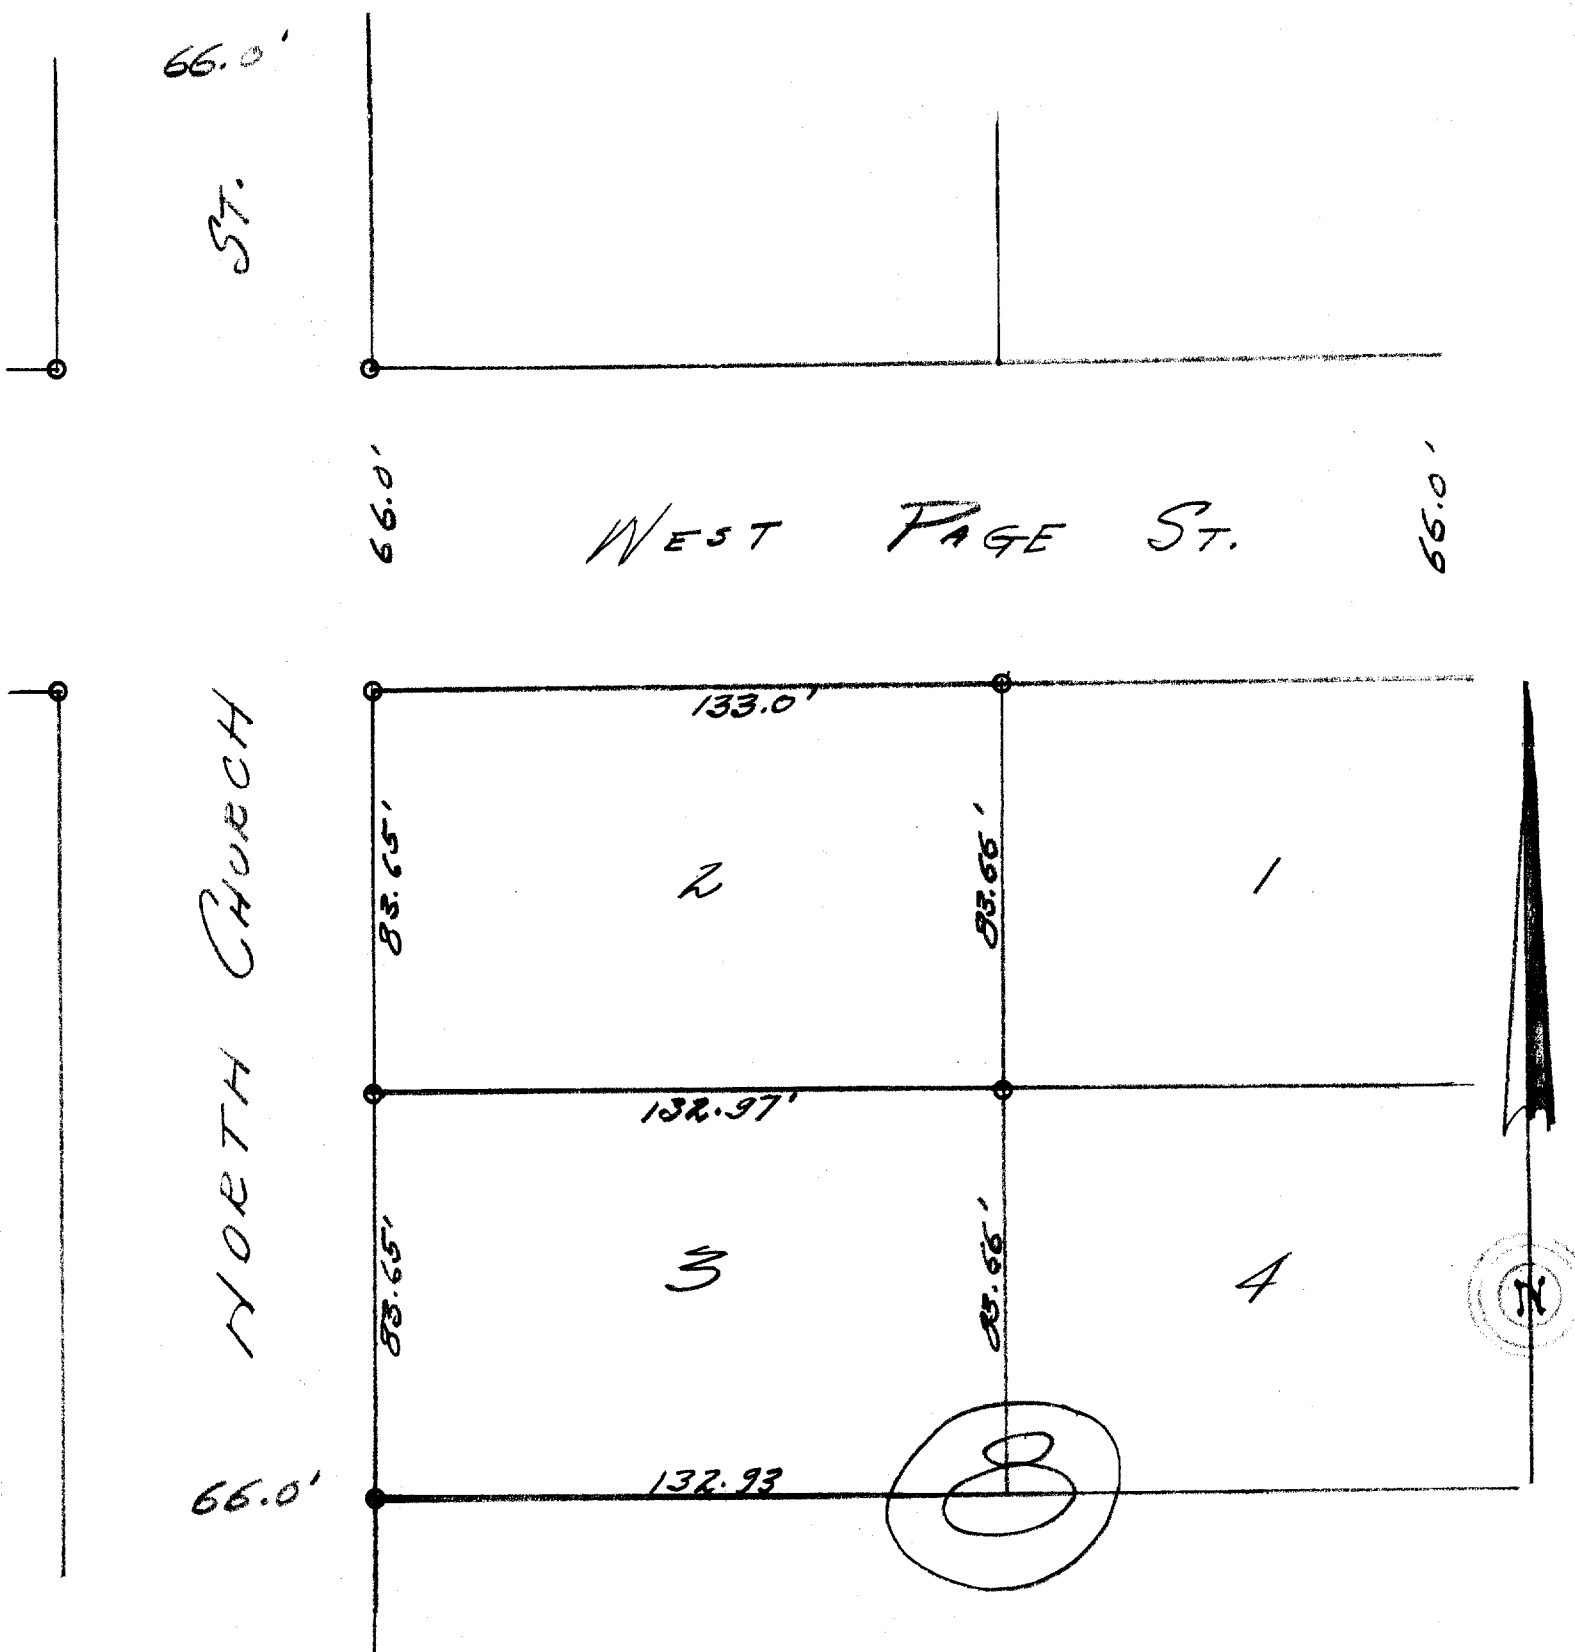

DESCRIPTION:

Lot, 2, Block 8; Original Plat of the City of Elkhorn, Walworth County, Wisconsin.

CERTIFICATE:

I, Joseph M. Biagi, hereby certify that I, have on this the 10th day of June 1954, surveyed the above described property according to the official records on file in the office of the Recorder of Deeds in and for Walworth County, Wisconsin, and find that the measurements and bearings of the boundary lines, said property as taken at the site on this day substantially agree with those in said official record and that no encroachments exist.

SIGNED AND SEALED ON THIS THE 14TH DAY OF JUNE 1954.

Joseph M. Biagi, Professional Engineer.
Elkhorn Wisconsin.