

Court Street

Curb
Sidewalk

Sidewalk

Sidewalk

Curb

Wisconsin Street

☒ MW-9
N. 5,370.43
E. 4,951.23
PVC El.=99.20
Gr. El.=99.7

MW-10 ☒
N. 5,323.52
E. 5,446.55
PVC El.=96.78
Gr. El.=97.1

Benchmark 1
Chiseled + on
Northeast bolt
of concrete light
pole base.
Elev. = 99.52

☒ MW-1
N. 5,286.17
E. 5,003.43
PVC El.=98.96
Gr. El.=99.3
☒ MW-2
N. 5,275.73
E. 4,980.58
PVC El.=99.29
Gr. El.=99.6

Asphalt Parking

MW-7
N. 5,238.94
E. 5,110.72
PVC El.=98.44
Gr. El.=98.7 ☒

Well

MW-3
N. 5,245.85
E. 4,977.71
PVC El.=99.91
Gr. El.=100.2

Building Cor.
N. 5,234.86
E. 4,977.57

Building Cor.
N. 5,234.73
E. 5,050.61

Sidewalk

Elevation Reference
Elevations are referenced
to a local datum. An
elevation of 100.00 was
assumed on the Courthouse
floor at this point.

Walworth County
Courthouse

MW-4
N. 5,138.93
E. 5,058.15
PVC El.=99.28
Gr. El.=99.7

MW-4A
N. 5,136.21
E. 5,057.14
PVC El.=99.21
Gr. El.=99.6

Building Cor.
N. 5,088.59
E. 4,977.54

Building Cor.
N. 5,088.56
E. 5,050.59


MW-5 ☒
N. 5,086.17
E. 5,027.11
PVC El.=97.98
Gr. El.=98.6

Benchmark 2
Chiseled + on
Northeast bolt
of concrete light
pole base.
Elev. = 98.76

☒ MW-11
N. 5,039.91
E. 5,083.62
PVC El.=97.50
Gr. El.=97.9

MW-8
N. 5,076.01
E. 5,210.92
PVC El.=98.48
Gr. El.=98.9

☒ MW-6
N. 5,022.19
E. 5,226.85
PVC El.=96.19
Gr. El.=96.7

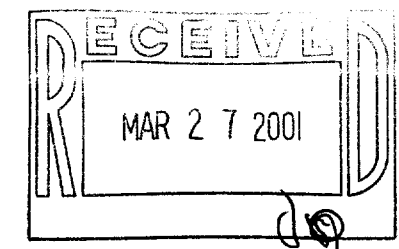



Property Exhibit

Monitoring Well Locations and Elevations,
located on a portion of the "Courthouse Square" in the
Southeast 1/4 of Section 36, Town 3 North, Range 16 East
City of Elkhorn, Walworth County, Wisconsin.

Address of site: 100 West Walworth Street
Elkhorn, Wisconsin. 53121

Prepared for: **Walworth County**
P.O. Box 1001
Elkhorn, Wisconsin. 53121


&
Midwest Enviro-Sciences, Inc.
P.O. Box 13183
Wauwatosa, Wisconsin. 53213

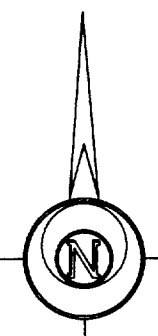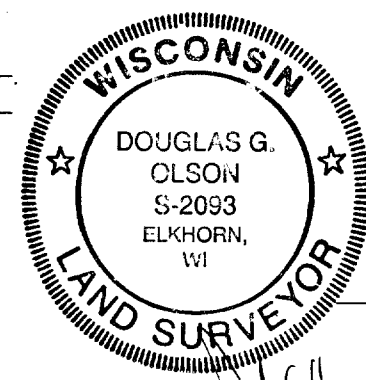

Bearings are assumed.
Coordinates are referenced
to a local datum.

Legend

- ☒ Monitoring Well
- Manhole
- Metal Cover
- ☒ Light Pole
- Concrete Surface
- PVC El. Elevation on top of PVC pipe inside well.
- Gr. El. Ground Elevation next to well.

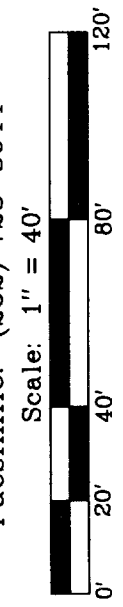

Jensen & Olson Land Surveying, LLC
45 South Wisconsin Street P.O. Box 322
Elkhorn, Wisconsin. 53121
Telephone: (262) 723-3434
Facsimile: (262) 723-8044

Mapping date: Nov. 30, 1999.
Revisions:


Sheet 2 of 2 Sheets.

Job Reference Number:
1999.085

Copyright © 1999 by Jensen & Olson Land Surveying, LLC.

All rights reserved. No part of this survey plat may be reproduced or transmitted in any form by any means - graphic, electronic, or mechanical, including photocopying, tracing, or information storage and retrieval systems - without permission in writing from Douglas G. Olson, Jensen & Olson Land Surveying, LLC.

YOP-140A 004-1340

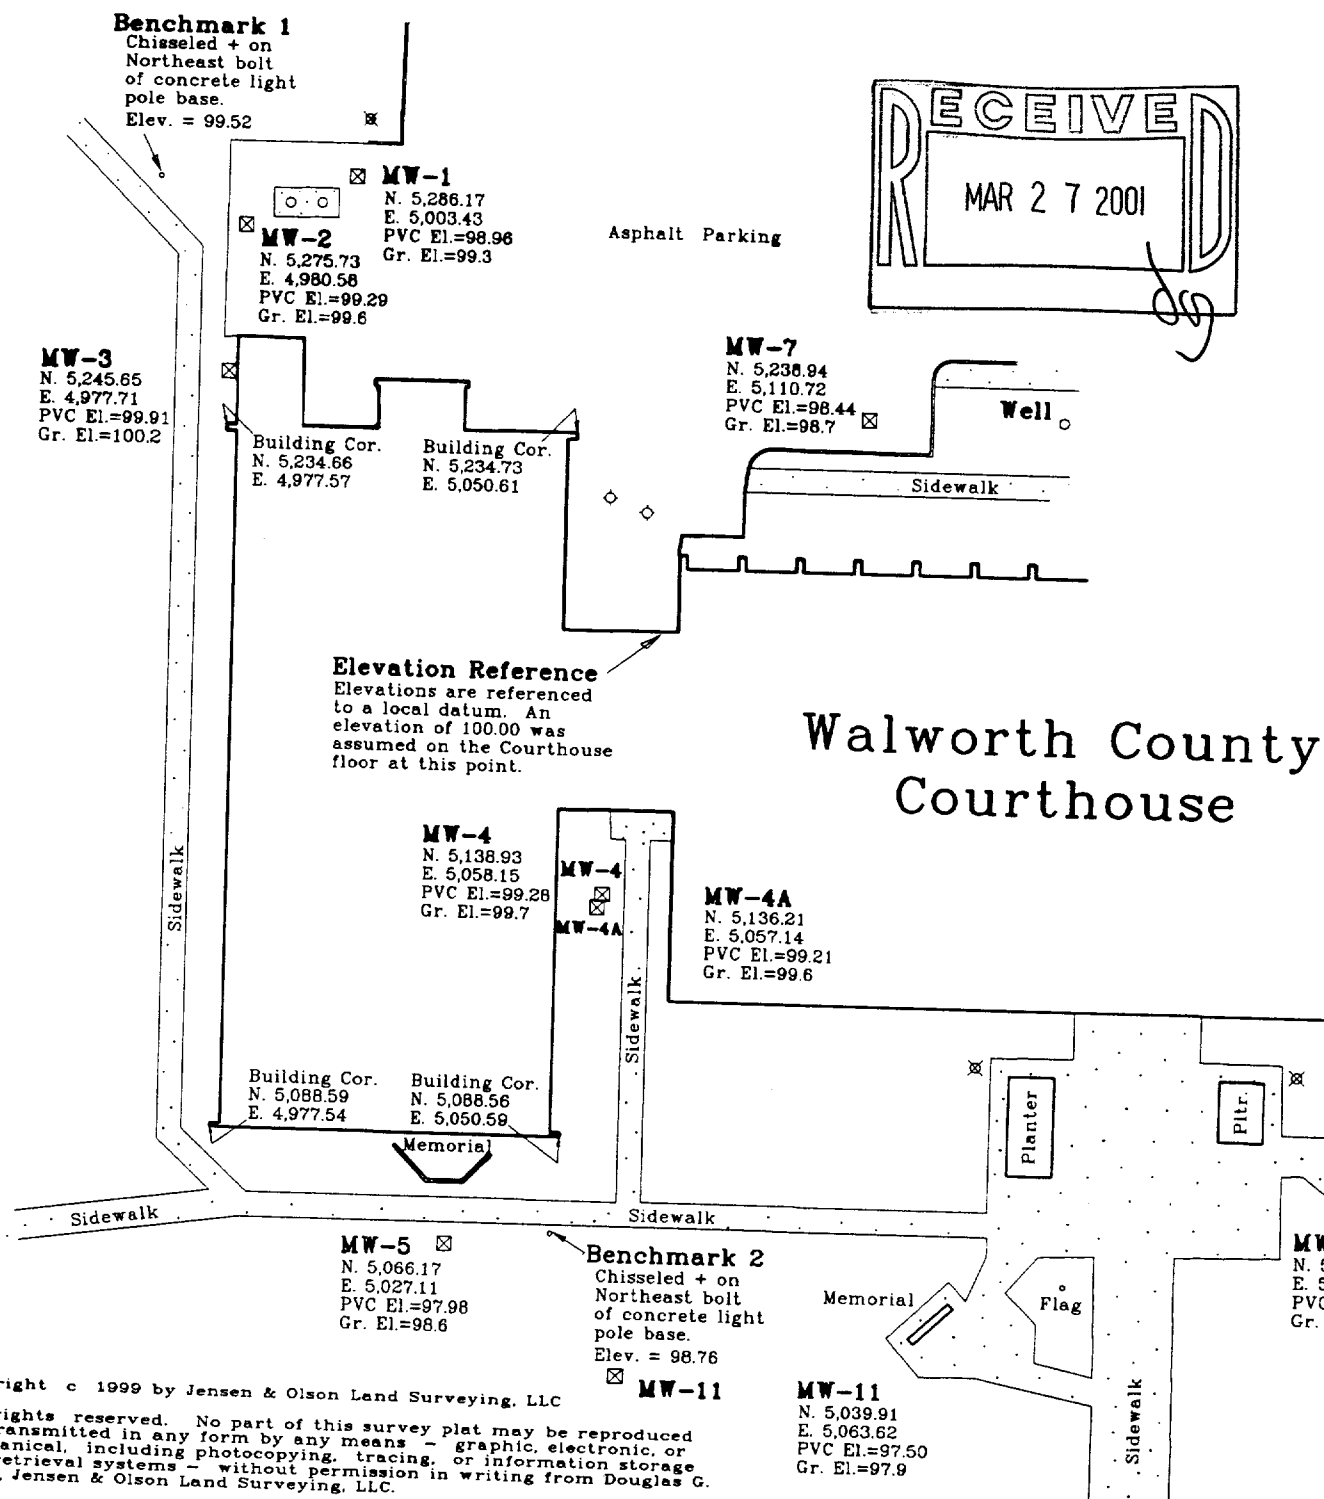


Property Exhibit

Monitoring Well Locations and Elevations,
located on a portion of the "Courthouse Square" in the
Southeast 1/4 of Section 36, Town 3 North, Range 16 East
City of Elkhorn, Walworth County, Wisconsin.


Address of site: 100 West Walworth Street
Elkhorn, Wisconsin. 53121

Prepared for: **Walworth County**
P.O. Box 1001
Elkhorn, Wisconsin. 53121

&
Midwest Enviro-Sciences, Inc.
P.O. Box 13183
Wauwatosa, Wisconsin. 53213

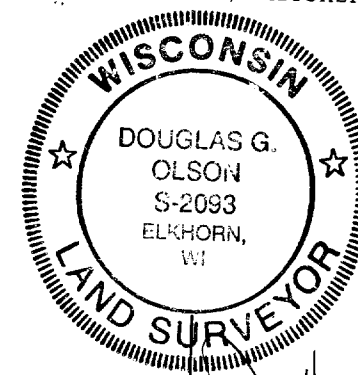

Location Map
1"=300'

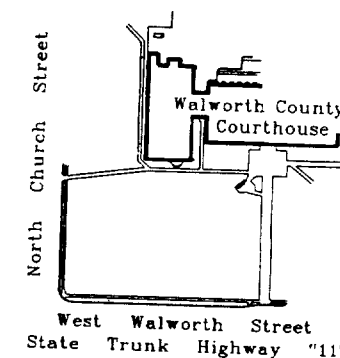


Bearings are assumed.
Coordinates are referenced
to a local datum.

Jensen & Olson Land Surveying, LLC
45 South Wisconsin Street P.O. Box 322
Elkhorn, Wisconsin. 53121
Telephone: (262) 723-3434
Facsimile: (262) 723-8044

Legend

- Monitoring Well
- Manhole
- Metal Cover
- Light Pole
- Concrete Surface
- PVC El. Elevation on top of PVC
- pipe inside well.
- Gr.El. Ground Elevation next to well.

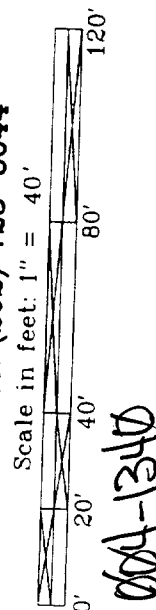

Mapping Date: Sept. 11, 1999.
Revisions: Sept. 23, 1999.
Nov. 29, 1999.
Sheet 1 of 1 Sheets
Job Reference No.
1999.085

Copyright © 1999 by Jensen & Olson Land Surveying, LLC
All rights reserved. No part of this survey plat may be reproduced
or transmitted in any form by any means - graphic, electronic, or
mechanical, including photocopying, tracing, or information storage
and retrieval systems - without permission in writing from Douglas G.
Olson, Jensen & Olson Land Surveying, LLC.

YOP-140A