
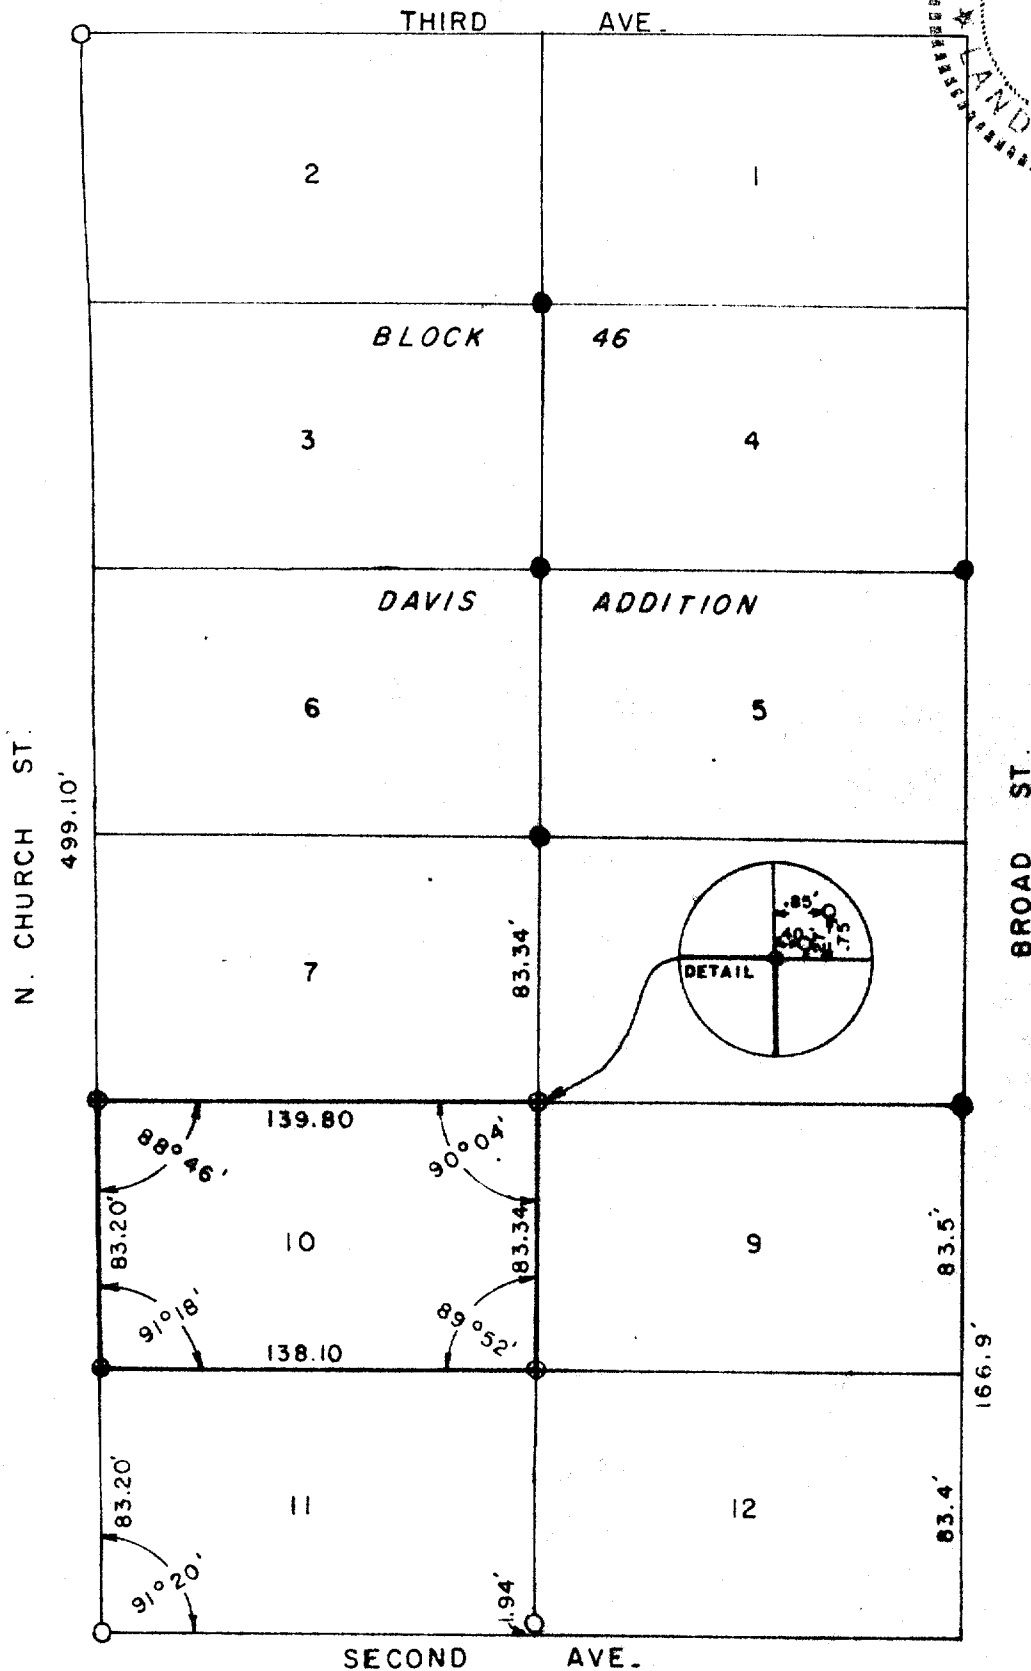


PLAT OF SURVEY

OF
LOT 10, BLOCK 46, DAVIS ADDITION
IN THE NE 1/4, SEC. 36, T3N, R16E, CITY OF
ELKHORN, WALWORTH COUNTY, WISCONSIN

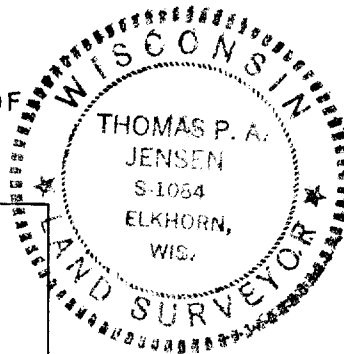

NOTE: USED CITY ENGINEERS RECORDS
FOR BLOCK LENGTHS

SURVEY AND PLAT BY
JENSEN & JOHNSON, INC.
CIVIL ENGINEERS AND SURVEYORS

Elkhorn, Wisconsin

LEGEND

- — Iron Pipe FOUND
- — Concrete Monument FOUND
- Scale 1" = 60'
- ⊕ — IRON ROD SET

WE CERTIFY: That we have surveyed the above described property and that the plat shown hereon is an accurate survey and a true representation thereof and correctly shows the exterior boundary lines and all divisions of said property.

Date AUG. 7, 1975

Thomas P. A. Jensen

~~LOYD L. JENSEN~~

Wisconsin Registered Land Surveyor, No. S-1084

1084

4D-66

4-134 Jx