


JEFFERSON ST.

NORTH BROAD ST.

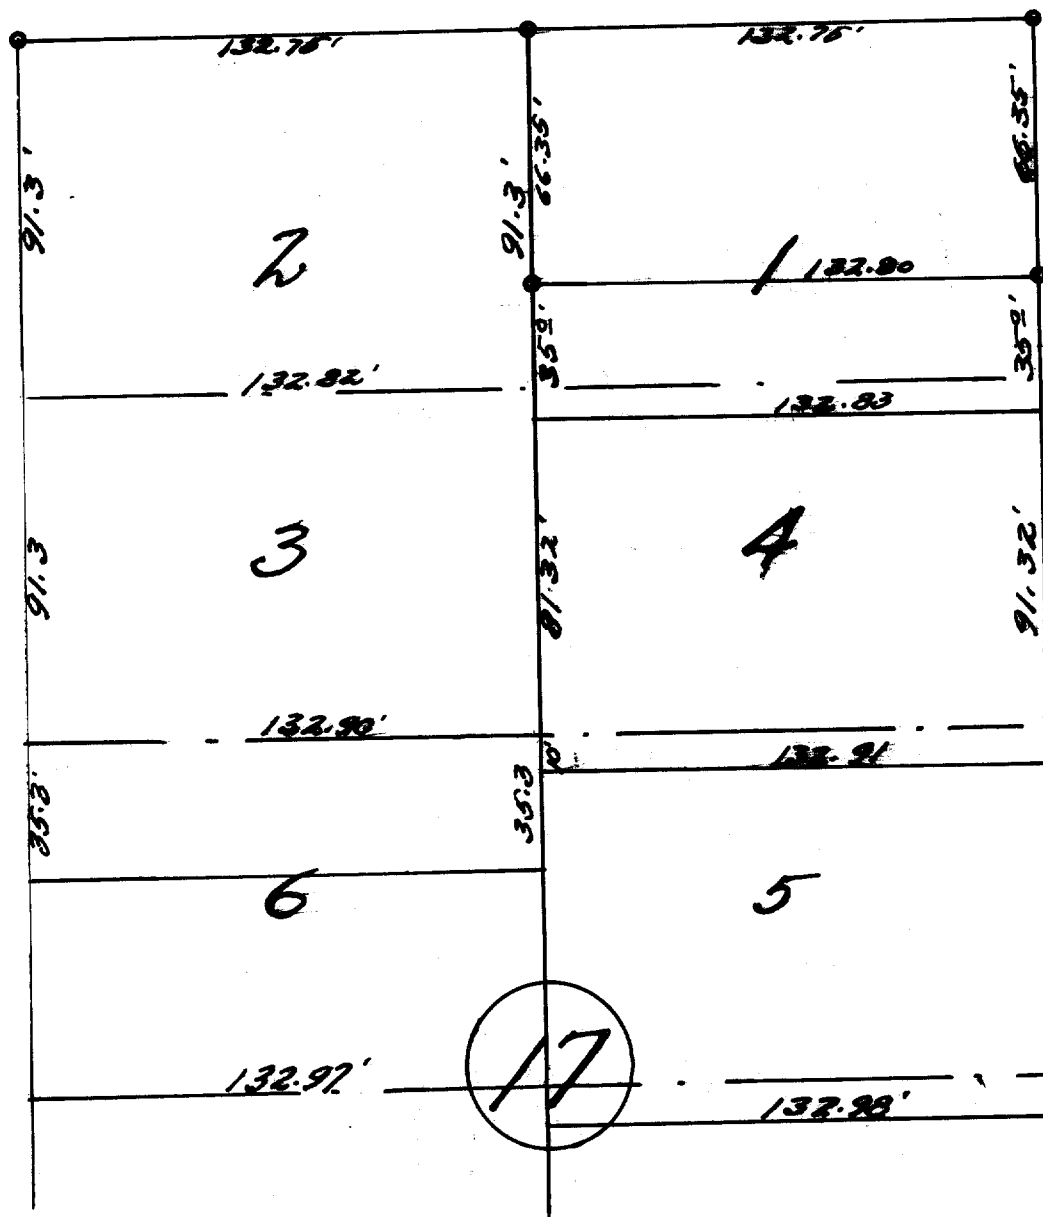

DESCRIPTION: The north 66.35 feet of Lot 1, Block 17 of the Original Plat of the City of Elkhorn, Walworth County, Wisconsin.

CERTIFICATE: I, hereby certify that I have on this the 4th day of April 1953 surveyed the above described property

Joseph M. Biagi
Joseph M. Biagi, City Engineer.
Elkhorn Wisconsin.

