


HAROLD H. KOLB
REGISTERED PROFESSIONAL LAND SURVEYOR
LAKE GENEVA, WISCONSIN

EAST GENEVA STREET

GETZEN STREET


PLAT OF SURVEY OF

A parcel of land located in the Northwest
1/4 of Section 6, T 2 N, R 17 E, City of
Elkhorn, Walworth County, Wisconsin.

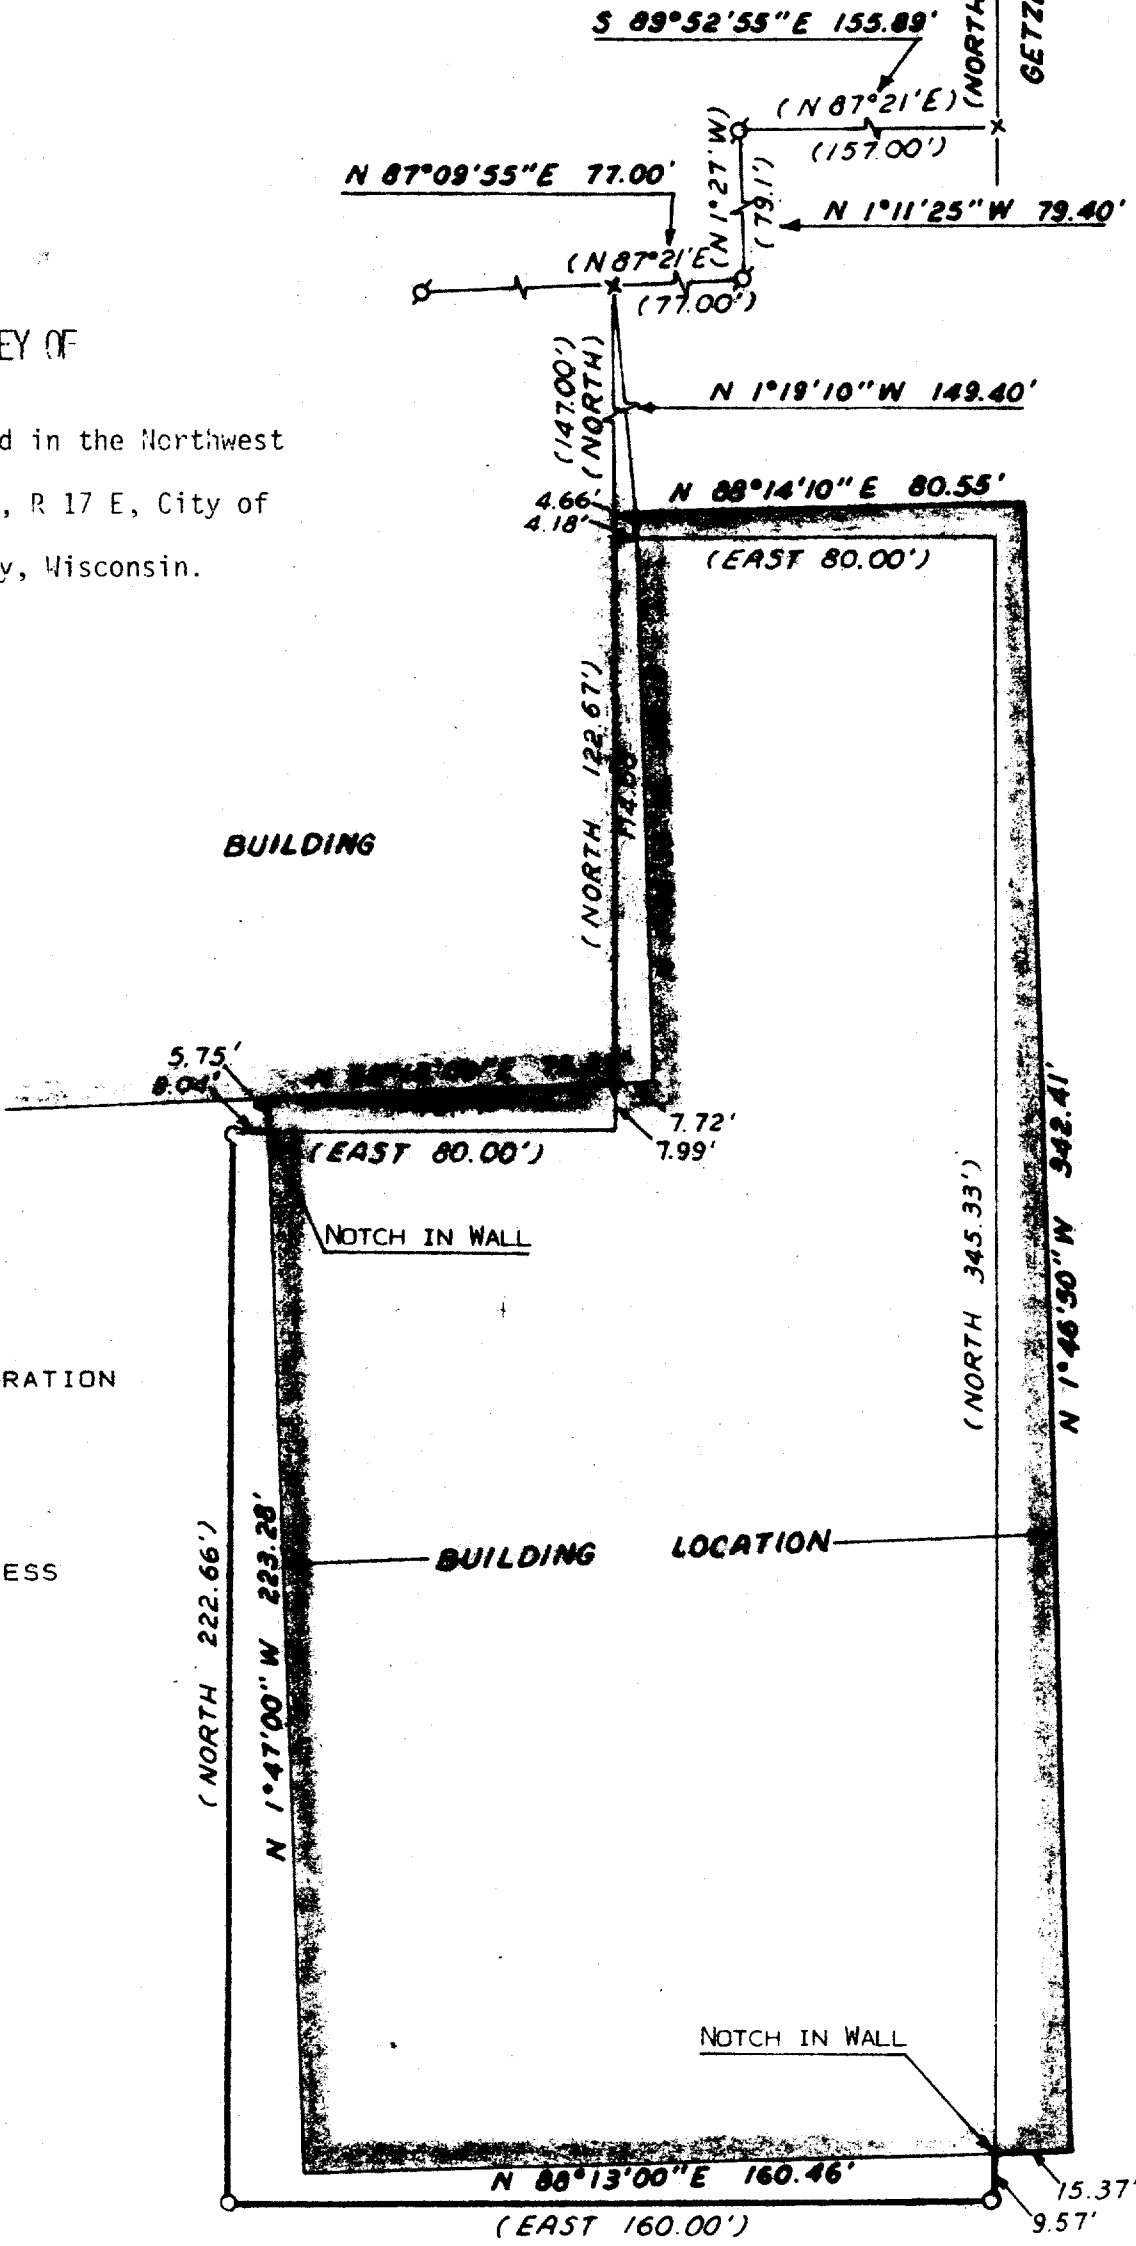

ORDERED BY: A.O. SMITH CORPORATION

ACCURACY: DISTANCE ± 0.01'
ANGLES ± 05"
ERROR OF CLOSURE LESS
THAN 1/3000

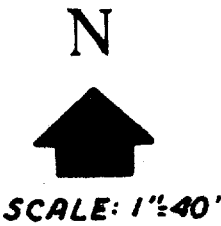

- LEGEND**
- φ — IRON PIPE FOUND
 - — IRON PIPE PLACED
 - — CONCRETE MONUMENT
 - x — SPIKE
 - () — DESCRIBED AS



I, HAROLD H. KOLB, DO HEREBY CERTIFY THAT I HAVE
SURVEYED THE PROPERTY HEREON DESCRIBED ACCORDING
TO THE OFFICIAL RECORDS, AND THAT THE PLAT HEREON
IS A CORRECT REPRESENTATION OF THE LOT LINES.

Harold H. Kolb
HAROLD H. KOLB
WISCONSIN REGISTERED LAND SURVEYOR, S-187
DATE Sept 26, 1975
REVISED: SEPTEMBER 30, 1975

4-1