

PLAT OF SURVEY

RSV ENGINEERING, INC
ENGINEERS, PLANNERS, SURVEYORS
CONSTRUCTION MANAGERS
ENVIRONMENTAL SCIENTISTS
801 MAIN STREET, WILKONAGO, WISCONSIN 53149 (262) 363-2004

FOR: MSI GENERAL

RECERT. DATE: 4/3/01



DESCRIPTION: LOT 2 OF CSM #2154 IN PART OF THE NW¹/₄ OF THE
NW¹/₄ OF SECTION 7, TOWN 2 NORTH, RANGE 17 EAST,
CITY OF ELKHORN, WALWORTH COUNTY, WISCONSIN.

LEGEND

R • FOUND IRON REBAR

CURVE DATA


NO.	ARC	DELTA	RADIUS	CHORD	BEARING
C1	229.59	24°58'08"	526.84	227.78	S76°16'24"W
C2	122.62	19°47'24"	355.00	122.01	S09°53'42"E

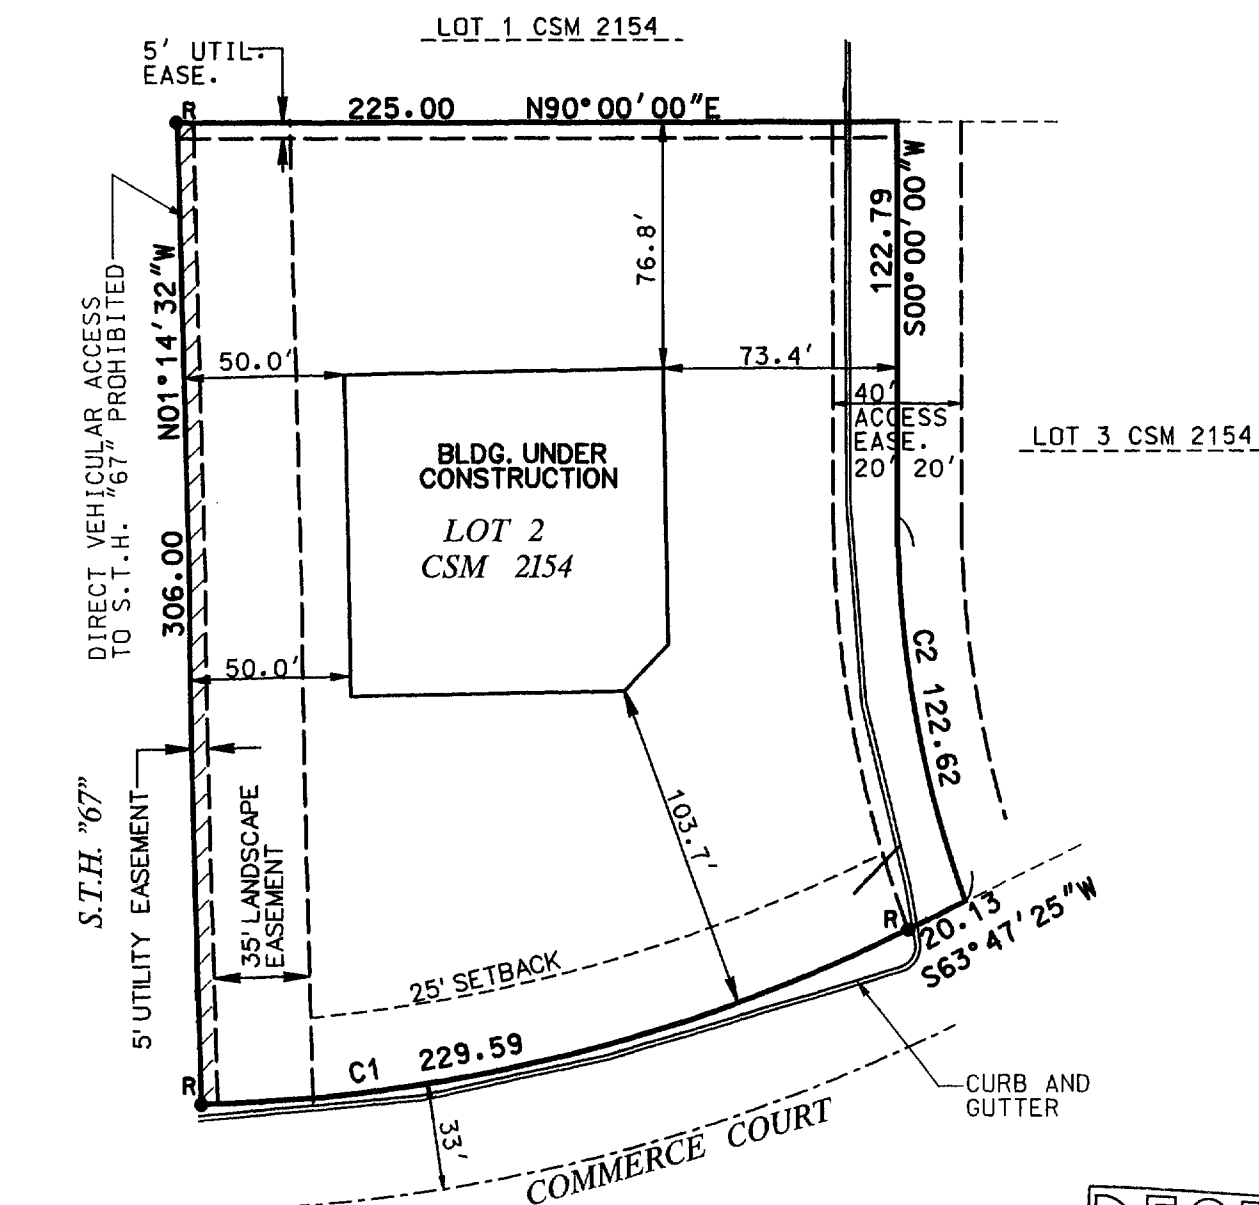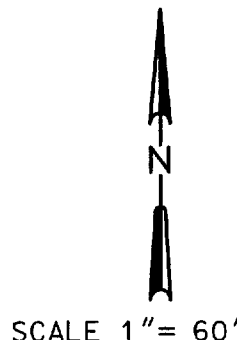

THE ABOVE MAP IS A TRUE REPRESENTATION THEREOF AND SHOWS THE SIZE AND LOCATION OF ALL THE PROPERTY, EXTERIOR BOUNDARIES, THE LOCATION OF ALL VISIBLE BOUNDARY FENCES, APPARENT EASEMENTS, ROADWAYS AND VISIBLE ENCROACHMENTS, IF ANY.

THIS SURVEY IS MADE FOR THE USE OF THE PRESENT OWNERS OF THE PROPERTY, AND ALSO THOSE WHO PURCHASE, MORTGAGE OR GUARANTEE TITLE THERETO WITHIN ONE (1) YEAR FROM DATE HERETO.

BRADFORD L. SPENCER, R.L.S. 2069
RSV#00199PLT

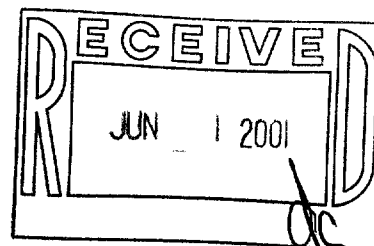

THIS IS ORIGINAL
COPY ONLY IF
NOT REPRODUCED

VA-2154-2

004-1371