


N
SCALE-1"=20'
O=IRON PIPE

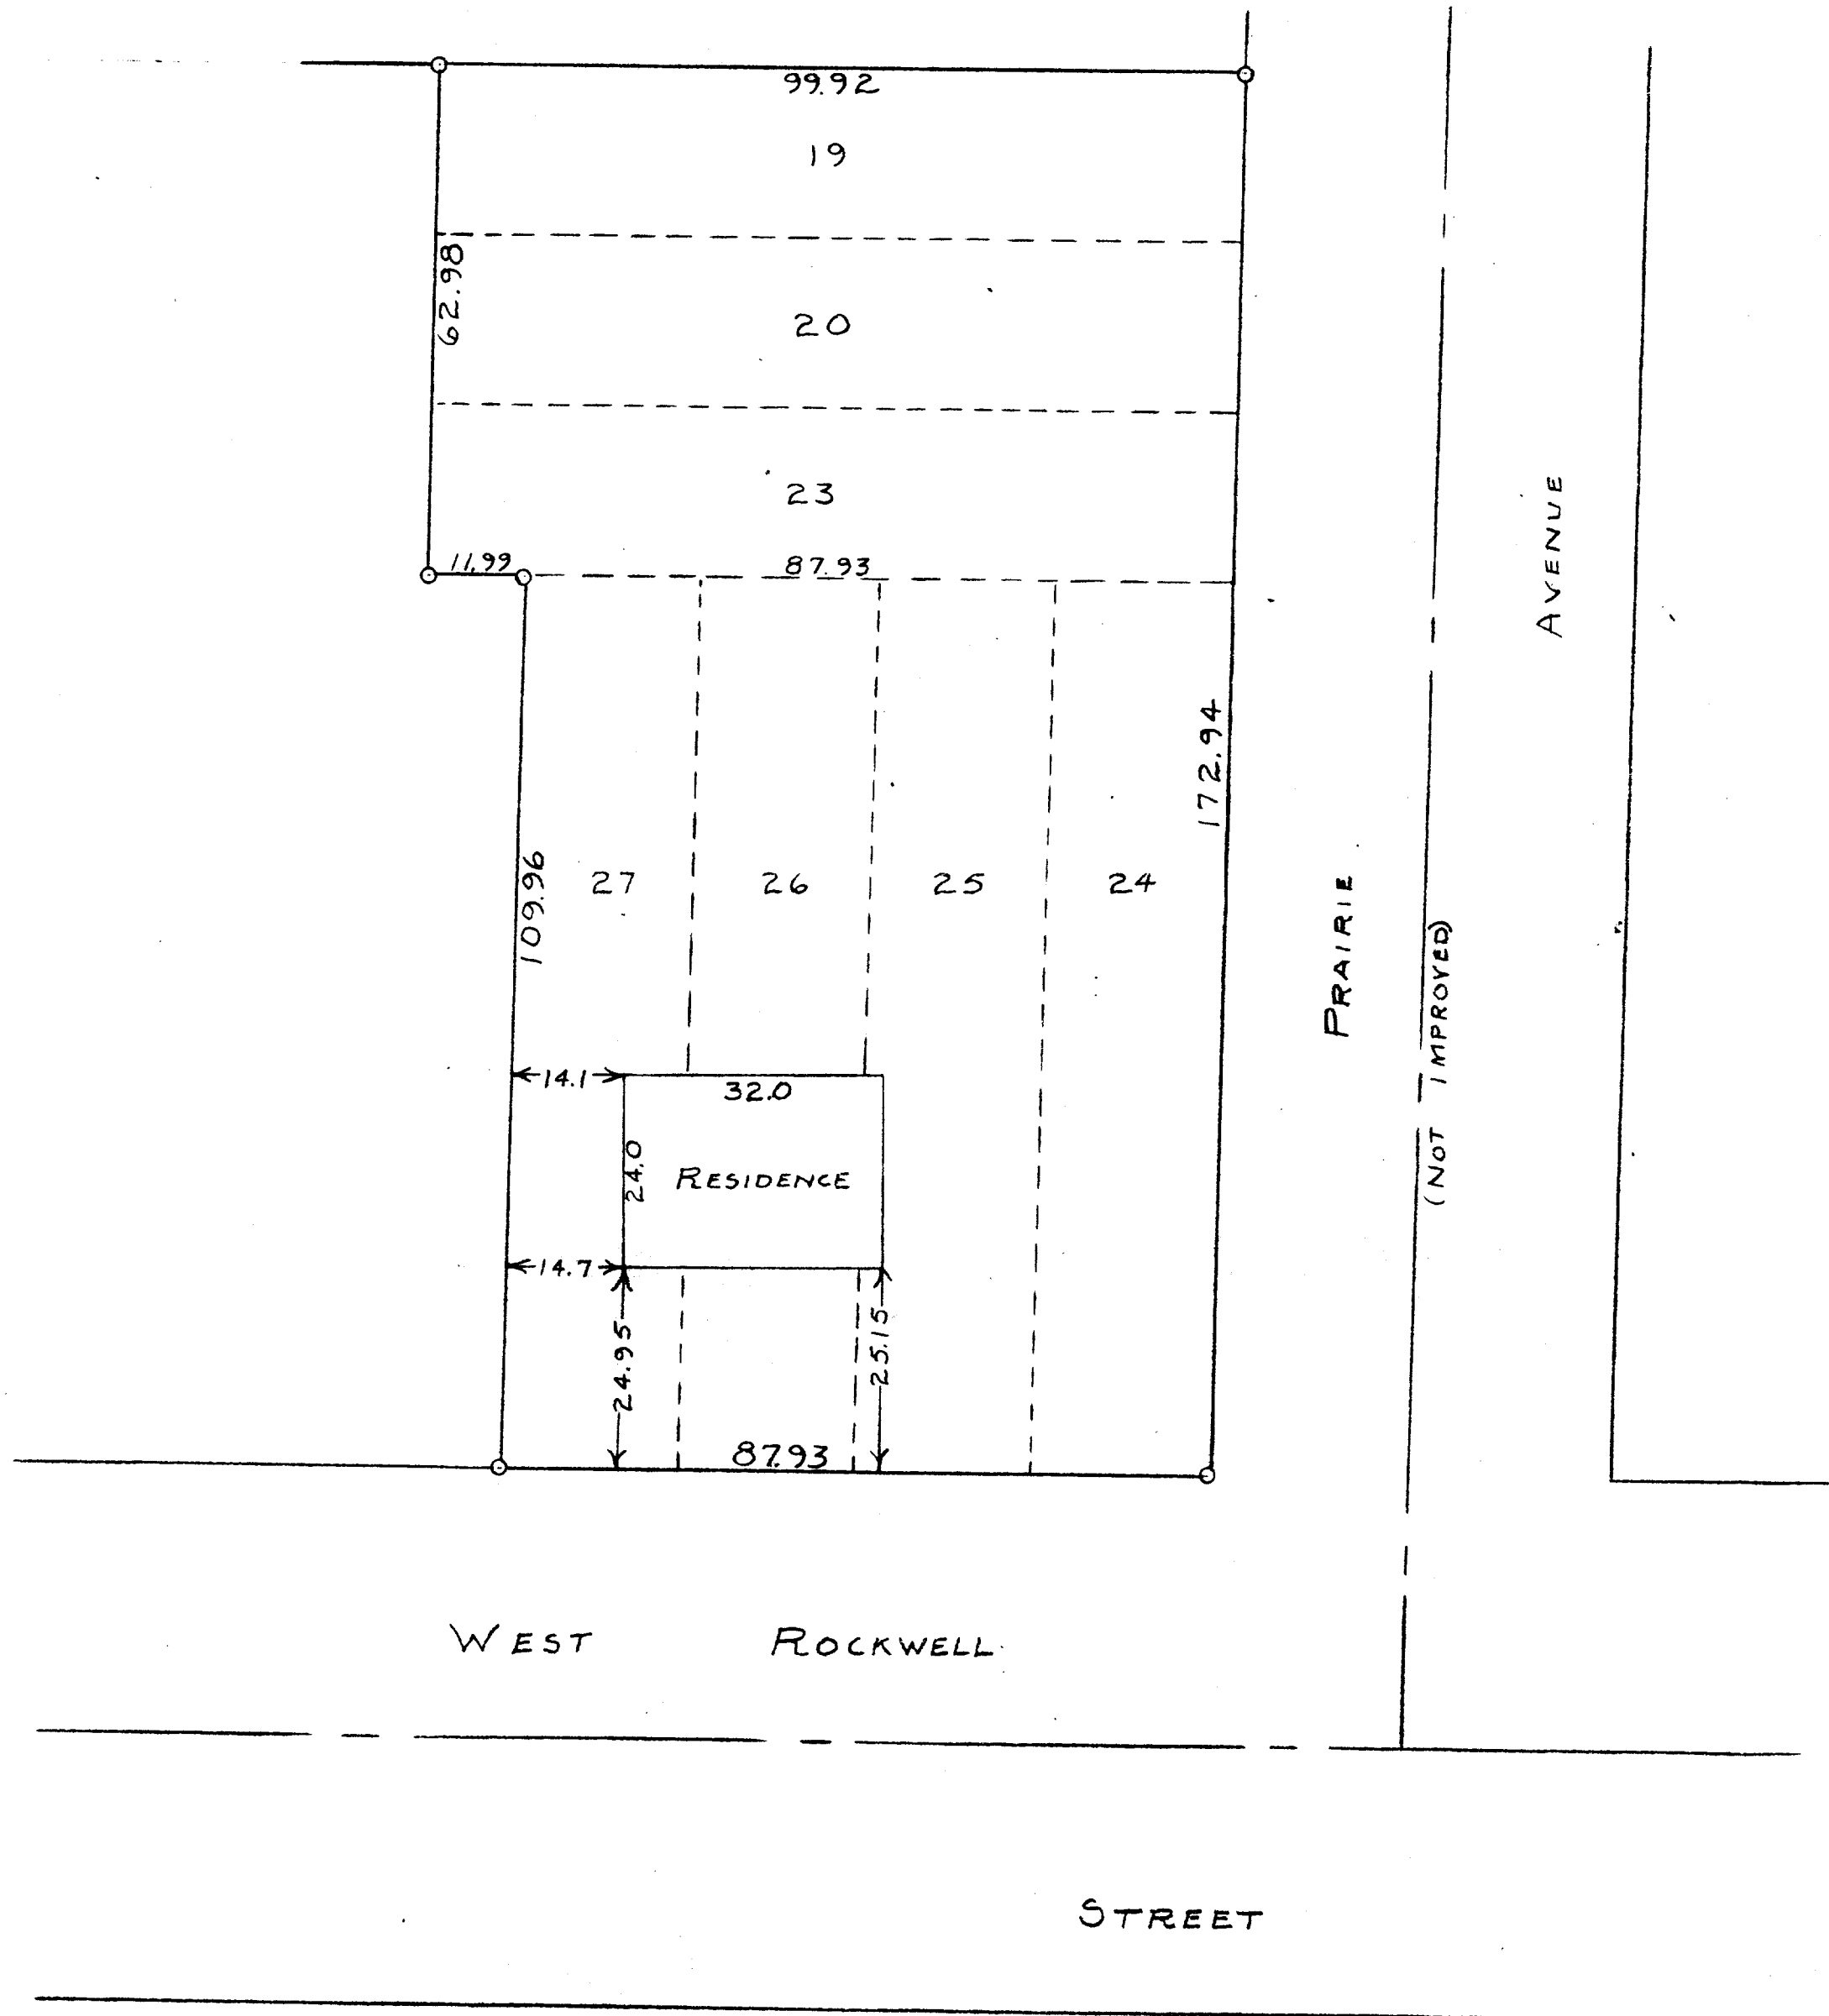

STATE OF WISCONSIN)
WALWORTH COUNTY)

I, GEORGE T. DUNHAM, DO HEREBY CERTIFY THAT I HAVE SURVEYED THE PROPERTY DESCRIBED AS FOLLOWS:

LOTS 19, 20, 23, 24, 25, 26, AND 27, BLOCK 3 OF ELKHORN GARDENS IN THE CITY OF ELKHORN, WALWORTH COUNTY, WISCONSIN.
AND THE PLAT SHOWN ABOVE IS A CORRECT REPRESENTATION OF THE PROPERTY LINES AND OF THE IMPROVEMENTS LOCATED THEREON
SEPT. 16, 1958

George T. Dunham
GEORGE T. DUNHAM, SURVEYOR 4-14
DELAVER, WISCONSIN

VEN-21.23