
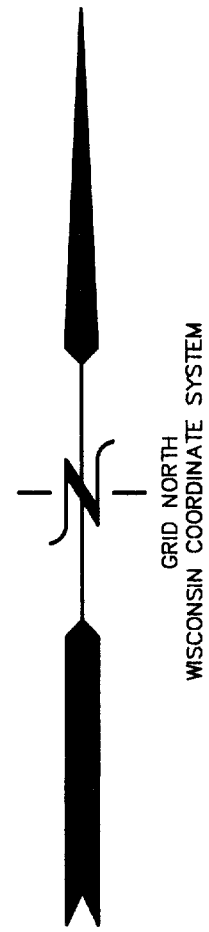


ASBUILT SURVEY
LOT 1 OF C.S.M. 3189
LOCATED IN THE SW 1/4
OF THE NW 1/4 OF SEC. 7
TOWN 2 NORTH, RANGE 17 EAST
CITY OF ELKHORN, WALWORTH COUNTY, WI.

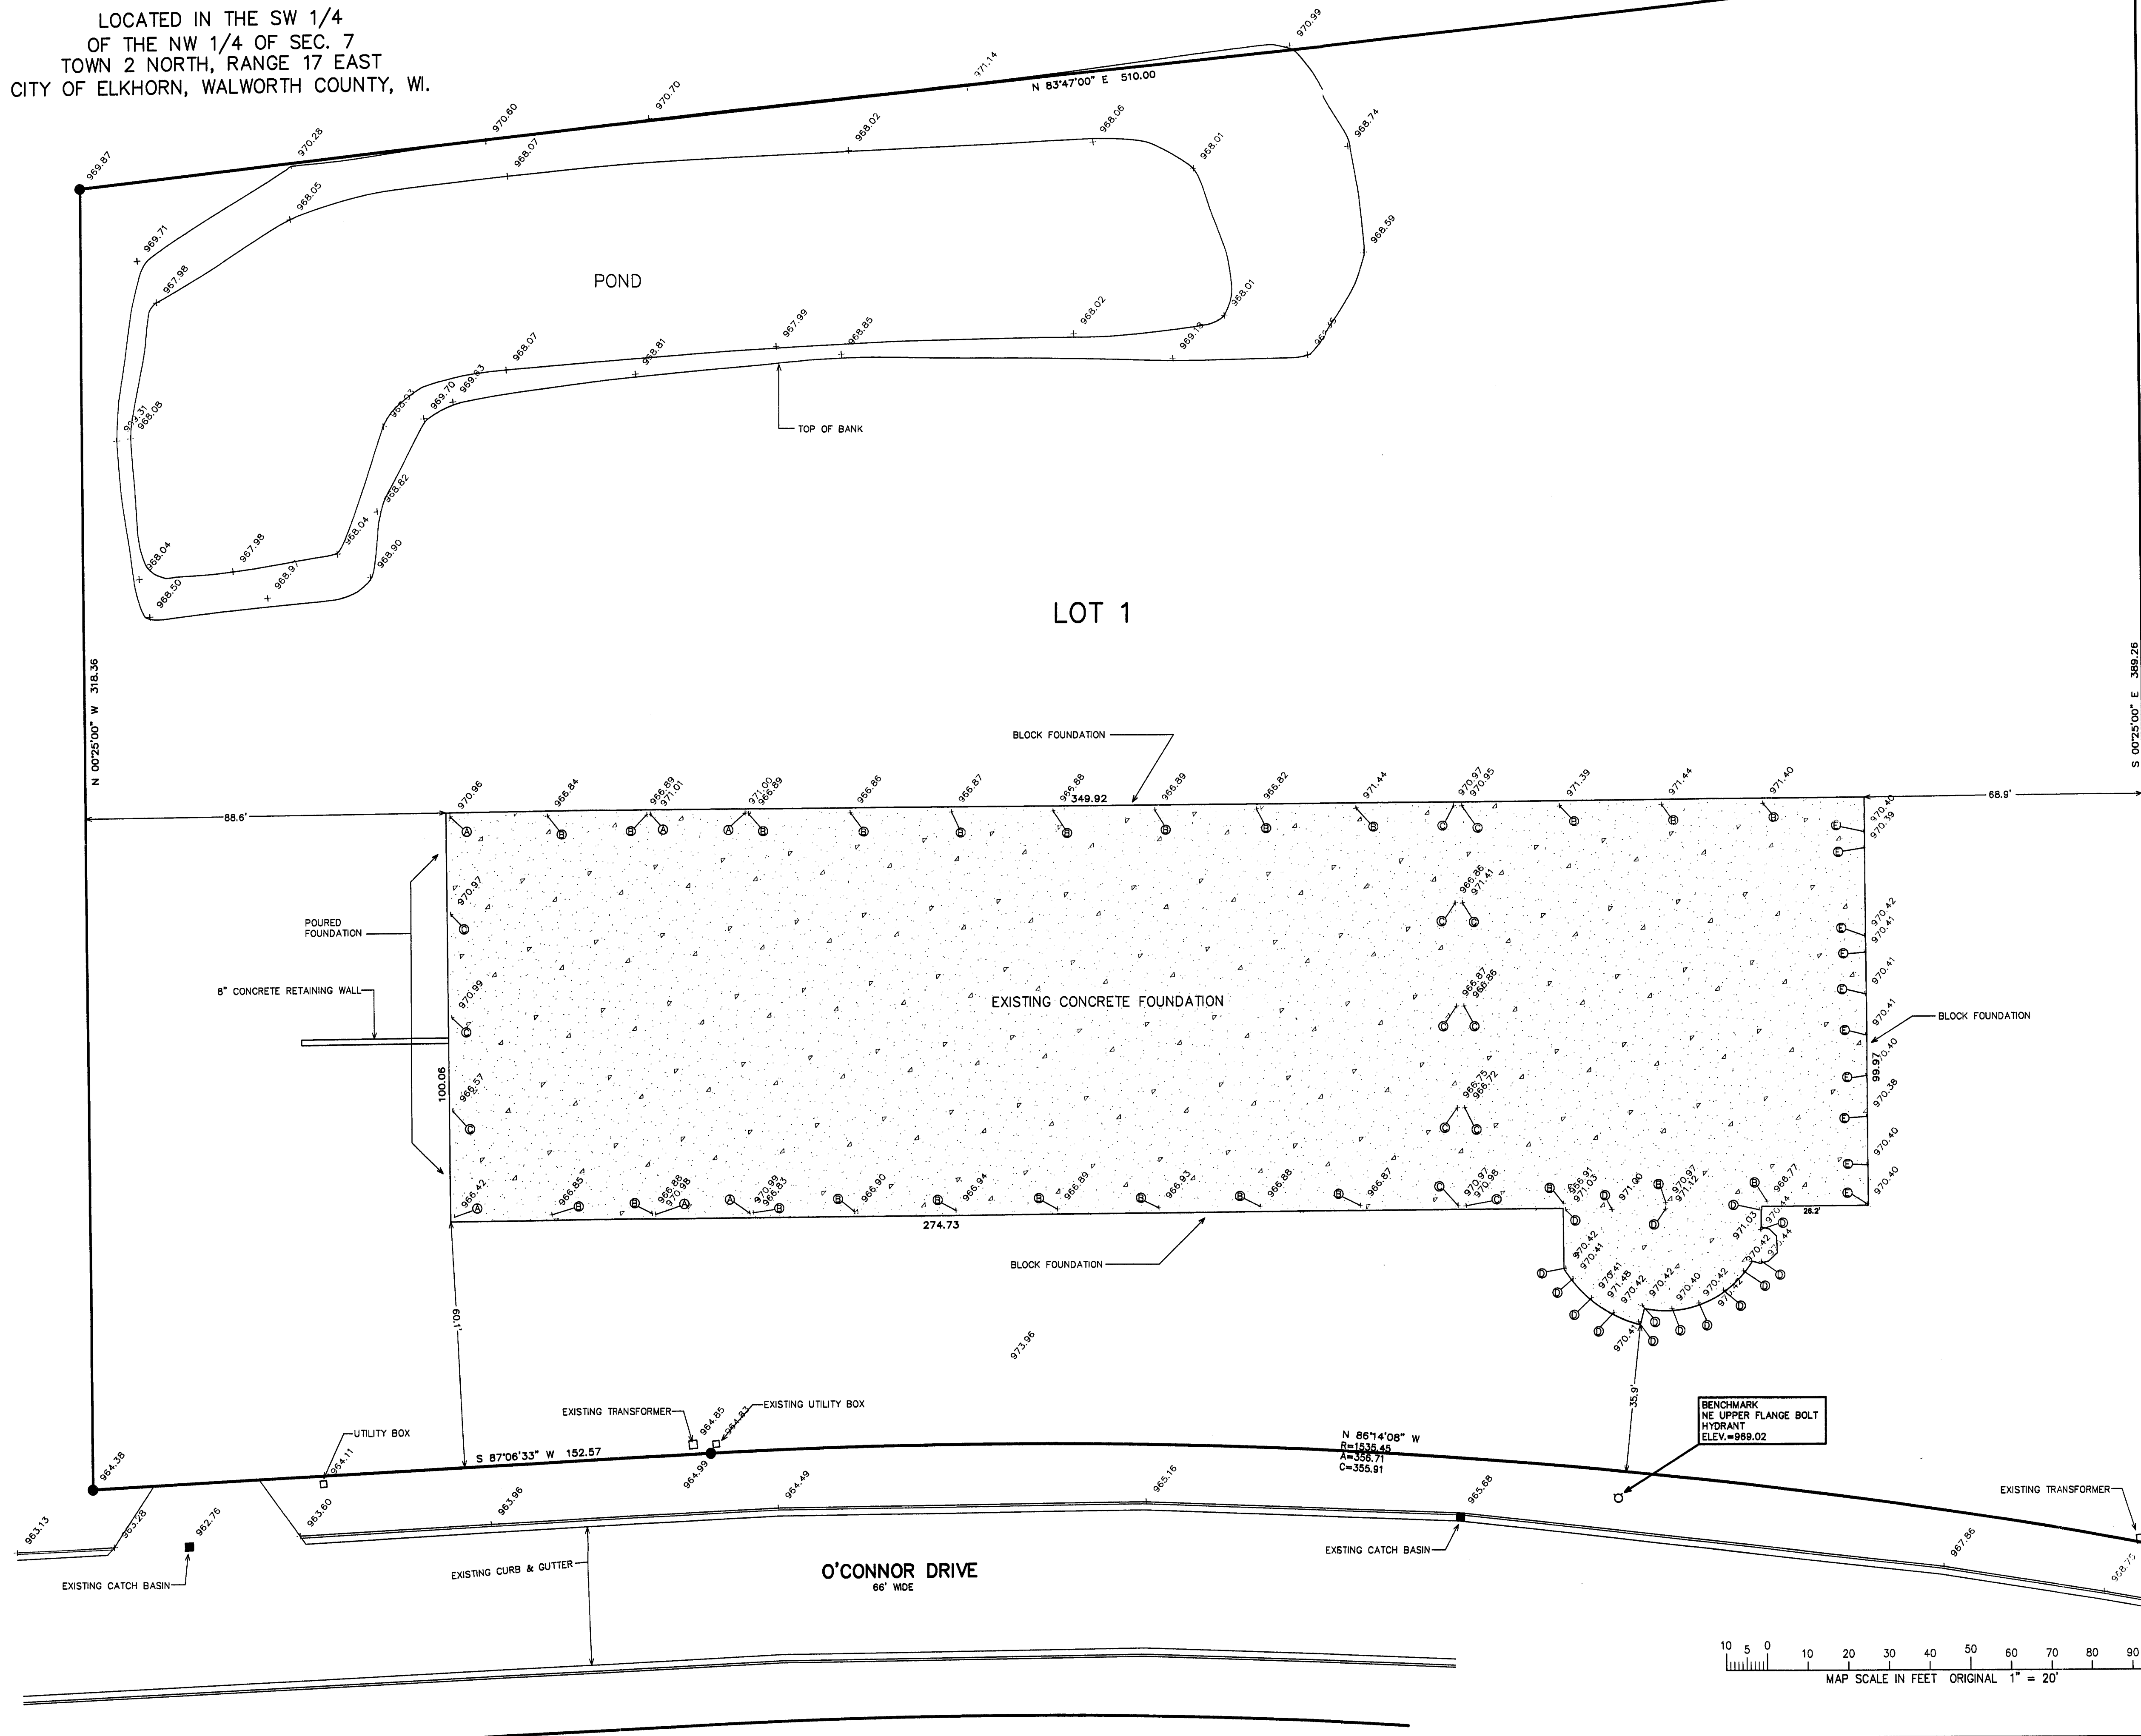




- LEGEND
- = FOUND IRON REBAR STAKE
 - ⊙ = EXISTING 4"x4" ANCHOR BOLT SETTING:
LOCATION OF SHOT
 - ⊕ = EXISTING 4"x6" ANCHOR BOLT SETTING:
LOCATION OF SHOT
 - ⊗ = EXISTING 4" ANCHOR BOLT SETTING:
LOCATION OF SHOT
 - ⊖ = EXISTING 5"x5" ANCHOR BOLT SETTING:
LOCATION OF SHOT
 - ⊙ = EXISTING 7" ANCHOR BOLT SETTING:
LOCATION OF SHOT

NOTE: COPIES OF THIS MAP TO WHICH THE FOLLOWING CERTIFICATE WILL APPLY SHOW SURVEYOR'S ORIGINAL SEAL AND SIGNATURE IN RED INK. COPIES BY ANY OTHER MEANS MAY HAVE ALTERATIONS WHICH DO NOT REPRESENT THE SURVEYOR'S WORK PRODUCT.

I HEREBY CERTIFY THAT THE ABOVE DESCRIBED PROPERTY HAS BEEN SURVEYED UNDER MY DIRECTION AND THAT THE ABOVE MAP IS A TRUE REPRESENTATION THEREOF AND SHOWS THE SIZE AND LOCATION OF THE PROPERTY AND ITS EXTERIOR BOUNDARIES. THIS SURVEY IS MADE FOR THE USE OF THE PRESENT OWNERS OF THE PROPERTY, AND ALSO THOSE WHO PURCHASE, MORTGAGE, OR GUARANTEE THE TITLE THERETO WITHIN ONE YEAR FROM THE DATE HEREOF.

DATED: 10/2/01

PETER S. GORDON R.L.S. 2101

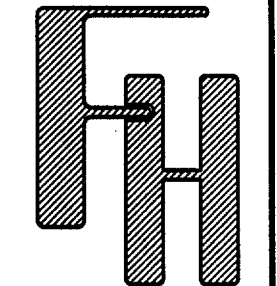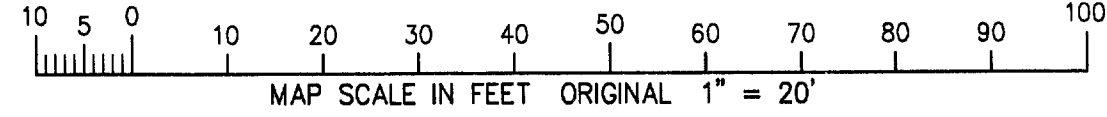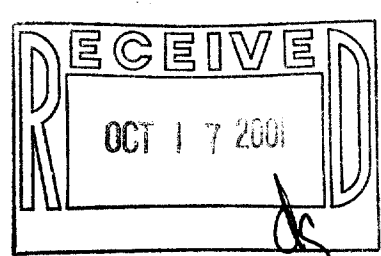

ASBUILT PLAN
LOT 1 OF CSM 3189
CITY OF ELKHORN
WALWORTH COUNTY, WISCONSIN

PREPARED FOR -
MSI GENERAL
230 E. O'CONNOR DR.
ELKHORN, WI. 53121

FARRIS, HANSEN & ASSOCIATES, INC.
ENGINEERING - ARCHITECTURE - SURVEYING
7 RIDGWAY COURT P.O. BOX 437
ELKHORN, WISCONSIN 53121
OFFICE: (262) 723-2098 FAX: (262) 723-5886

REVISIONS

PROJECT NO.
5574
DATE
10/04/01
SHEET NO.
1 OF 1

024-1416