


FARRIS, HANSEN, & ASSOCIATES, INC.
ENGINEERING, ARCHITECTURE, SURVEYING
7 RIDGWAY COURT — P.O. BOX 437, ELKHORN, WISCONSIN, 53121
PHONE: (414) 723-2098 FAX: (414) 723-5886
PLAT OF SURVEY

**LOT 3 OF BLOCK 1, EXCEPT THE EAST 8 FEET
HODGE'S ADDITION**

LOCATED IN THE CITY OF ELKHORN
WALWORTH COUNTY, WISCONSIN

— WORK ORDERED BY —
JOE WELCH
20 RANDALL STREET
ELKHORN, WI. 53121

- = FOUND IRON REBAR STAKE
- * = FOUND BOLT
- = FOUND IRON PIPE STAKE
- = SET IRON REBAR STAKE

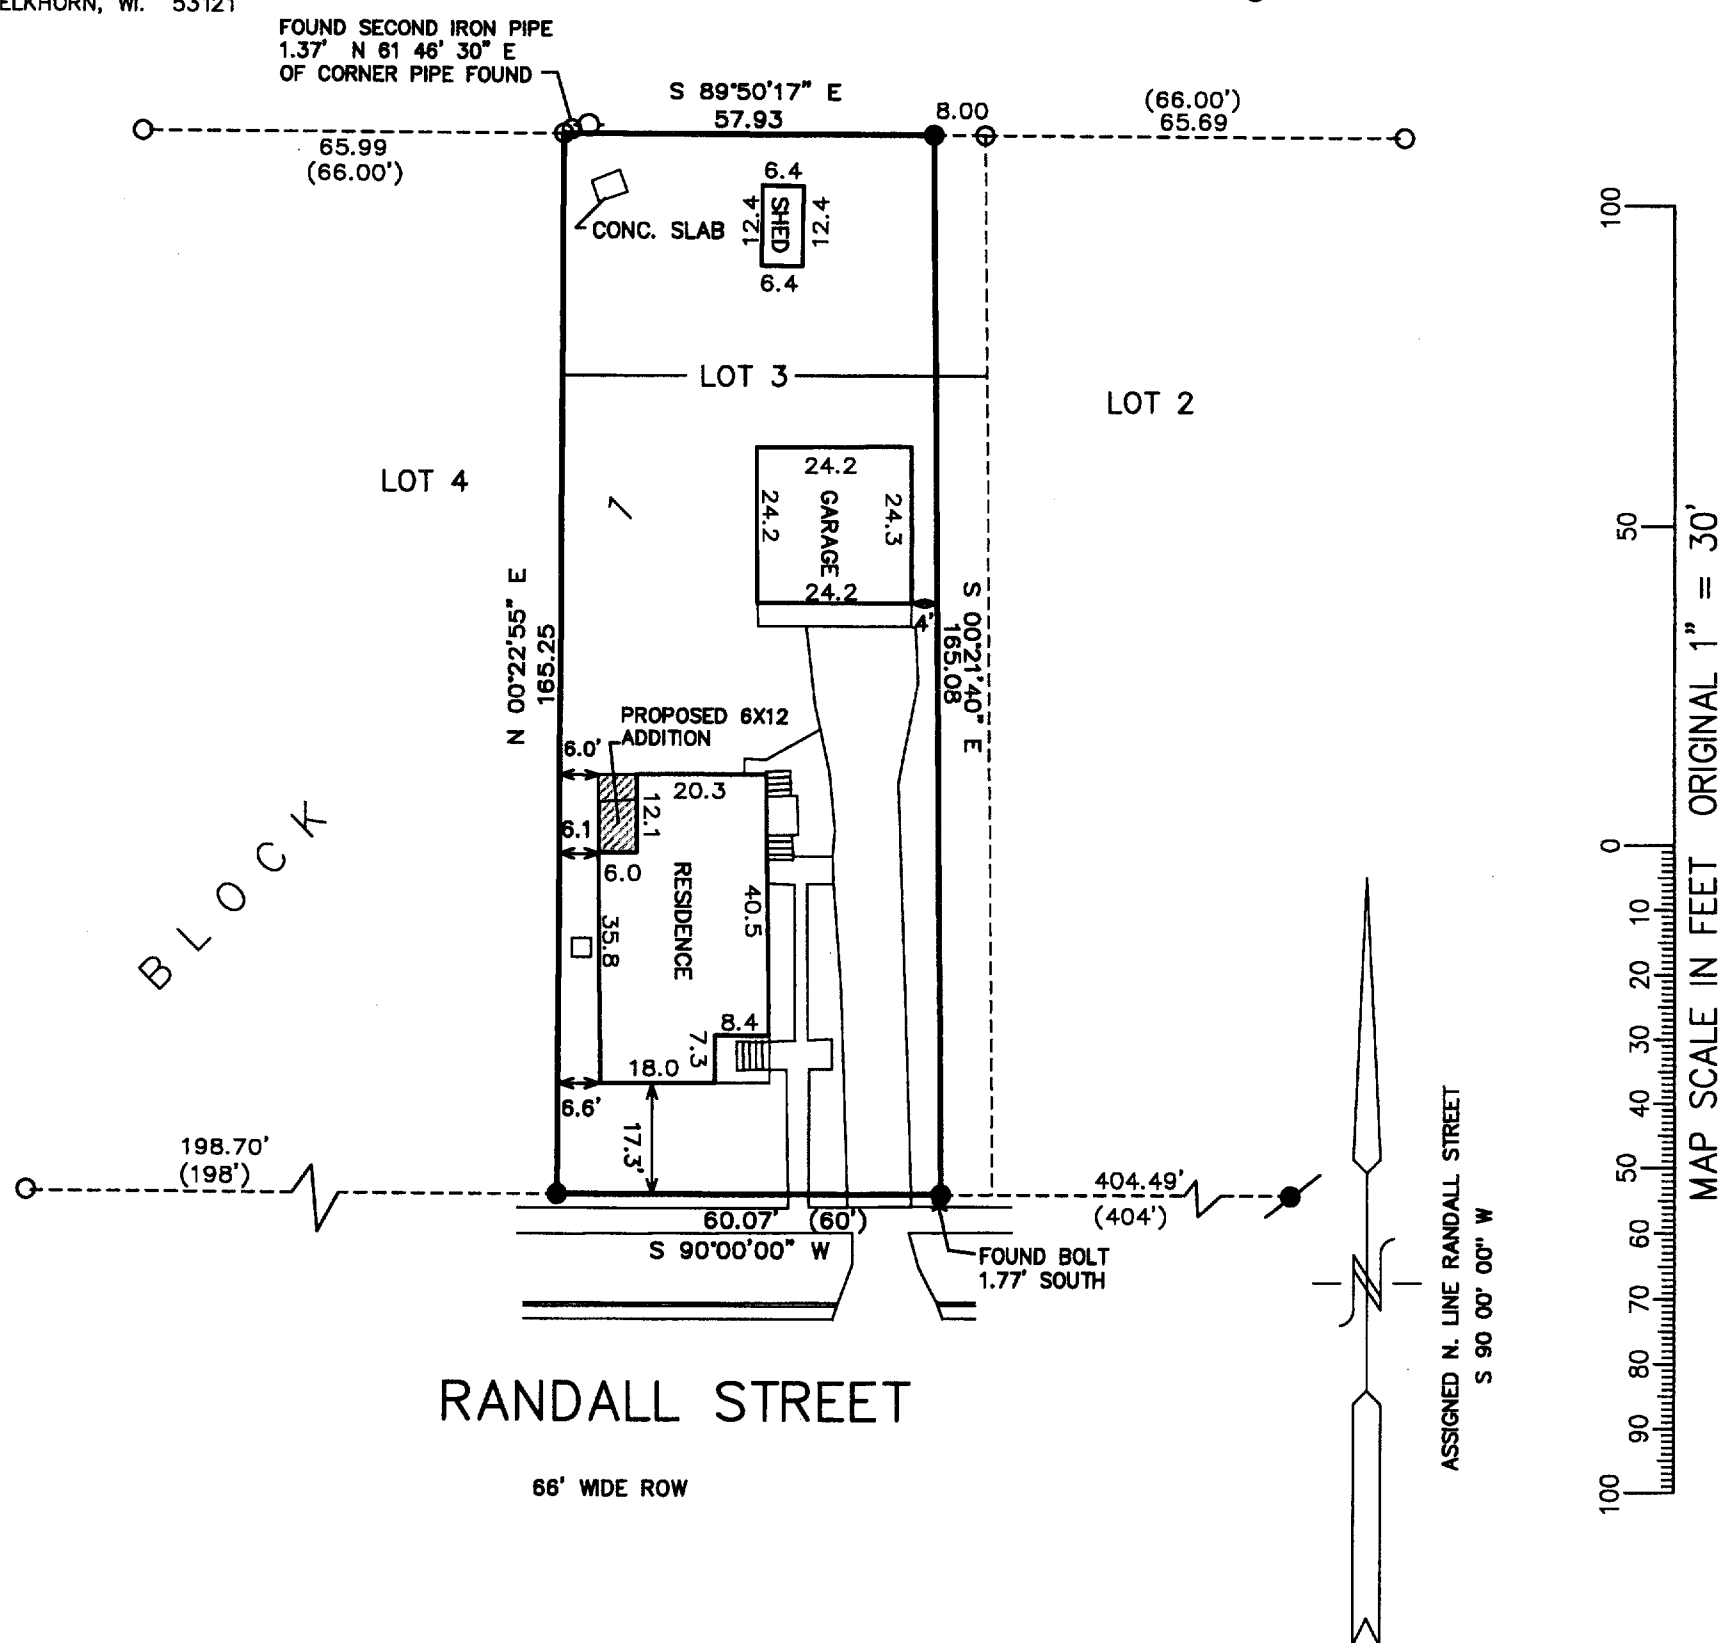


NOTE: COPIES OF THIS MAP TO WHICH THE FOLLOWING CERTIFICATE WILL APPLY SHOW
SURVEYOR'S ORIGINAL SEAL AND SIGNATURE IN RED INK. COPIES BY ANY OTHER MEANS MAY HAVE ALTERATIONS
WHICH DO NOT REPRESENT THE SURVEYOR'S WORK PRODUCT.

I HEREBY CERTIFY THAT THE ABOVE DESCRIBED PROPERTY HAS BEEN SURVEYED UNDER MY DIRECTION AND THAT THE
ABOVE MAP IS A TRUE REPRESENTATION THEREOF AND SHOWS THE SIZE AND LOCATION OF THE PROPERTY AND ITS
EXTERIOR BOUNDARIES. THIS SURVEY IS MADE FOR THE USE OF THE PRESENT OWNERS OF THE PROPERTY, AND
ALSO THOSE WHO PURCHASE, MORTGAGE, OR GUARANTEE THE TITLE THERETO WITHIN ONE YEAR FROM THE DATE
HEREOF.

DATED: Nov. 6, 2001

PETER S. GORDON R.L.S. 2101

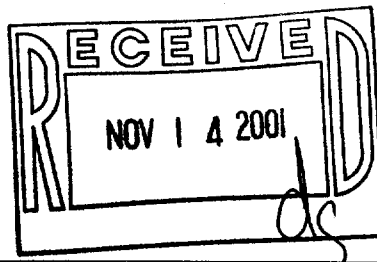

PROJECT 5915
DATE: 11-05-2001
SHEET 1 OF 1

YHO-2A ✓ 004-1421

NOV 14 2001