
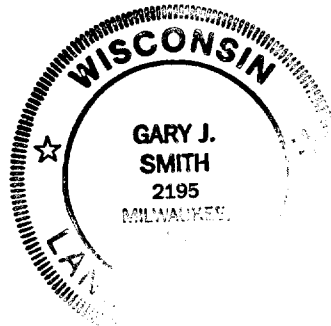


"RECERTIFICATION"
Plat of Survey


Survey For: WOLTER BROS. BUILDERS
Location: 214 PARK STREET

HQMAN

Description: LOT 15 ALDER SUBDIVISION, located in the Northwest 1/4, Southwest 1/4, and the Southeast 1/4 of the Northwest 1/4 of Section 1, Town 2 North, Range 16 East, and the Southwest 1/4 of the Southwest 1/4 of Section 36, Town 2 North, Range 16 East, City of Elkhorn, Walworth County, Wisconsin.

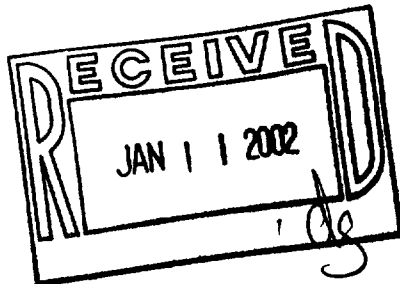

VACANT

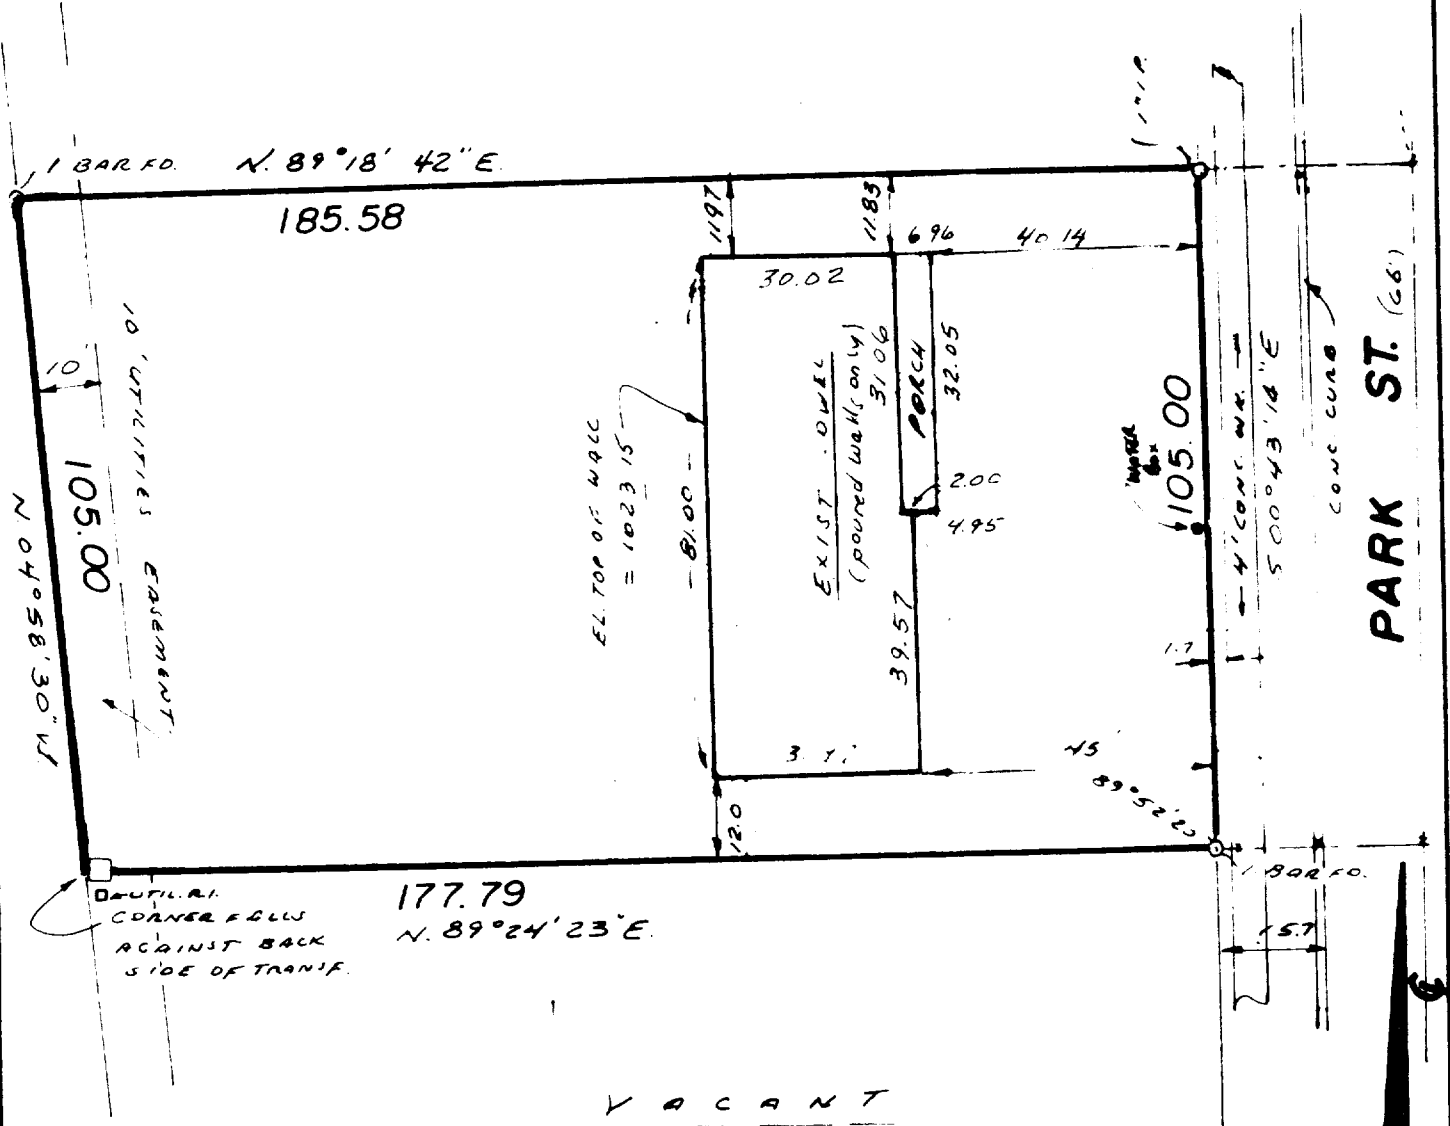

**INTERLINE SURVEY
SERVICES, INC.**
11221 W. FOREST HOME AVE
HALES CORNERS, WISCONSIN 53130
PHONE 425-2060

SURVEY CERTIFICATE

Scale: 1" = 30'

State of Wisconsin) ss
Milwaukee County

We, Interline Survey Services, Inc., certify that we have surveyed the above described property and the above map is a true representation thereof, and shows the size and location of the property, its exterior boundaries, the location and dimensions of all visible structures thereon, fences, apparent easements and roadways and visible encroachments, if any.

This survey is made for the exclusive use of the present owners of the Property, and also those who purchase, mortgage, or guarantee the title thereto, within one (1) year from date hereof.

Gary J. Smith

Wisconsin Registered Land Surveyor

Date: 8-18-00
Job No.: 27777

VALD-151

004-1427

Plat of Survey

Survey For: WOLTER BROS. BUILDERS
Location: PARK STREET


HOMAN

Description: LOT 15 ALDER SUBDIVISION, located in the Northwest 1/4, Southwest 1/4, and the Southeast 1/4 of the Northwest 1/4 of Section 1, Town 2 North, Range 16 East, and the Southwest 1/4 of the Southwest 1/4 of Section 36, Town 3 North, Range 16 East, City of Elkhorn, Walworth County, Wisconsin.

PROPOSED FINISHED YARD GRADE = 1022.5



DROP GARAGE FLOOR
1 COURSE

SLAB = 1022.1

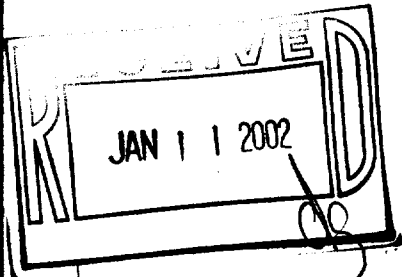

VACANT

5' N. 1/4, 1/4, 1/4
R. 14 = 1019.16
8" N. 1/4 = 1019.22

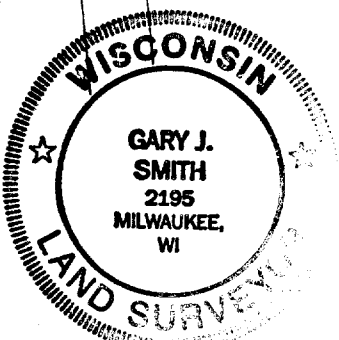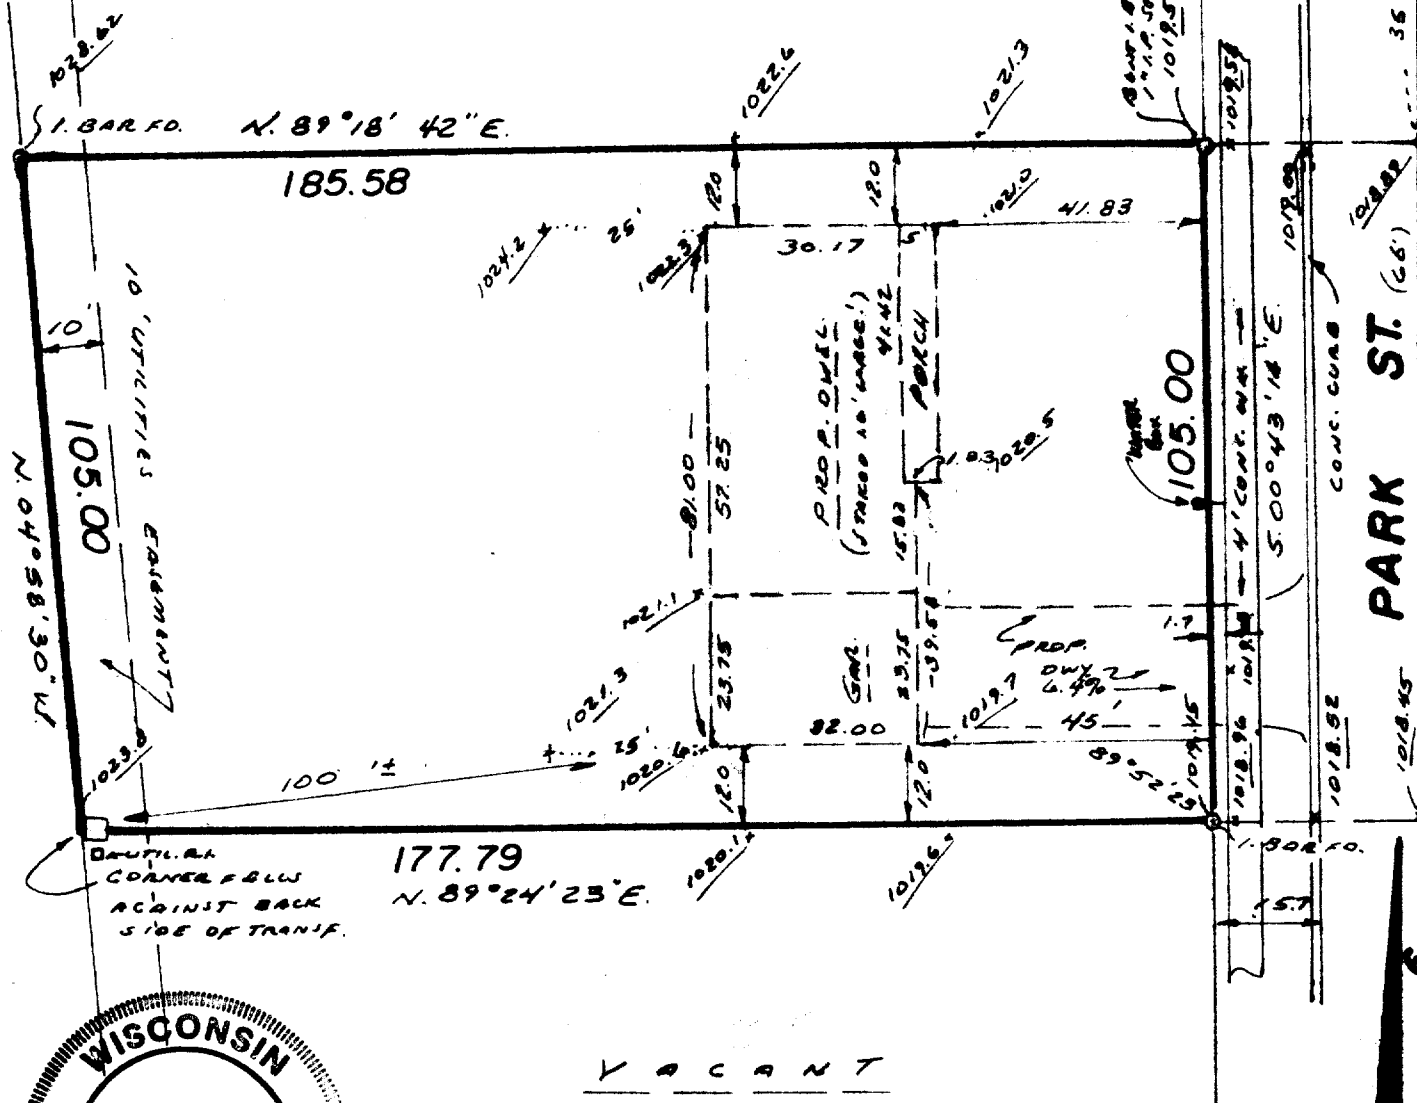

INTERLINE SURVEY
SERVICES, INC.
11221 W. FOREST HIDE AVE
MILWAUKEE, WISCONSIN 53130
PHONE 429-3860

SURVEY CERTIFICATE

Scale: 1" = 30'

State of Wisconsin)
Milwaukee County ss

We, Interline Survey Services, Inc., certify that we have surveyed the above described property and the above map is a true representation thereof, and shows the size and location of the property, its exterior boundaries, the location and dimensions of all visible structures thereon, fences, apparent easements and roadways and visible encroachments, if any.

This survey is made for the exclusive use of the present owners of the Property, and also those who purchase, mortgage, or guarantee the title thereto, within one (1) year from date hereof.

Gary J. Smith
Wisconsin Registered Land Surveyor

Rev. 7.7-00
Date: 6-27-00
Job No.: 27677