


PLAT OF SURVEY

OF

LOT 6 BLK 4 FAIRLANE SUB. ADD'N NO. 1
LOCATED IN THE NW 1/4 OF SEC. 31, T3N,
R1E, CITY OF ELKHORN, WALWORTH CO.
WISCONSIN

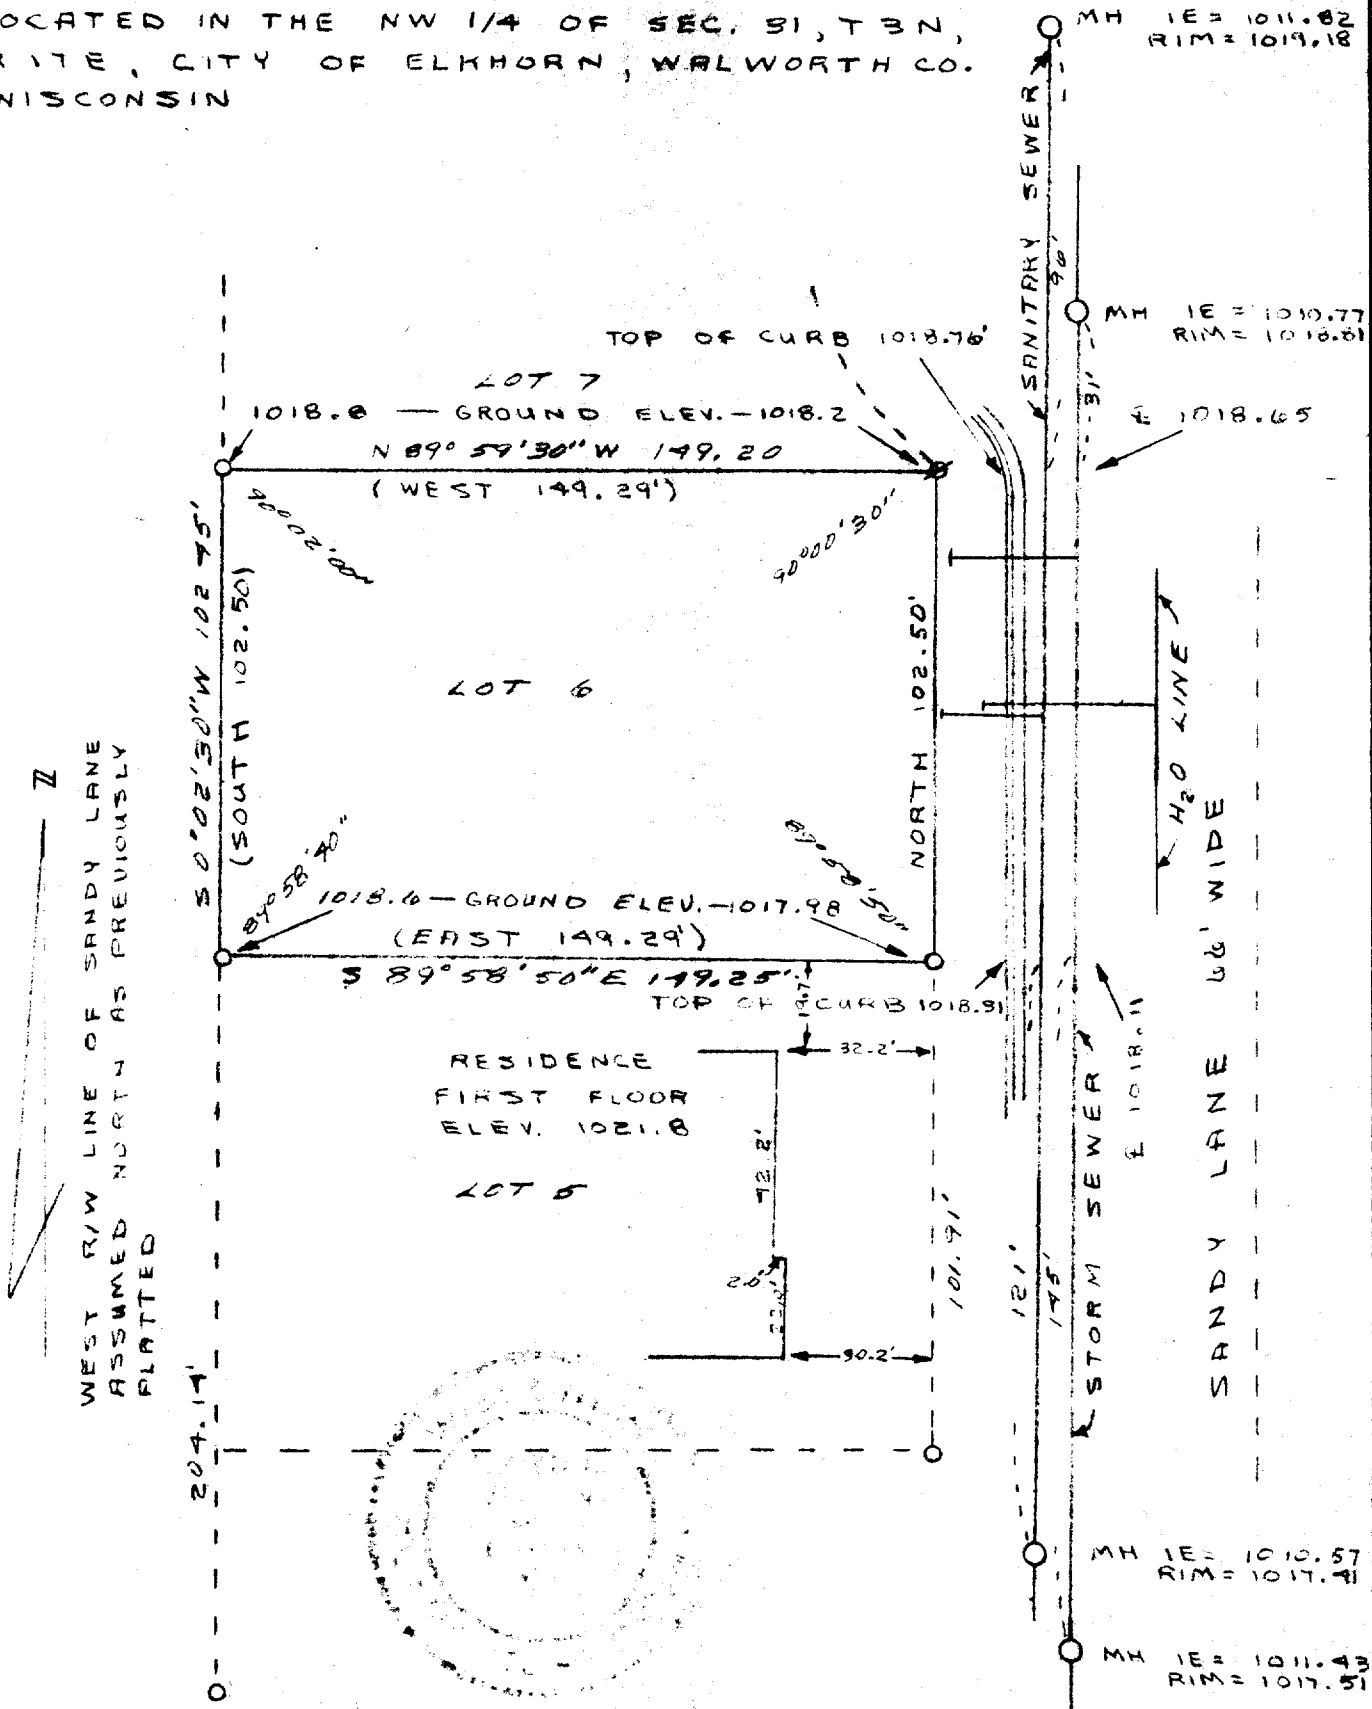

LATERAL LOCATIONS

SANITARY — 51' S OF N LOT COR.
STORM — 18' S OF N LOT COR.
H₂O — 51' S OF N LOT COR.

SURVEY AND PLAT BY

JENSEN & JOHNSON, INC.
CIVIL ENGINEERS AND SURVEYORS

Elkhorn, Wisconsin

LEGEND

- — Iron Pipe FOUND 1½" O.D.
- — Concrete Monument
- Scale 1" = 40'
- ⊕ — IRON PIPE FOUND 2½" O.D.

WE CERTIFY: That we have surveyed the above described property and that the plat shown hereon is an accurate survey and a true representation thereof and correctly shows the exterior boundary lines and all divisions of said property.

Date MARCH 8, 1976

Lloyd L. Jensen
LLOYD L. JENSEN,

Wisconsin Registered Land Surveyor, No. S-211

(RECORDED AS)