
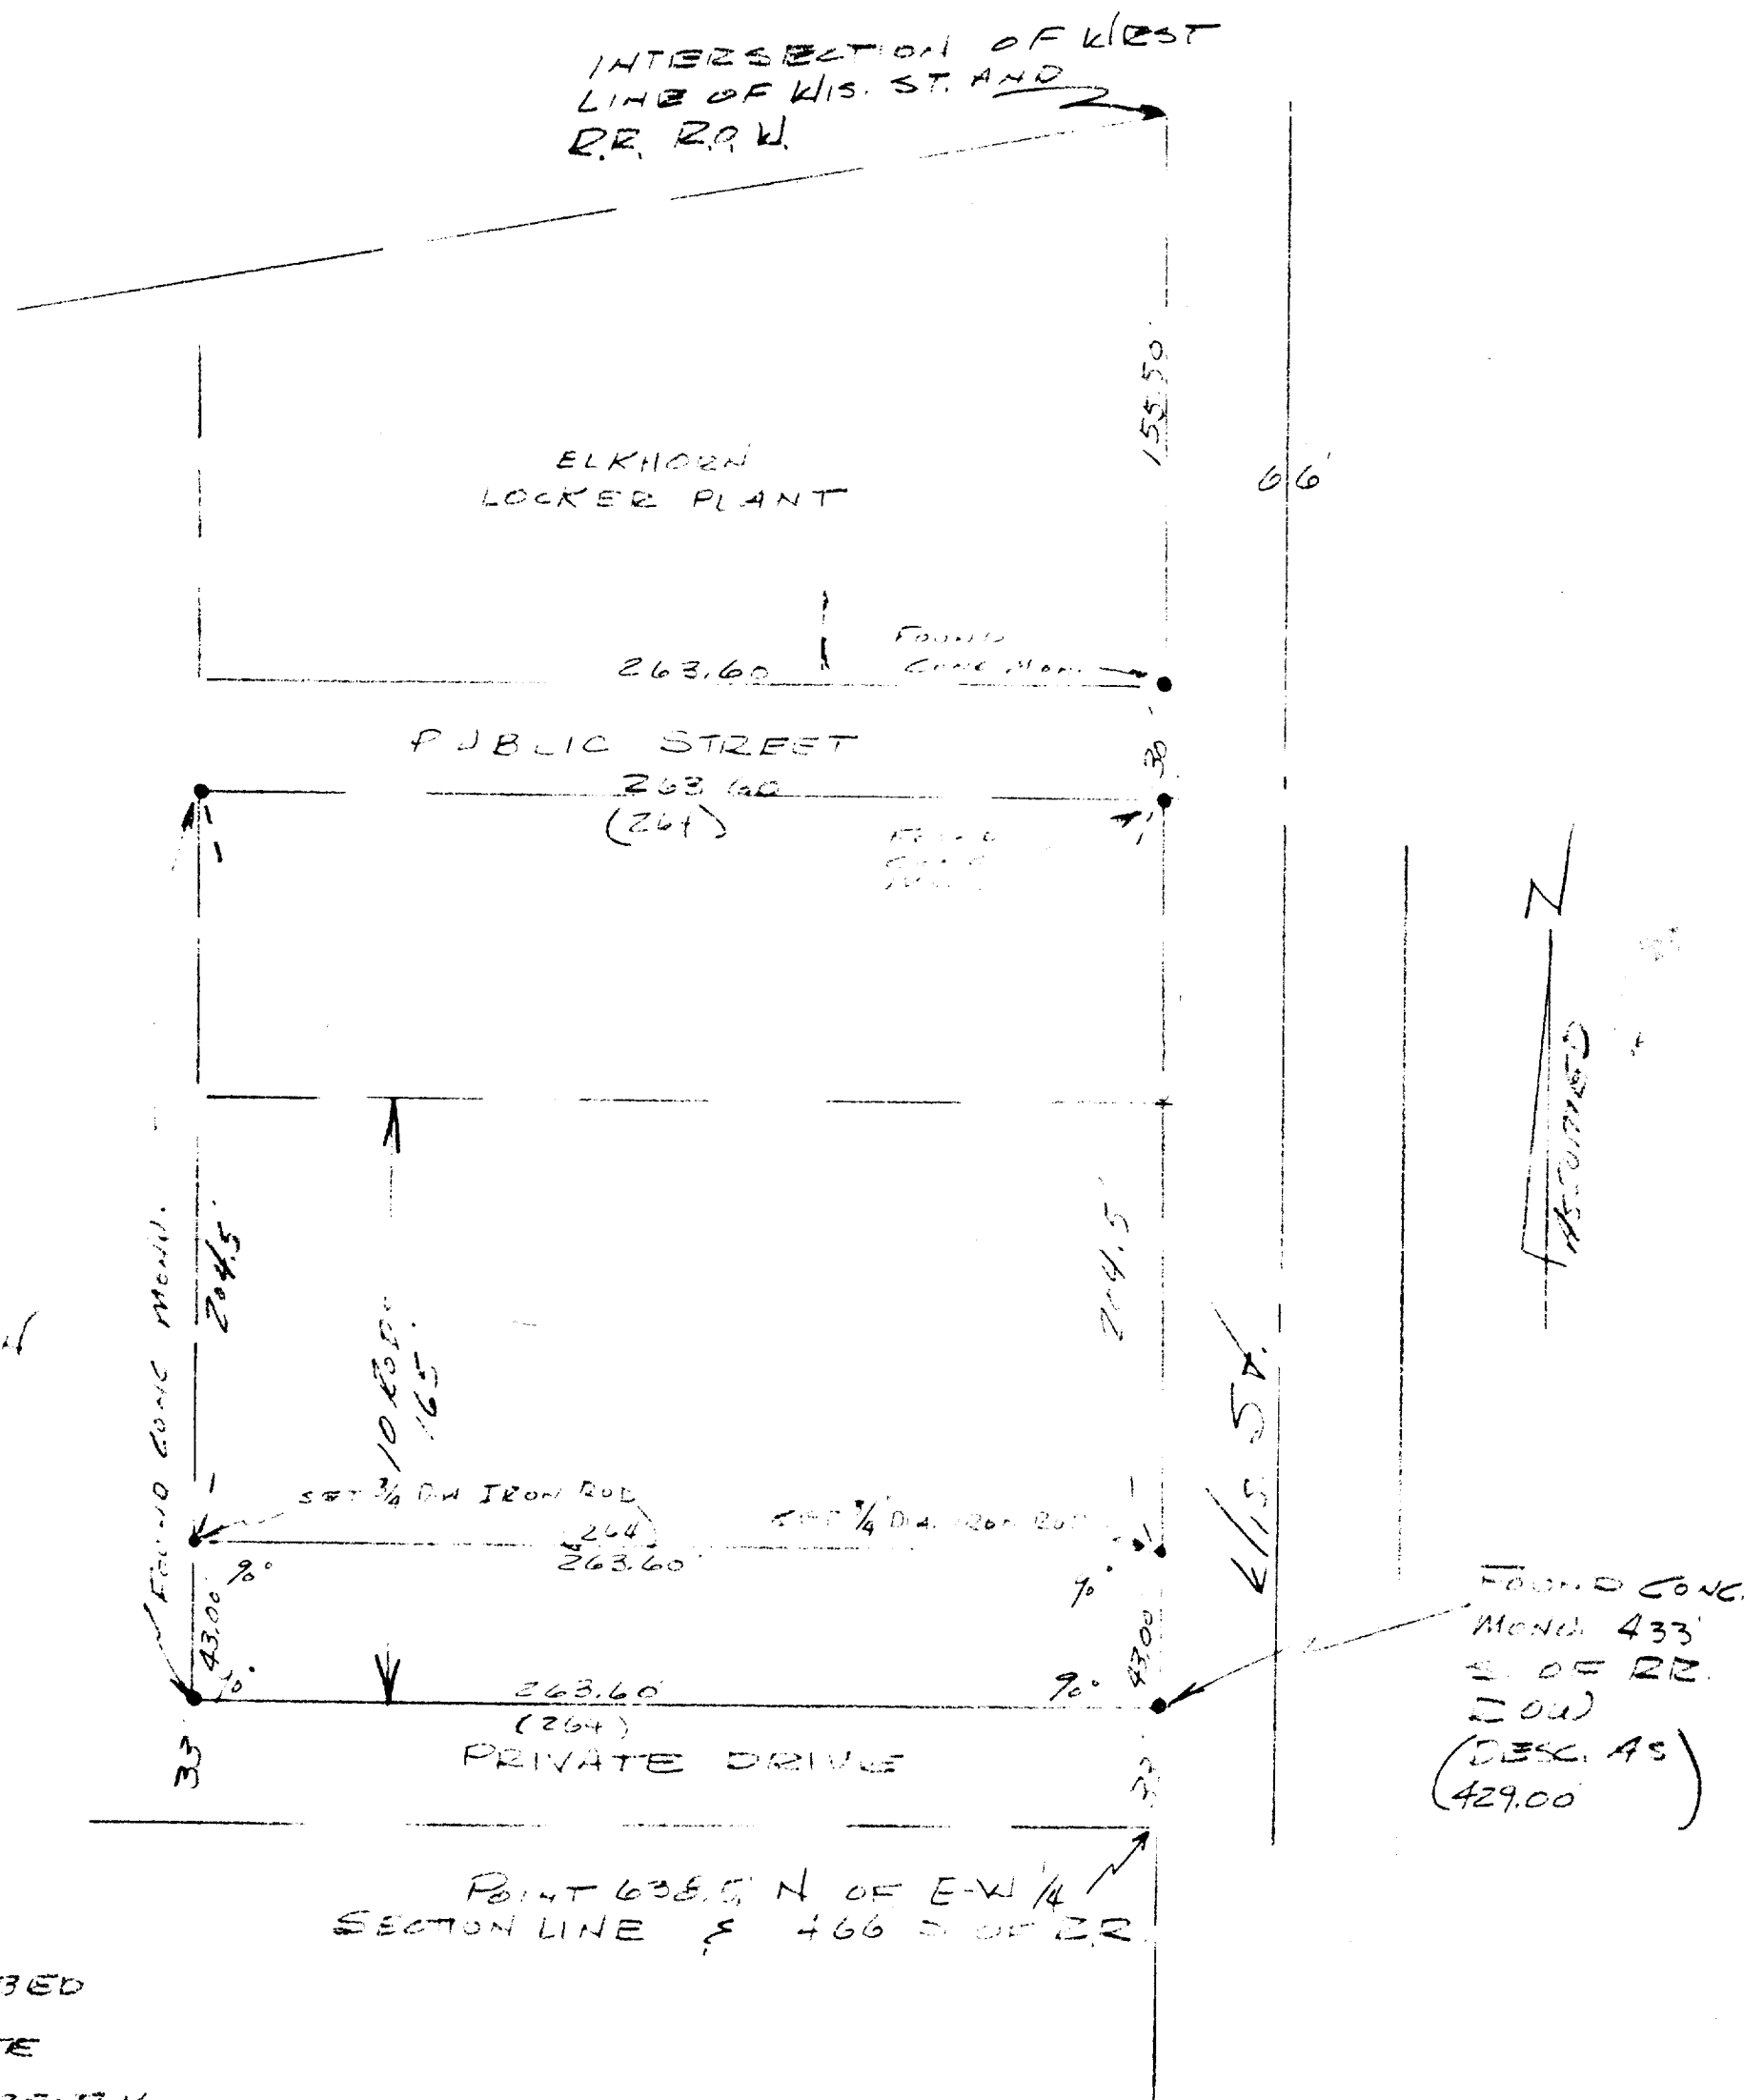


PARCEL OF LAND LOCATED IN THE SE $\frac{1}{4}$ OF THE NE $\frac{1}{4}$ OF SECTION 1, T2N 21E, CITY OF ELKHORN, WALWORTH COUNTY, WISCONSIN, DESCRIBED AS FOLLOWS:

COMMENCE AT THE INTERSECTION OF THE WEST LINE OF WISCONSIN ST. WITH THE SOUTH LINE OF THE RAILROAD ROW, THENCE SOUTH ALONG THE SAID WEST LINE OF WISCONSIN ST. 433.00 FEET (RECORDED AS 429.0 FEET) TO THE POINT OF BEGINNING, THENCE WEST 263.60 FEET (RECORDED AS 264.0 FEET); THENCE NORTH 43.00 FEET, THENCE EAST 263.60 FEET (RECORDED AS 264.0 FEET) TO THE WEST LINE OF WIS. ST., THENCE SOUTH ALONG THE WEST LINE OF WIS. ST. 43.00 FEET TO THE POINT OF BEGINNING.

I CERTIFY THAT I HAVE SURVEYED THE ABOVE DESCRIBED PROPERTY & THAT THE PLAT SHOWN HEREON IS AN ACCURATE SURVEY & A TRUE REPRESENTATION THERE OF & CORRECTLY SHOWS THE EXTREME BOUNDARY LINES & ALL DIVISIONS OF SAID PROPERTY

MAR. 16, 1976

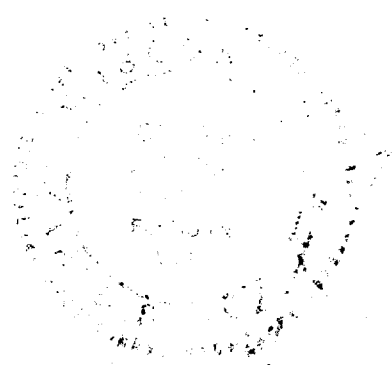

SURVEYED FOR: J. WARREN ELKHORN, WIS.

PLAT OF SURVEY OF

LAND LOCATED IN THE SE $\frac{1}{4}$ OF THE NE $\frac{1}{4}$ OF SECTION 1, T2N 21E, CITY OF ELKHORN, WALWORTH CO. WIS.

SURVEYOR

SCALE 1" = 50'

DATE MAR. 16, 1976