


- OF -

BEGINNING AT A POINT IN THE WEST LINE OF NORTH CHURCH STREET IN THE CITY OF ELKHORN, THAT IS 595.8 FEET NORTH OF THE INTERSECTION OF THE NORTH LINE OF SECOND AVENUE WITH THE WEST LINE OF NORTH CHURCH STREET , IN SAID CITY, THENCE NORTH 75.00 FEET ; THENCE WEST 135.00 FEET ; THENCE SOUTH 75.00 FEET ;THENCE EAST 135.00 FEET TO THE PLACE OF BEGINNING.

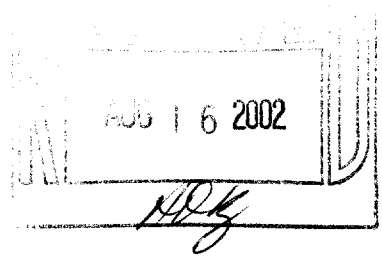

A circular seal for a Wisconsin Land Surveyor. The outer ring contains the text "WISCONSIN" at the top and "LAND SURVEYOR" at the bottom, separated by two five-pointed stars. The inner circle contains the text "JOHN P. KROTT", "S-2258", and "MUKWONAGO, WIS." arranged vertically.



4-1495

PLAT OF SURVEY

PREPARED FOR: DIANNE SHOWALTER
C-21 SKANDIA
822 E GENEVA
DELAVAN, WI, 53115

J.K. SURVEYING INC.
N3705 WILLOWBEND LANE
LAKE GENEVA, WI, 53147
262-248-3697

- OF -
BEGINNING AT A POINT IN THE WEST LINE OF NORTH CHURCH STREET IN THE CITY OF ELKHORN,
THAT IS 595.8 FEET NORTH OF THE INTERSECTION OF THE NORTH LINE OF SECOND AVENUE WITH
THE WEST LINE OF NORTH CHURCH STREET, IN SAID CITY, THENCE NORTH 75.00 FEET; THENCE
WEST 135.00 FEET; THENCE SOUTH 75.00 FEET; THENCE EAST 135.00 FEET TO THE PLACE OF
BEGINNING.

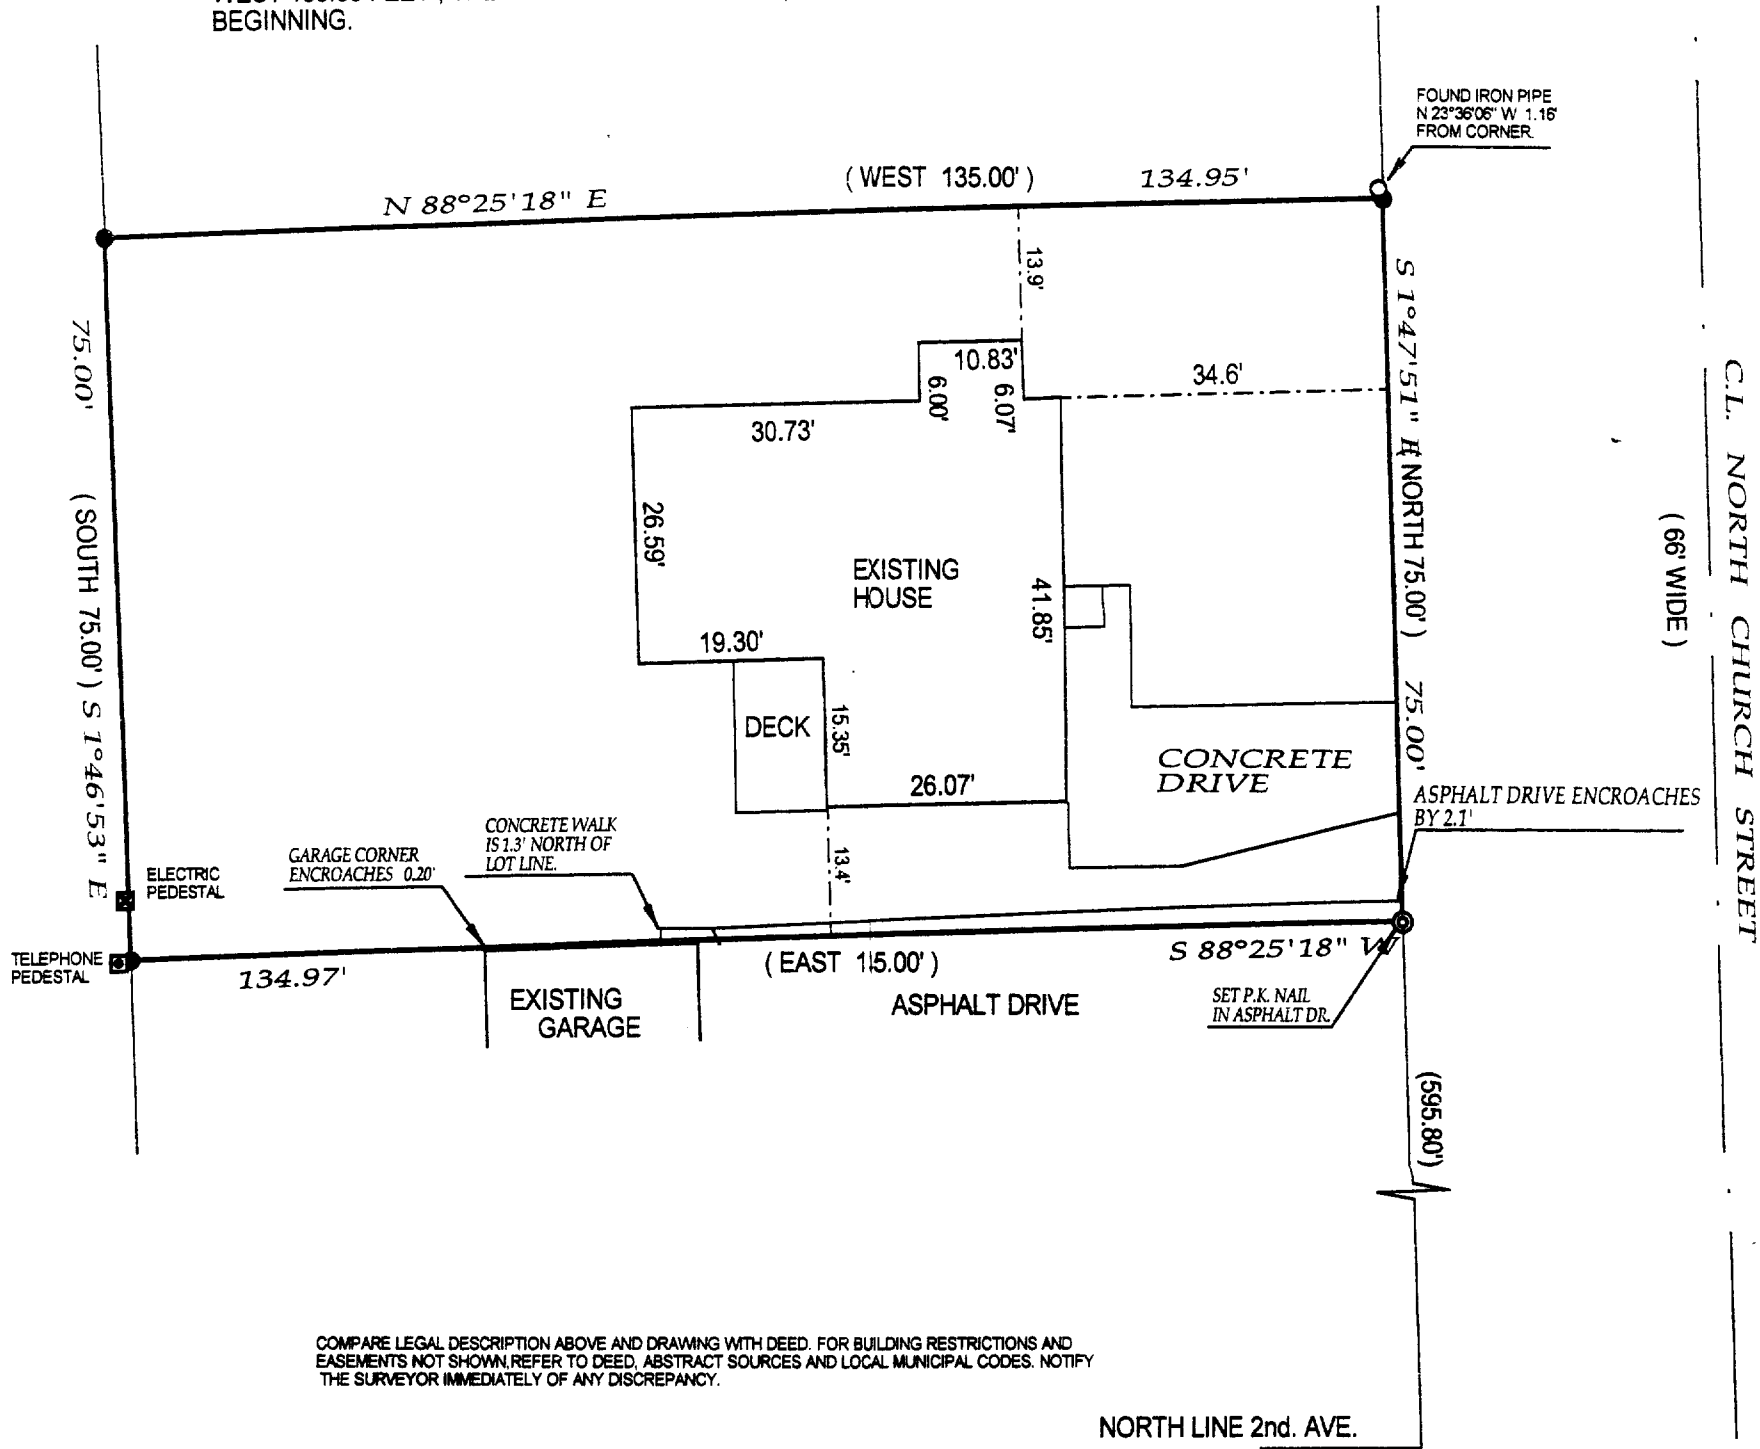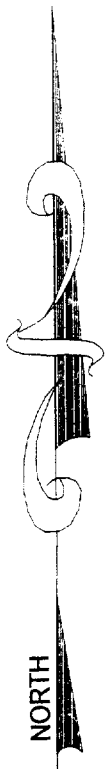

- () = recorded as
- = found iron bar
- = found iron pipe
- = set iron pipe
- = set iron bar

SCALE 1" = 20'

JOB # 02-294A


TAX ID # YU NW 00035

COMPARE LEGAL DESCRIPTION ABOVE AND DRAWING WITH DEED. FOR BUILDING RESTRICTIONS AND
EASEMENTS NOT SHOWN, REFER TO DEED, ABSTRACT SOURCES AND LOCAL MUNICIPAL CODES. NOTIFY
THE SURVEYOR IMMEDIATELY OF ANY DISCREPANCY.

"I hereby certify that I have surveyed the above described property and that
the above map is a true representation thereof and shows the size and
location of all visible structures, apparent easements and encroachments
if any."

This survey is made for the present owners of the property, and those who
purchase, mortgage, or guarantee the title thereto, within one year from
the date hereof.

DATED THIS 5 TH, DAY OF JUNE 20 02 .

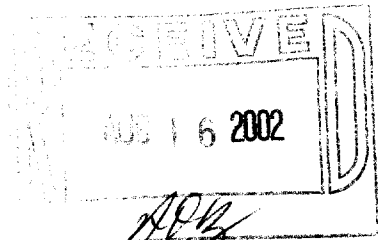

John P. Krott

JOHN KROTT S - 2258
Wisconsin Registered Land Surveyor
(original if signed in red)