


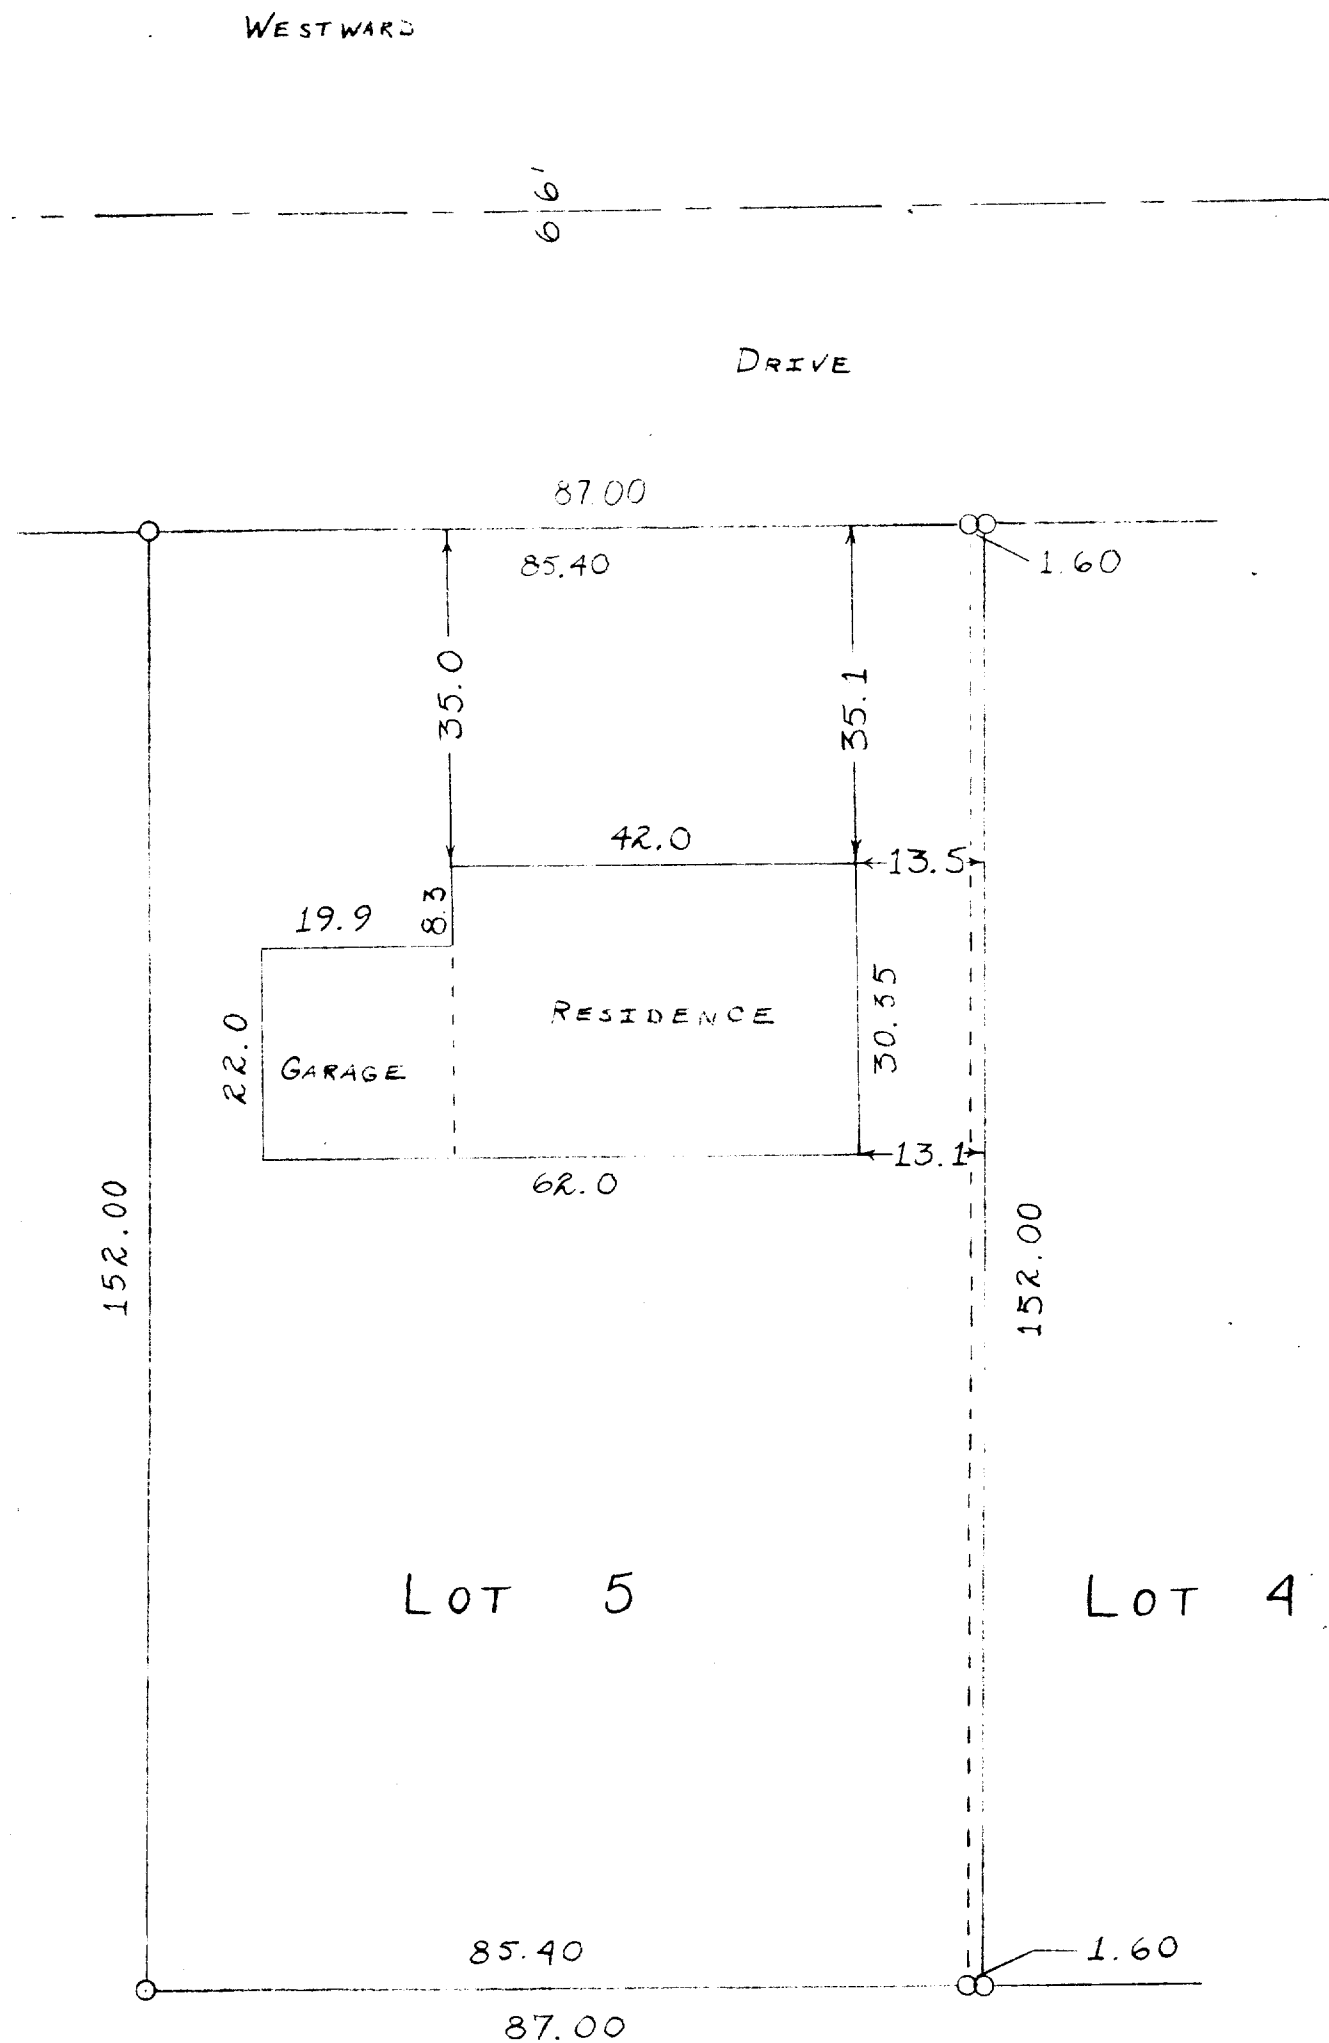

SCALE ~ 1" = 20'  
 O = IRON PIPE

STATE OF WISCONSIN) SS  
 WALWORTH COUNTY )

I, GEORGE T. DUNHAM, DO HEREBY CERTIFY THAT I HAVE SURVEYED THE  
 PROPERTY DESCRIBED AS FOLLOWS:

LOT 5 AND THE WEST 1.60 FEET OF LOT 4, BLOCK 2, JAMES JONES SECOND  
 ADDITION TO THE CITY OF ELKHORN, WALWORTH COUNTY, WISCONSIN  
 AND THAT THE ADJACENT PLAT IS A CORRECT REPRESENTATION OF THE PROPERTY  
 LINES AND IMPROVEMENTS LOCATED THEREON.

JULY 13, 1959

*George T. Dunham*  
 GEORGE T. DUNHAM, SURVEYOR  
 DELAVAN, WISCONSIN

4-15

YJA2-20