


61-59


4-120B

WISCONSIN STREET

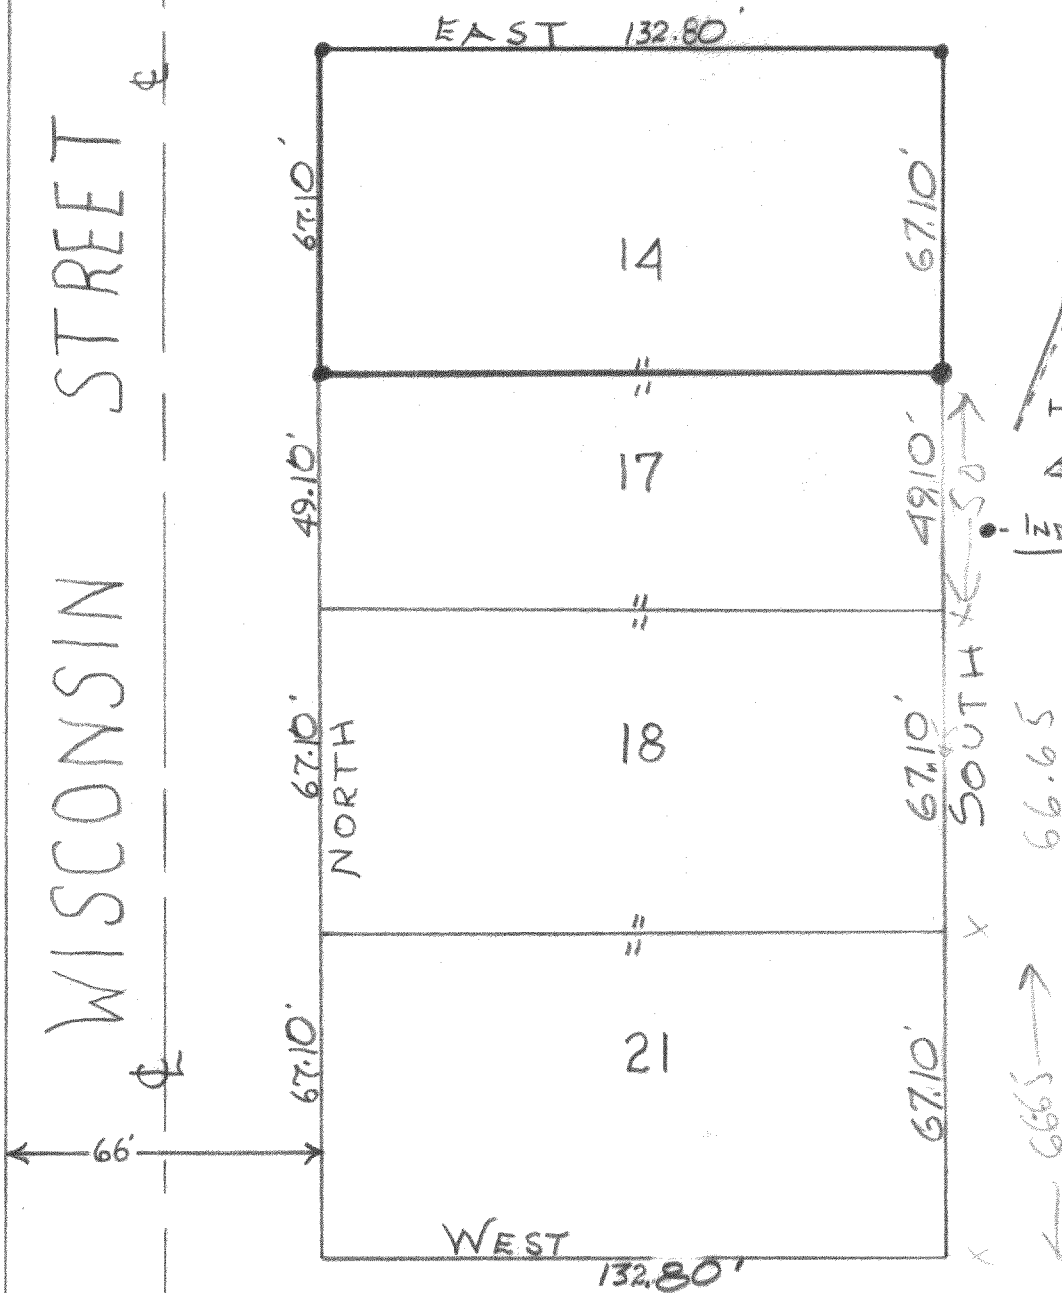

DISCRIPTION:

Lots # 14, 17, 18, 21 in Block #3, of Preston's addition, City of Elkhorn, county of Walworth, Wisconsin.

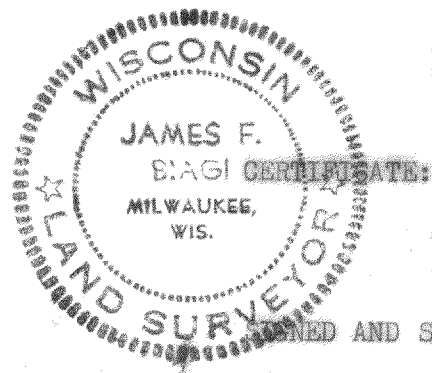

I James F. Biagi, Surveyor, do hereby certify that I have surveyed the property hereon described.

DESIGNED AND SEALED 20 JULY 1961.

James F. Biagi, BLS 272

YP:12, 15

4-150B