


YRM-20A
140-2

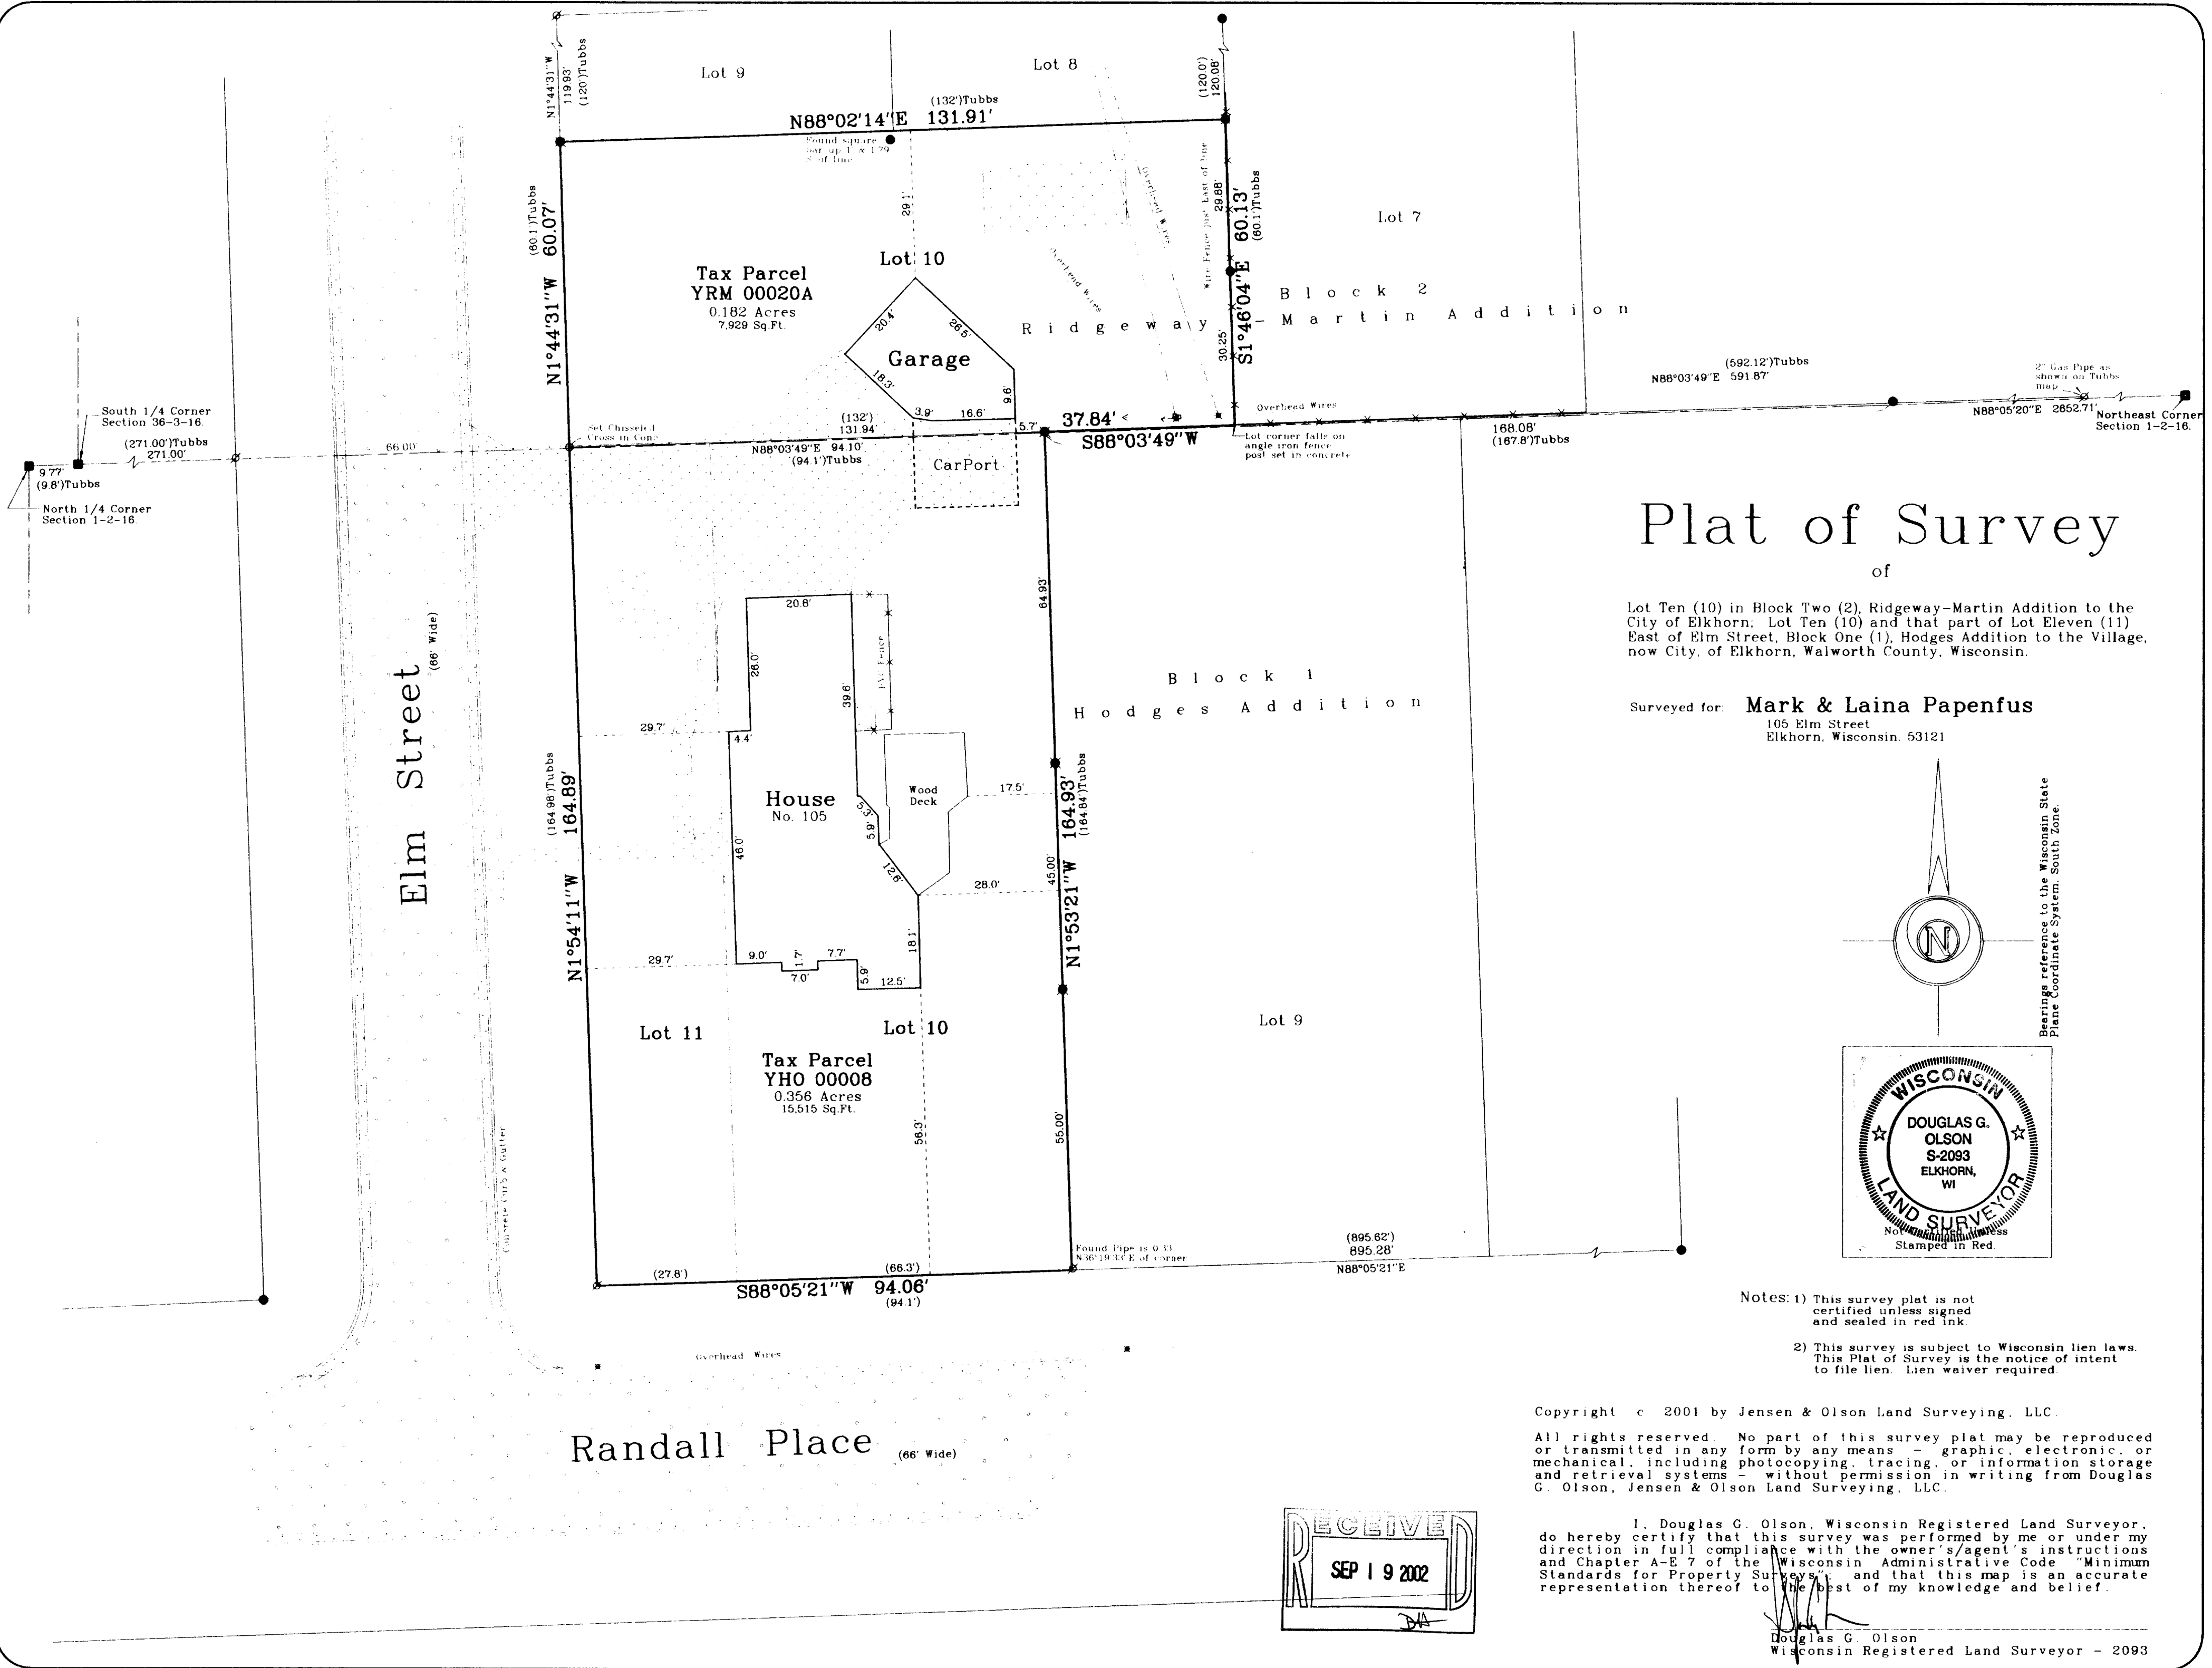

RECEIVED
SEP 19 2002

Douglas G. Olson
Wisconsin Registered Land Surveyor - 2093

004-1514

Jensen & Olson Land Surveying, LLC 45 South Wisconsin Street Elkhorn, Wisconsin, 53121 Telephone (262) 723-3434 Facsimile (262) 723-8044	
Sheet 1 of 1 Sheets	Job Reference Number 2001.136
2001.136	