


Plat of Survey

of




A parcel of land described in Title Commitment No. WAL39.484, issued by Chicago Title Insurance Company, dated December 5, 2001, as shown below:

That portion of Lot 11, Block 25 of the Village (now City) of Elkhorn, according to the recorded plat thereof, described as follows: Commencing at a point on the West line of said Lot 11, 60.5 feet North of the Southwest corner of said Lot; thence East along a line parallel with the North line of said Lot, 132 feet, more or less, to the East line of said Lot; thence North along the East line of said Lot 22 feet, more or less, to the North line of said Lot; thence West on the North line of said Lot 132 feet, more or less, to the West line thereof, thence South 22 feet, more or less, to the place of beginning.

Surveyed for: **Firstar Bank, N.A.**
303 Center Street
Lake Geneva, Wisconsin. 53147

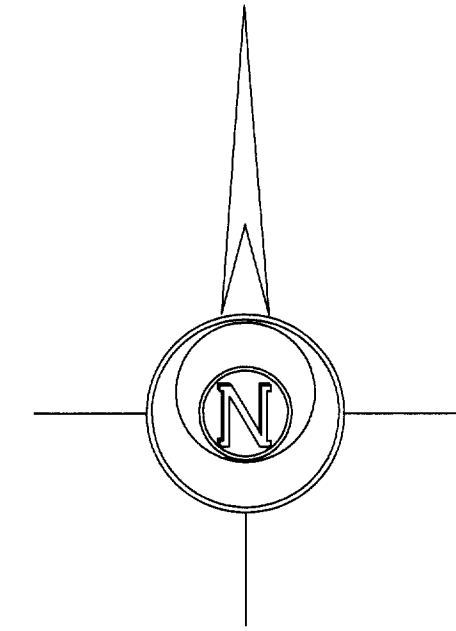

Survey date: December 18, 2001.
Revisions:

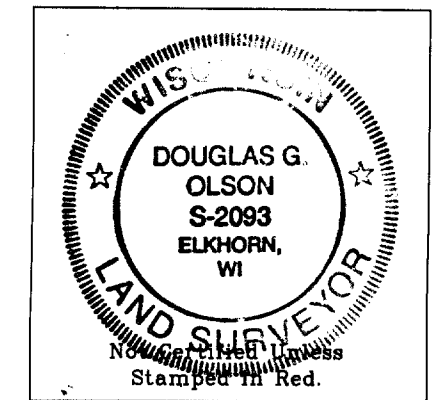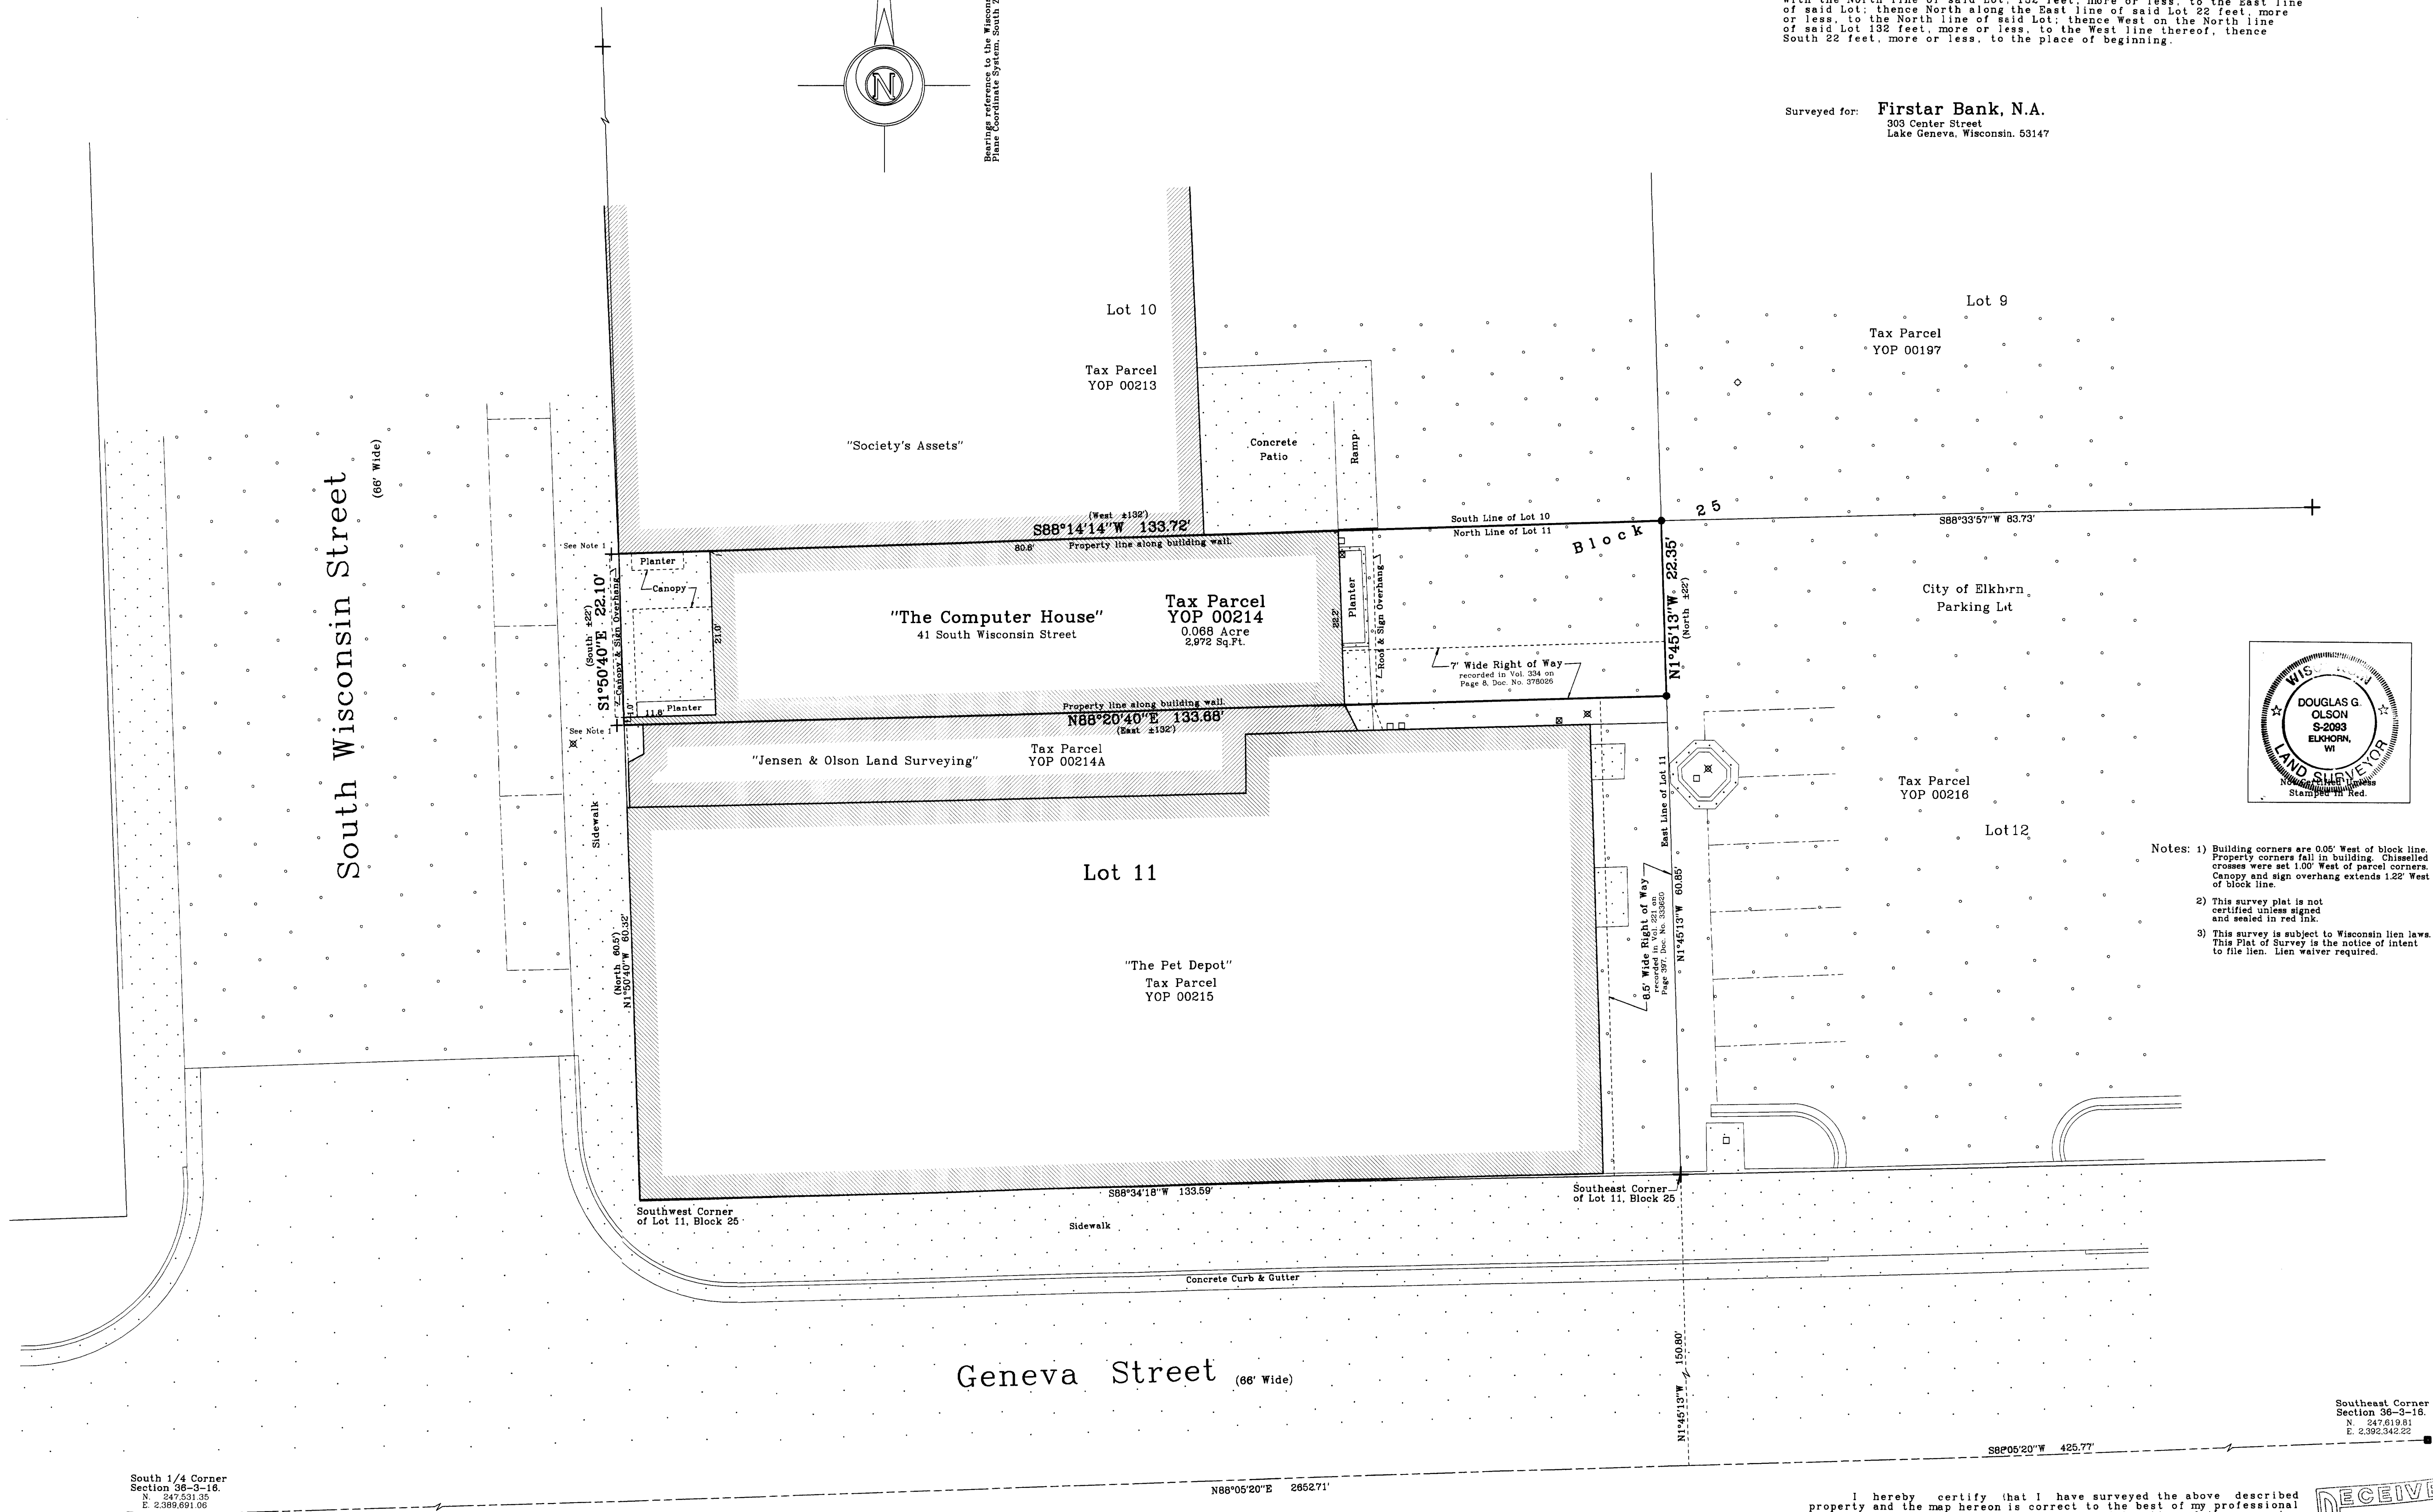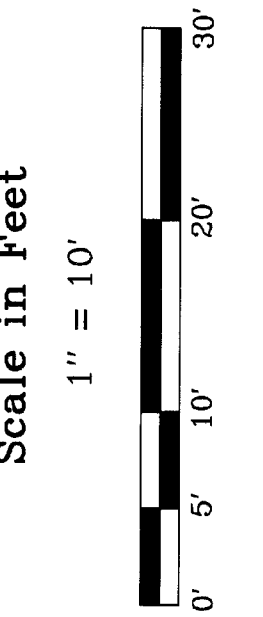

- Notes: 1) Building corners are 0.05' West of block line. Property corners fall in building. Chiselled crosses were set 1.00' West of parcel corners. Canopy and sign overhang extends 1.22' West of block line.
2) This survey plat is not certified unless signed and sealed in red ink.
3) This survey is subject to Wisconsin lien laws. This Plat of Survey is the notice of intent to file lien. Lien waiver required.

Jensen & Olson Land Surveying, LLC
45 South Wisconsin Street P.O. Box 322
Elkhorn, Wisconsin. 53121
Telephone: (262) 723-3434
Facsimile: (262) 723-8044

- Legend**
- Found County Section Corner
 - Set Railroad Spike
 - Recorded Information
 - Electric Meter or Pedestal
 - Utility or Light Pole
 - Concrete Surface
 - Asphalt Surface
 - Building
 - Well
 - Painted
 - Parking
 - Stall


Sheet 1 of 1 Sheets.

Job Reference Number
2001.183

2001.183

I hereby certify that I have surveyed the above described property and the map hereon is correct to the best of my professional knowledge and belief, and shows the size and location of the property, its exterior boundaries, the location and dimensions of all visible structures thereon, boundary fences, apparent easements and roadways and visible encroachments, if any.
This survey is made for the exclusive use of the present owners of property, and also those who purchase, mortgage or guarantee title thereto, within one year from the date hereof.

Douglas G. Olson
Wisconsin Registered Land Surveyor - 2093

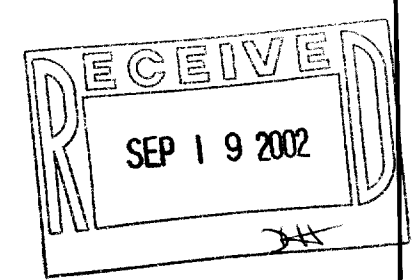

Copyright © 2001 by Jensen & Olson Land Surveying, LLC.
All rights reserved. No part of this survey plat may be reproduced or transmitted in any form by any means - graphic, electronic, or mechanical, including photocopying, tracing, or information storage and retrieval systems - without permission in writing from Douglas G. Olson, Jensen & Olson Land Surveying, LLC.

004-1515

YOP-215, YOP-214, YOP-214A