


⊗ - IRON PIPE OR ROD FOUND
 ✱ - 60 PENNY SPIRE SET

Washington St. 66' wide



SURVEYED FOR DESCRIPTION FURNISHED BY MODERN REALTY, ELKHORN, WIS.

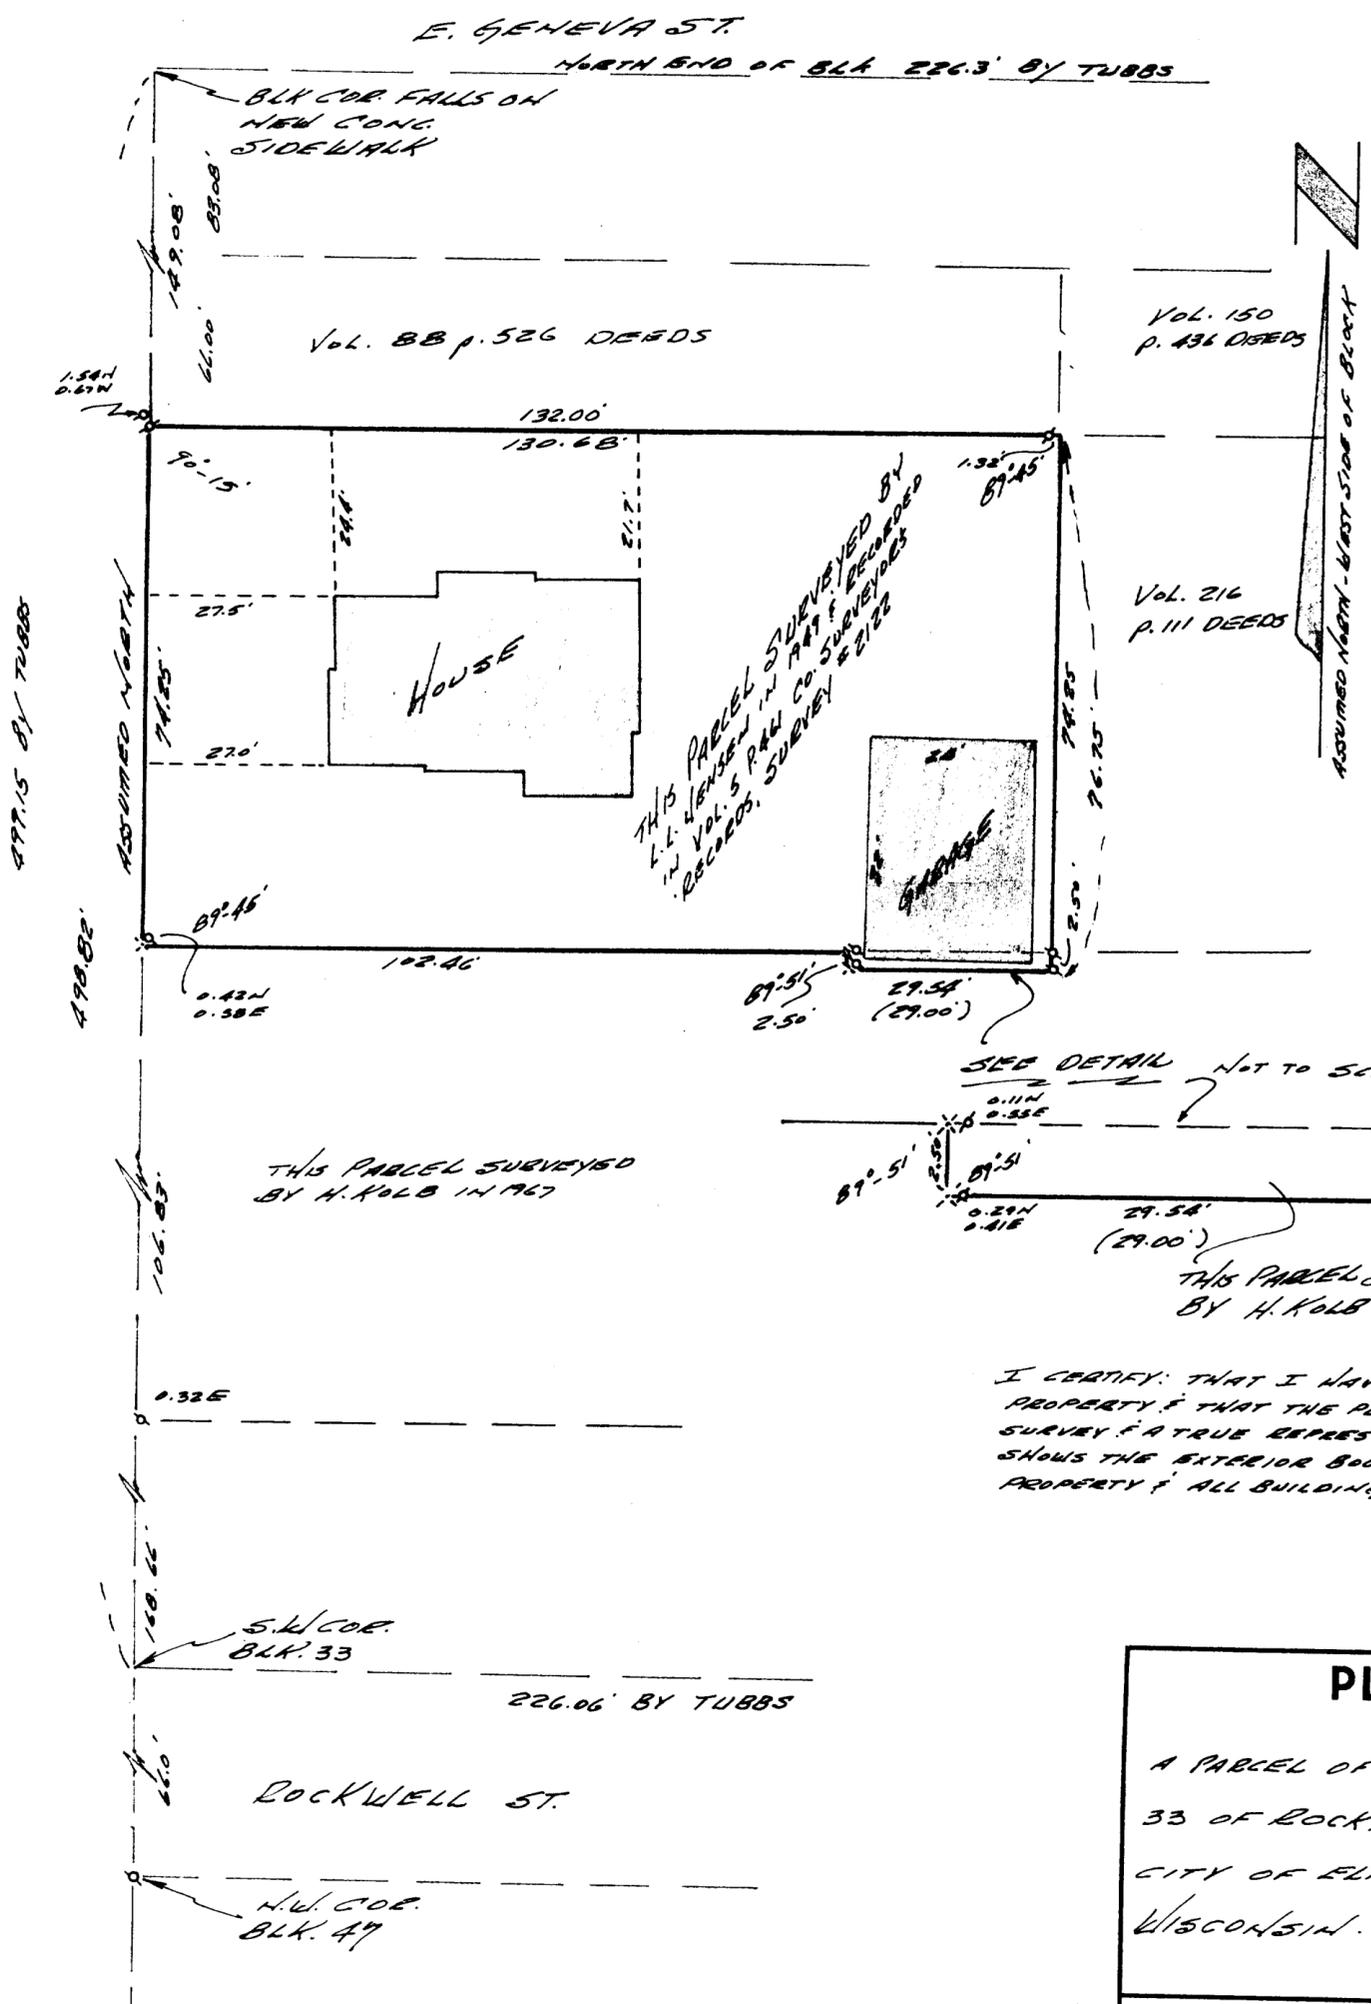

PLAT OF SURVEY
 OF
 A PARCEL OF LAND LOCATED IN BLOCK
 33 OF ROCKWELL'S ADDITION TO THE
 CITY OF ELKHORN, WALWORTH COUNTY,
 WISCONSIN.

Thomas P. A. Jensen
 SURVEYOR

SCALE 1" = 20'
 DATE Jan. 15, 1976
 4-15-81