

PREPARED FOR:  
TOM MARTIN  
KEEFE REAL ESTATE, INC.  
980 A WISCONSIN ST.  
ELKHORN, WI  
53121


# PLAT OF SURVEY

- OF -

LOT 2 CERTIFIED SURVEY MAP NO. 1933 RECORDED IN VOLUME 9 OF CERTIFIED SURVEY MAPS  
ON PAGE 151 AS DOCUMENT NO. 192924, BEING A PART OF THE NW 1/4 OF THE NW 1/4 OF  
SECTION 31, T.3.N., R.17.E., CITY OF ELKHORN, WALWORTH COUNTY, WISCONSIN.

J.K. SURVEYING INC.  
N3705 WILLOWBEND LANE  
LAKE GENEVA, WI, 53147  
262-248-3697

C.L. E. THIRD AVE (66' WIDE)

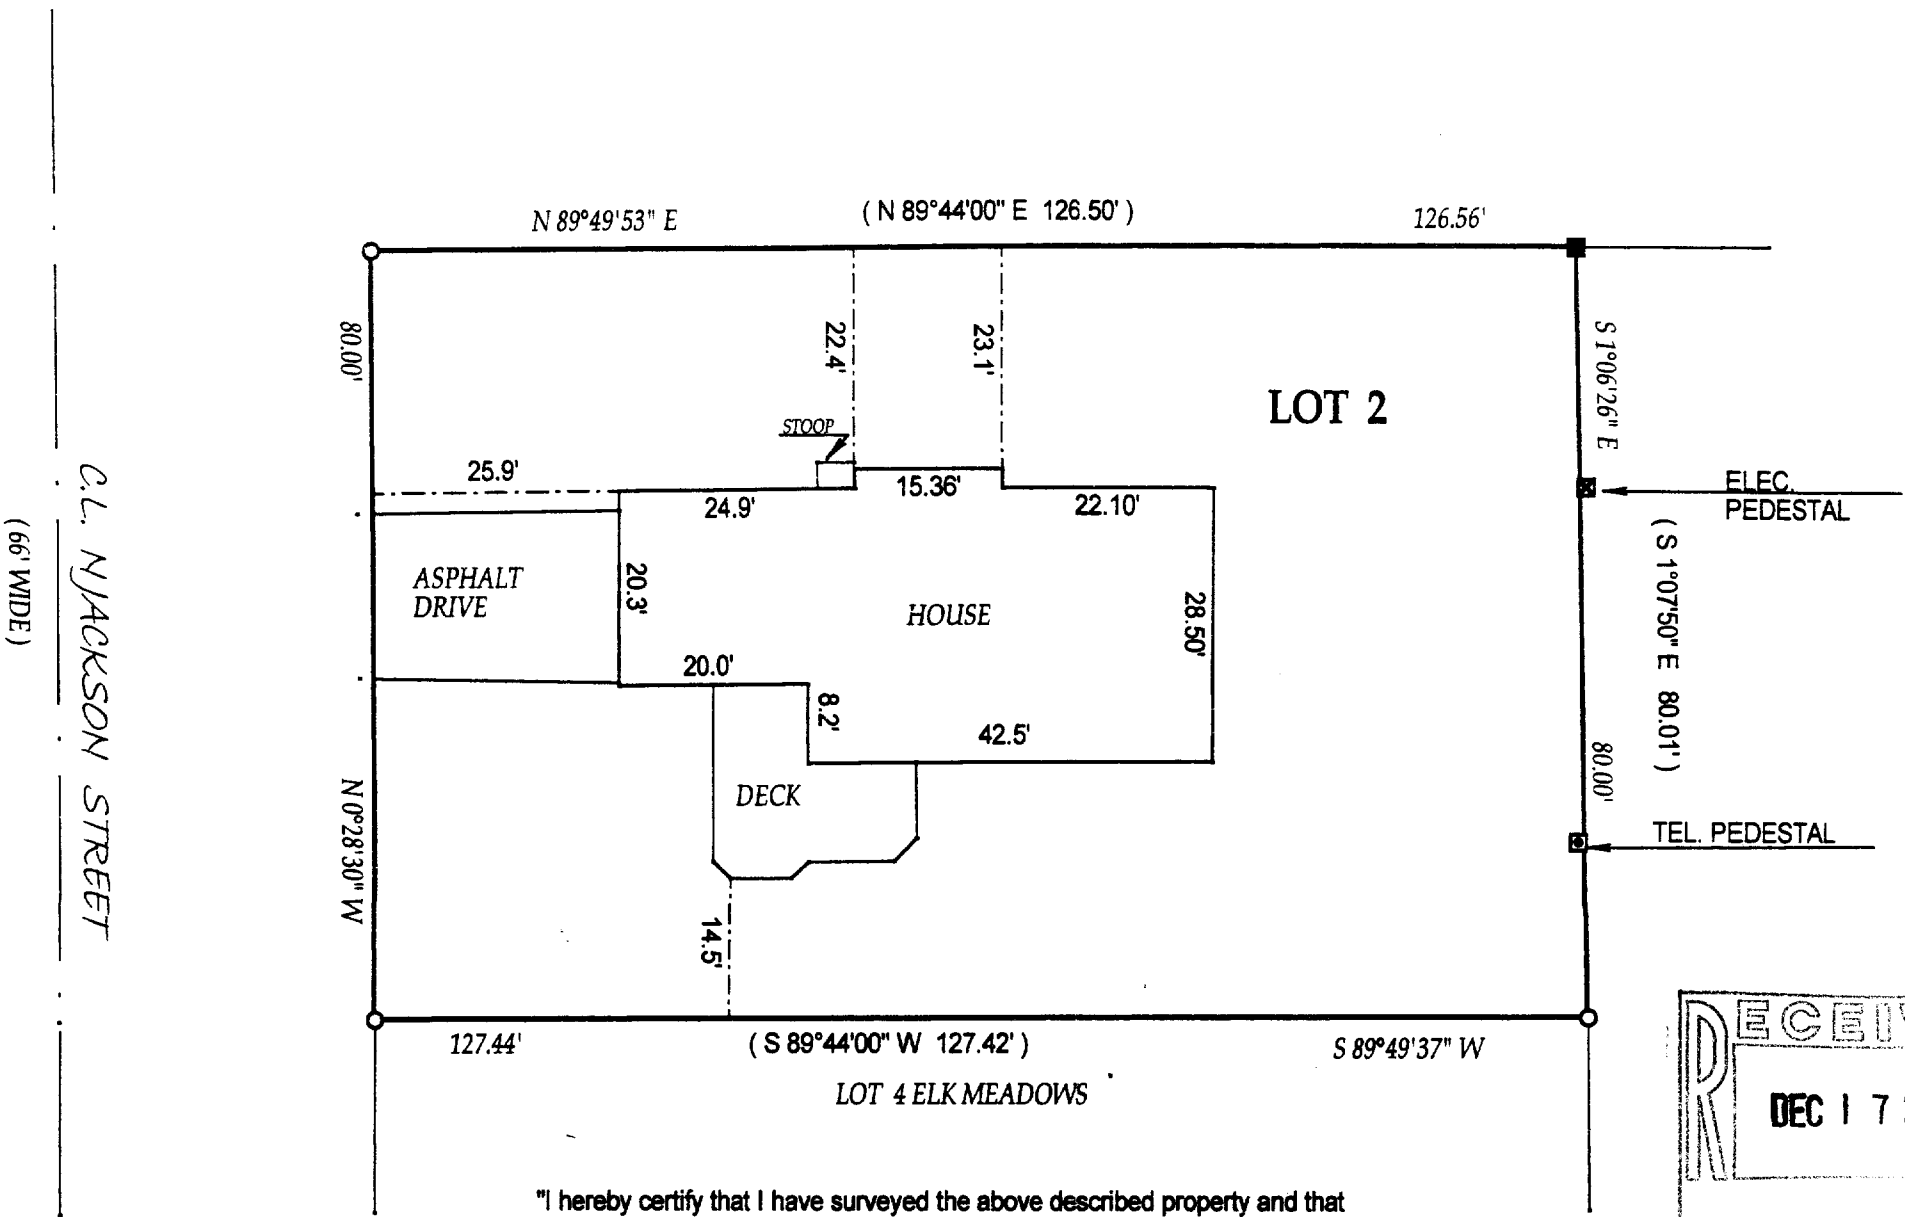



- ( ) = recorded as
- = found iron bar
- = found iron pipe
- = set iron pipe
- = set iron bar

SCALE 1" = 20'

JOB # 02-483

TAX ID # YA193300002

"I hereby certify that I have surveyed the above described property and that  
the above map is a true representation thereof and shows the size and  
location of all visible structures, apparent easements and encroachments  
if any."  
This survey is made for the present owners of the property, and those who  
purchase, mortgage, or guarantee the title thereto, within one year from  
the date hereof. DATED THIS 18 TH, DAY OF SEPTEMBER 20 02 .

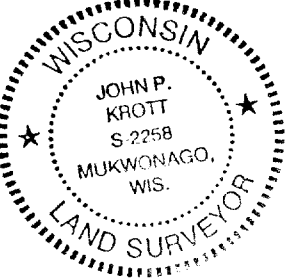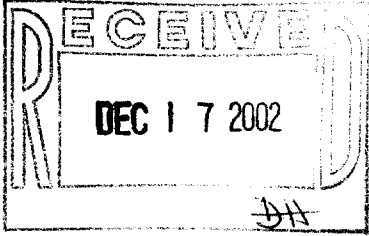

*John P. Krott*  
JOHN KROTT S - 2258  
Wisconsin Registered Land Surveyor  
(original if signed in red)

YA1933-2

004-1547