


STREET

N L O C U L I N

N O R T H

1

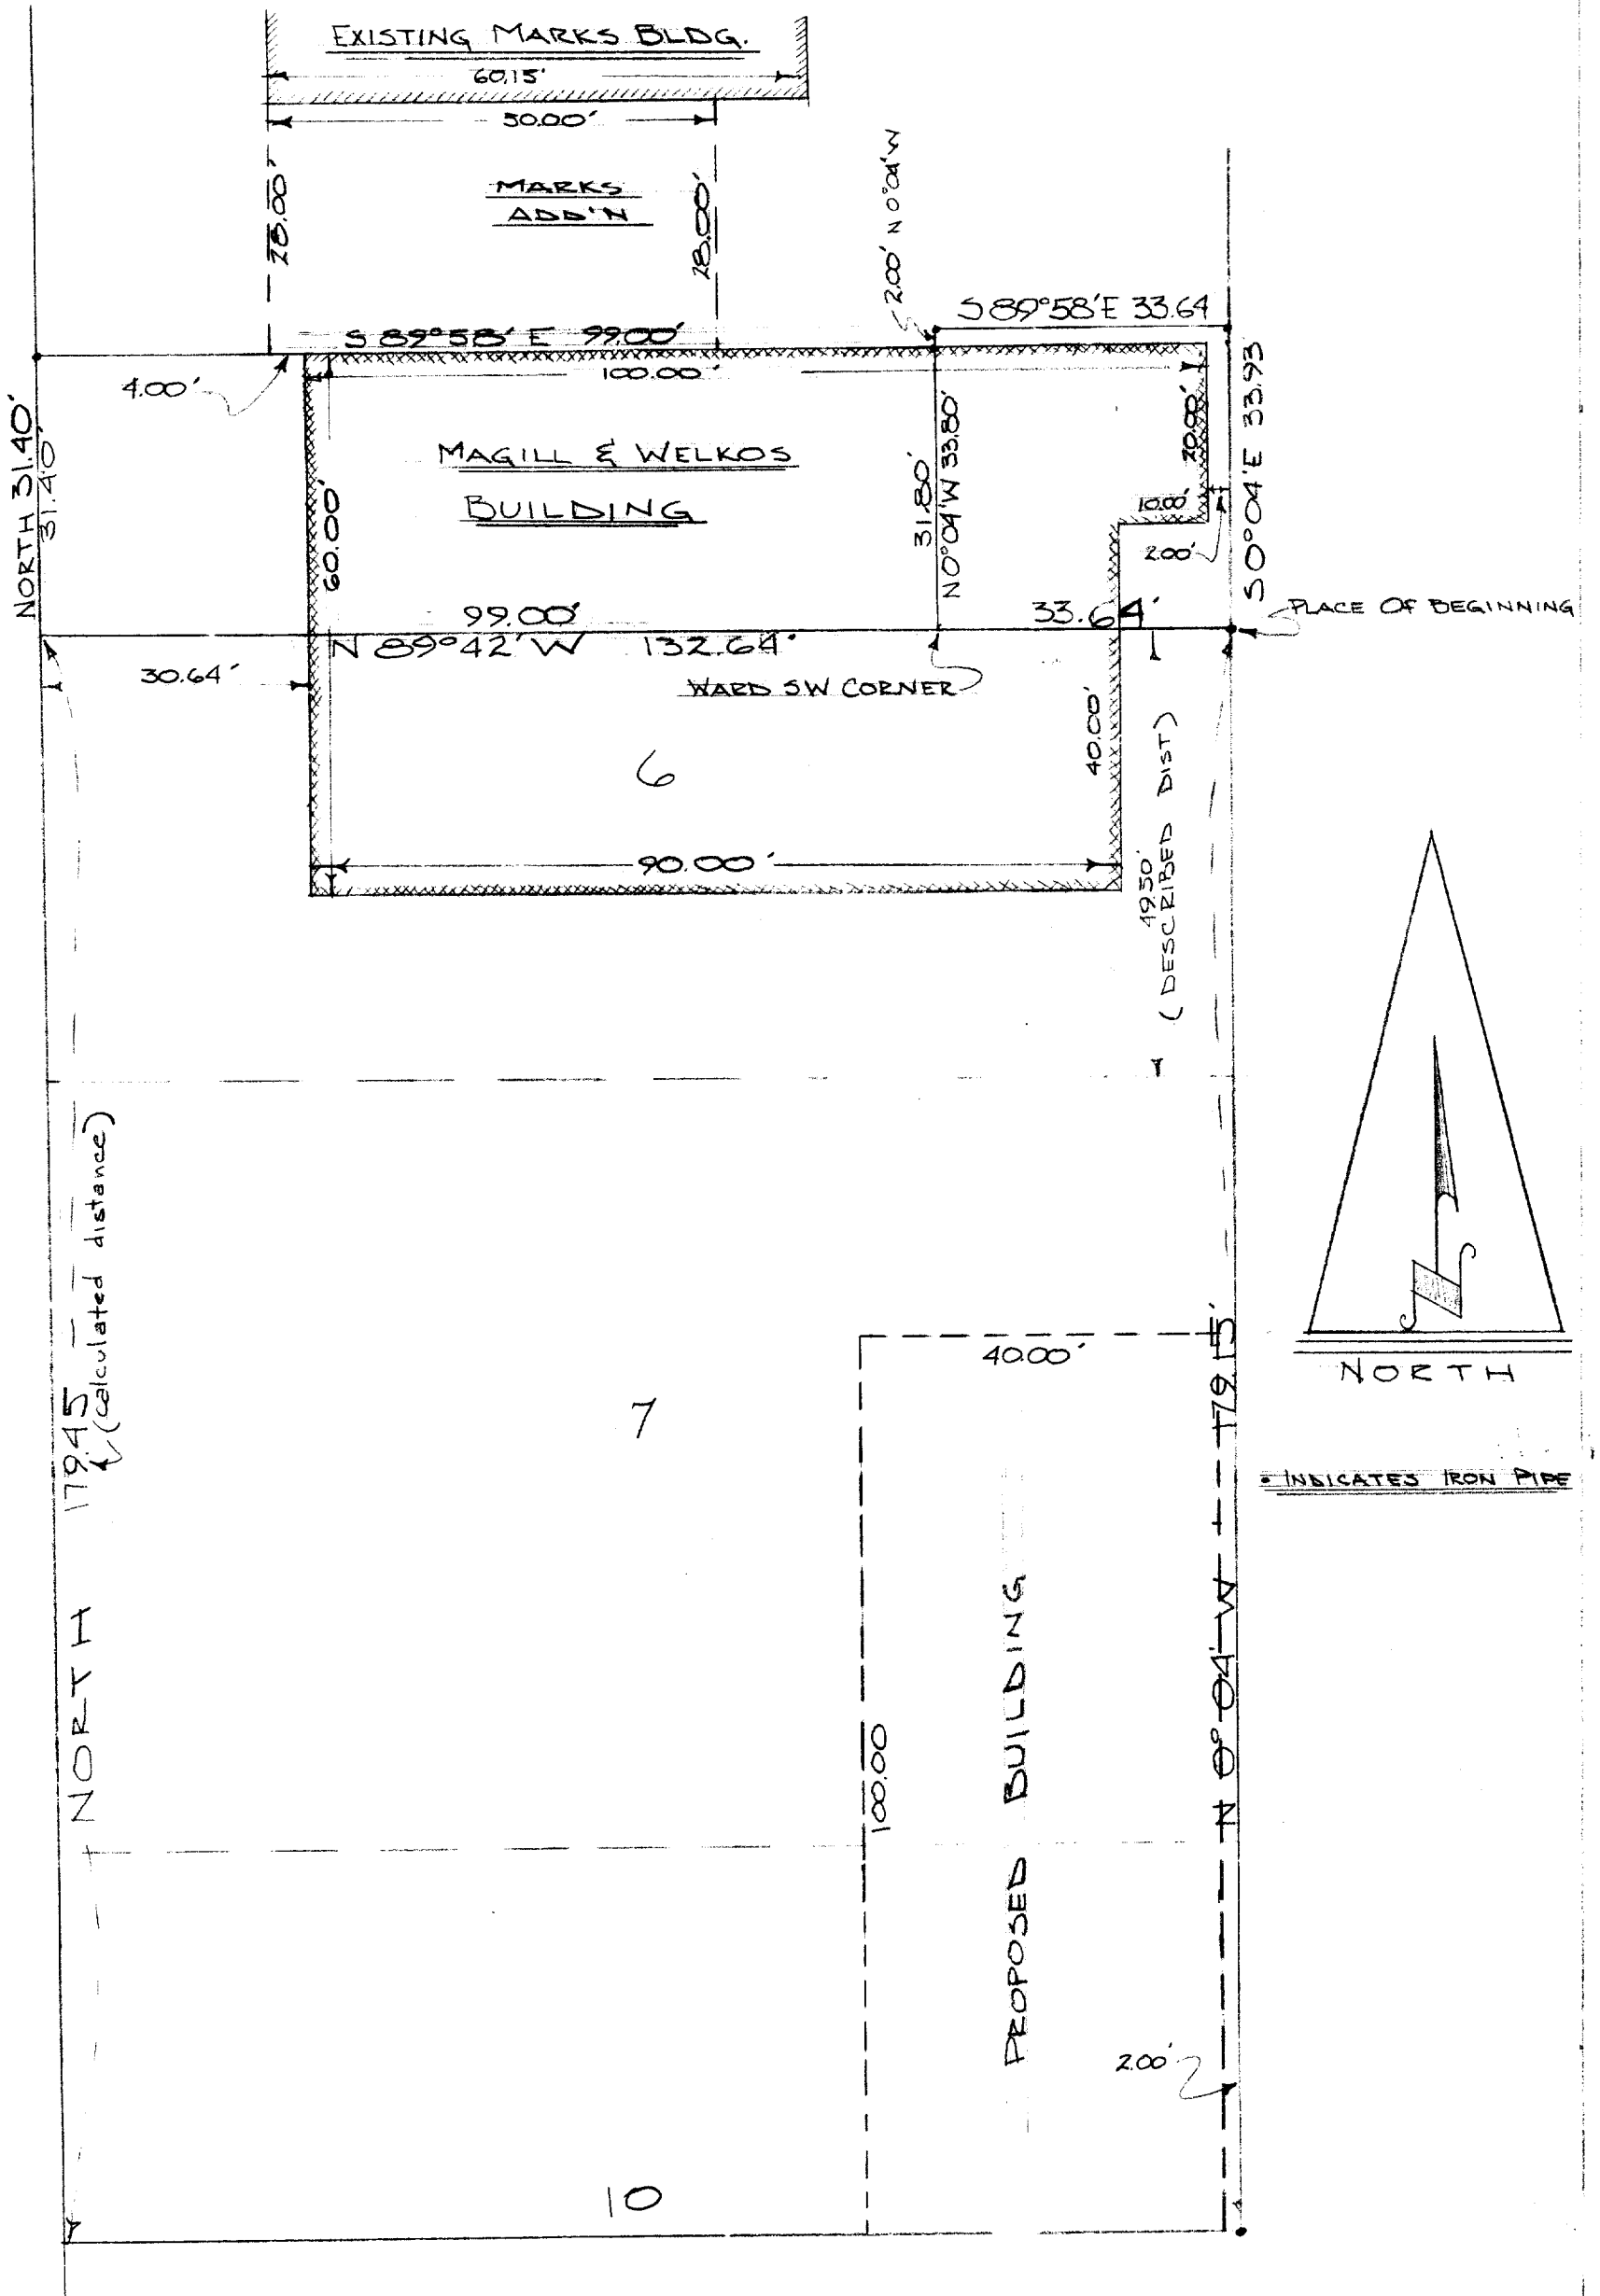

WARD TO MARKS

DESCRIPTION: Commencing 49.50 feet north of the S.E. corner of Lot 6 of Block 22 of Rockwell's Addition to the City of Elkhorn, Walworth County, Wisconsin; thence N. 89° 42' W. 33.64 feet to the SW corner of the Ward Lot, thence N. 0° 04' W. 33.80 feet, thence S. 89° 58' E. 33.64 feet, thence S. 0° 04' E. 33.93 feet to the place of beginning.

MARKS TO MAGILL AND WELKOS

DESCRIPTION: Commencing 49.50 feet north of the SE corner of Lot 6 of Block 22 of Rockwell's Addition to the City of Elkhorn, Walworth County, Wisconsin; thence N. 89° 42' W. 132.64 feet, thence North 31.40 feet, thence S. 89° 58' E. 99.00 feet thence N. 0° 04' W. 2.00 feet, thence S. 89° 58' E. 33.64 feet, thence S. 0° 04' E. 33.93 feet to the place of beginning.

CERTIFICATE: I, James F. Biagi, surveyor, do hereby certify that I have surveyed the property hereon described and that the location of the improvements are as shown.

December 16 1963.

Recertified May 21 1964

Now c 1533

James F. Biagi, RLS 272

James F. Biagi, RLS 272

