


53-11

53-11-120

CHURCH STREET

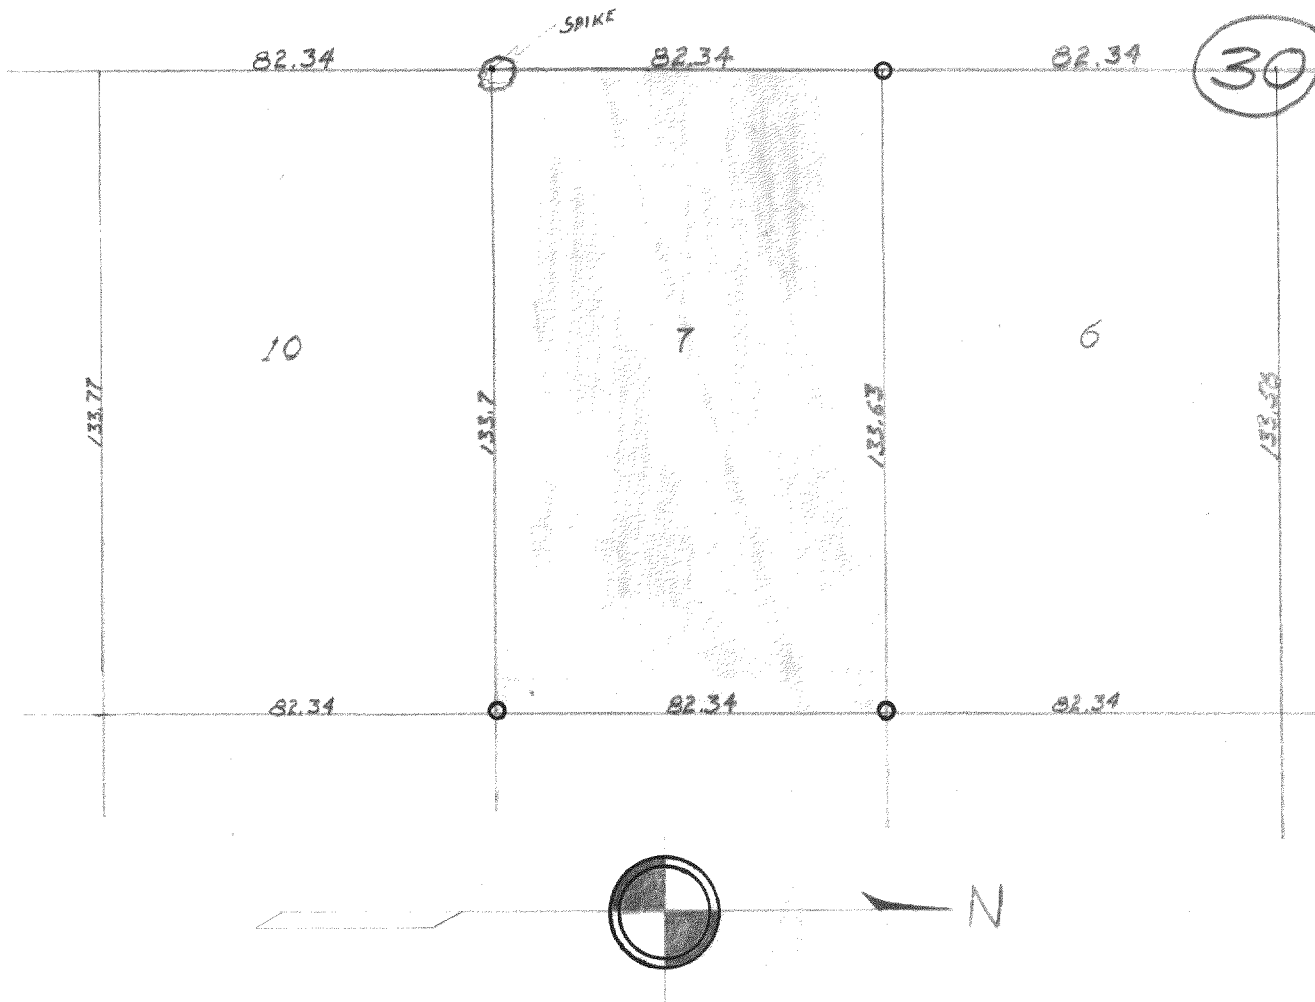

## DESCRIPTION:

Lot 7, Block 30, Rockwell's Addition to the City of Elkhorn, Walworth County Wisconsin.

## CERTIFICATE:

I, hereby certify that I, have surveyed the above described property on the 4th day of June 1953, and no encroachments exist.

SIGNED AND SEALED ON THIS THE 5TH DAY OF JUNE 1953.

*Joseph M. Biagi*  
Joseph M. Biagi. Professional Engineer.  
Elkhorn Wisconsin.

YRW-43

4-156 B 2