

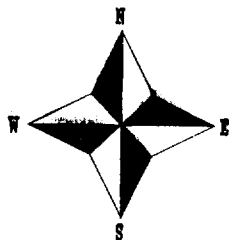


J.K. SURVEYING INC.
N3705 WILLOWBEND LANE
LAKE GENEVA, WI, 53147
262-248-3697

NOTE : PAGE STREET WAS ASSUMED TO BE N 89°11' E

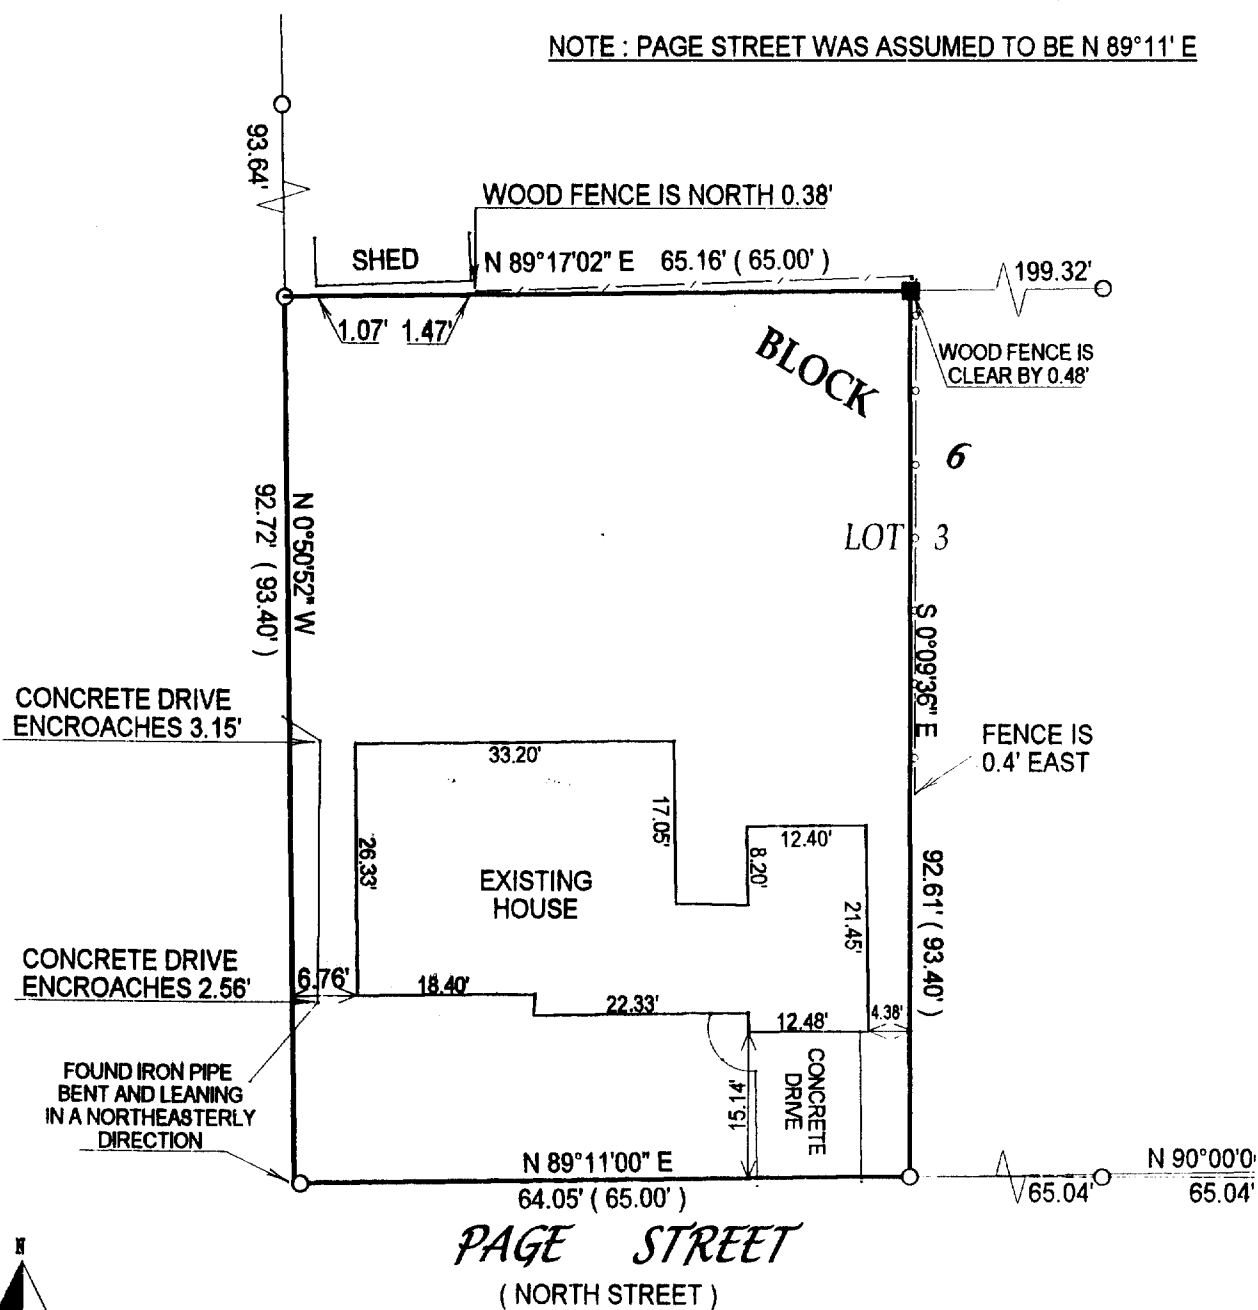

RECEIVED
MAR 24 2003
J. J. J.

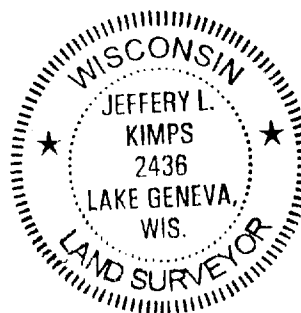

TAX ID # YOP00017


JEFFREY L KIMPS S - 2436
Wisconsin Registered Land Surveyor
(original if signed in red)

DATED THIS THE 21st DAY OF JANUARY 2003.

004-1579