


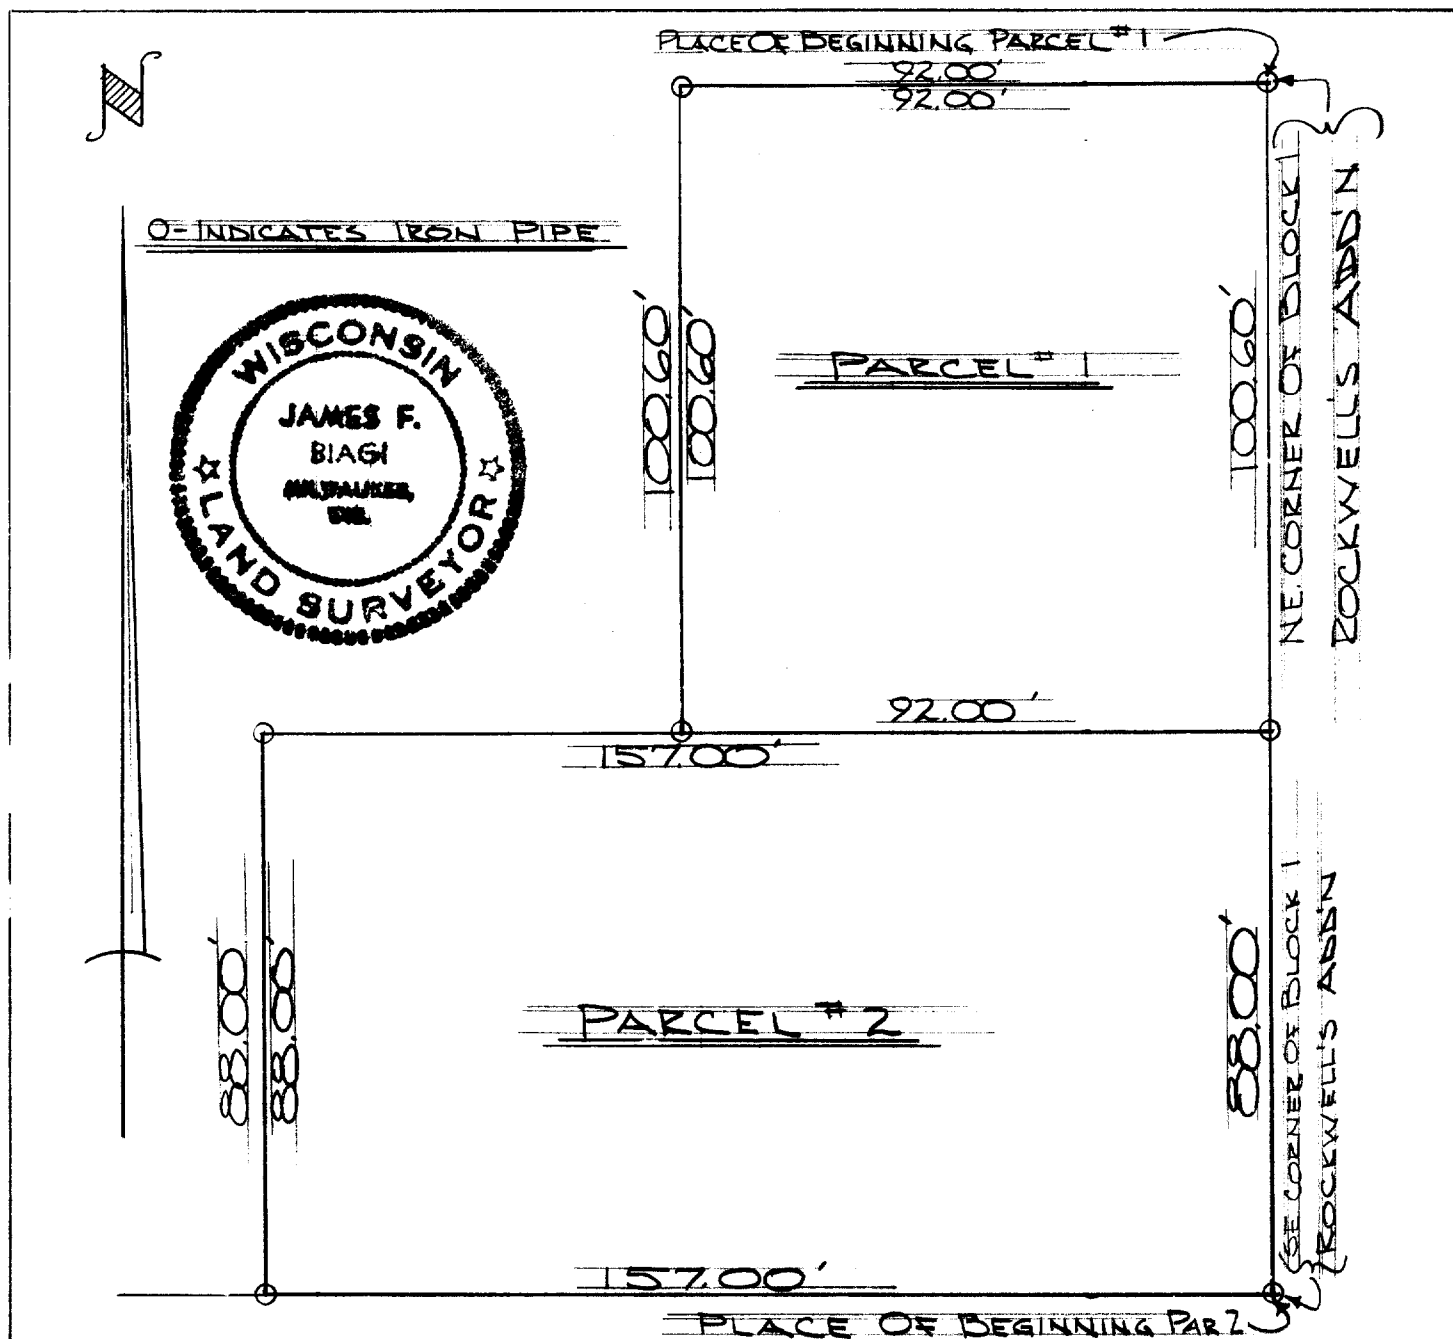

DESCRIPTION: PARCEL #1- Commencing at the NE corner of Block 1 of Rockwell's Addition to the City of Elkhorn, Walworth County, Wisconsin; thence South along the East line of Block 1, 100.60 feet, thence West parallel to the North line of Block 1, 92.00 feet, thence North parallel to the East line of Block 1, 100.60 feet, thence East along the North line of Block 1, 92.00 feet to the P.O.B. PARCEL # 2- Commencing at the SE corner of Block 1 of Rockwell's Addition to the City of Elkhorn, Walworth County, Wisconsin; thence North along the East line of Block 1, 88.00 feet, thence West parallel to the South line of Block 1, 157.00 feet, thence South parallel to the East line of Block 1, 88.00 feet, thence East along the South line of Block 1, 157.00 feet to the place of beginning. CERTIFICATE: I, James F. Biagi, surveyor, do hereby certify that I have surveyed the property hereon described.

August 20, 1966

James F. Biagi R.L.S. 272

YRW-1

YRW-1B

4-158B