




LEGEND:
 • IRON PIPE FOUND

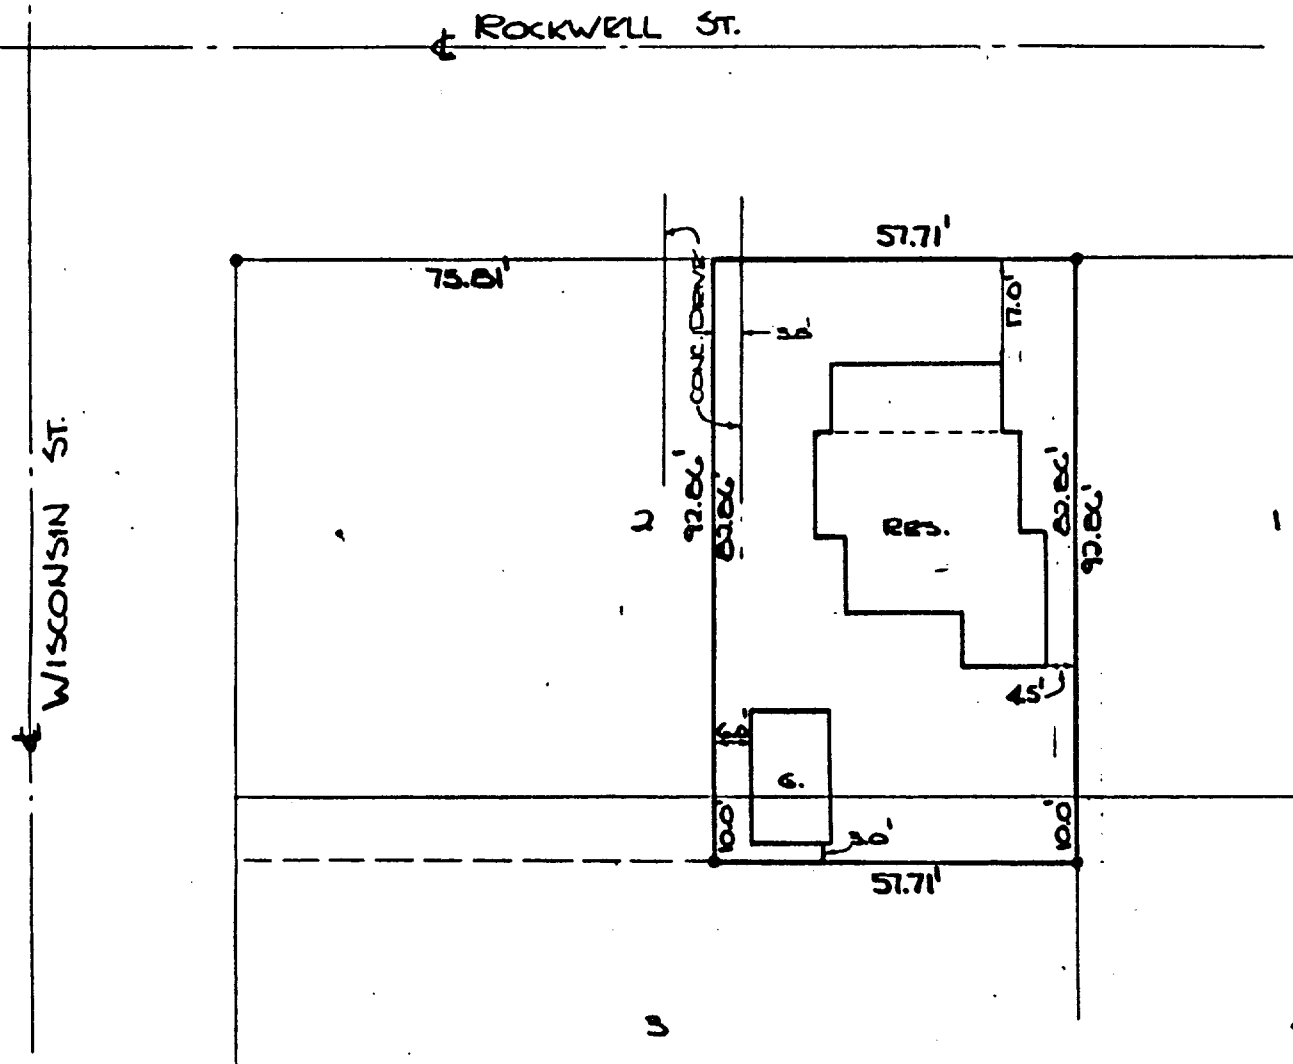

SCALE 1"=20'

DESCRIPTION:

THE EAST 57.7 FEET OF LOT 2 AND THE NORTH 10.0 FEET OF THE EAST 57.7 FEET OF LOT 3 OF BLOCK 4B OF ROCKWELL'S SECOND ADDITION TO THE CITY OF ELKHORN, WALWORTH COUNTY, WISCONSIN.


CERTIFICATE:

I, JAMES F. BIAGI, SURVEYOR, DO HEREBY CERTIFY THAT I HAVE SURVEYED THE PROPERTY HEREON DESCRIBED, AND THAT THE LOCATION OF THE IMPROVEMENTS IS AS SHOWN.

DATE:
 JULY 31, 1979

James F. Biagi
 JAMES F. BIAGI

5-272

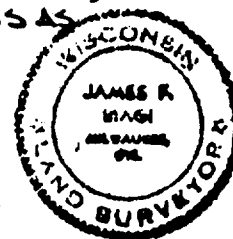

YRW 2-7

4-158B2