


DUNHAM SURVEYING, S.C.
SURVEYING & SUBDIVIDING
DELAVER, WISCONSIN 53115

N

Scale - 1" = 20'
 Ø = 1" Iron Pipe Found
 Q = 3/4" Iron Pipe Found
 ● = good rust mark found 1.4' below ground, set 1" X 24" I.P.
 X = 3/4" Iron Pipe Found-leaning badly & reset at correct corner
 * = 1/2" Iron Pipe Found
 --- = fence line
 Survey ordered by: Tammy Neiger
 313 North Washington
 Elkhorn, WI 53121
 O = 1" Iron Pipe Set

NORTH WASHINGTON STREET

STREET

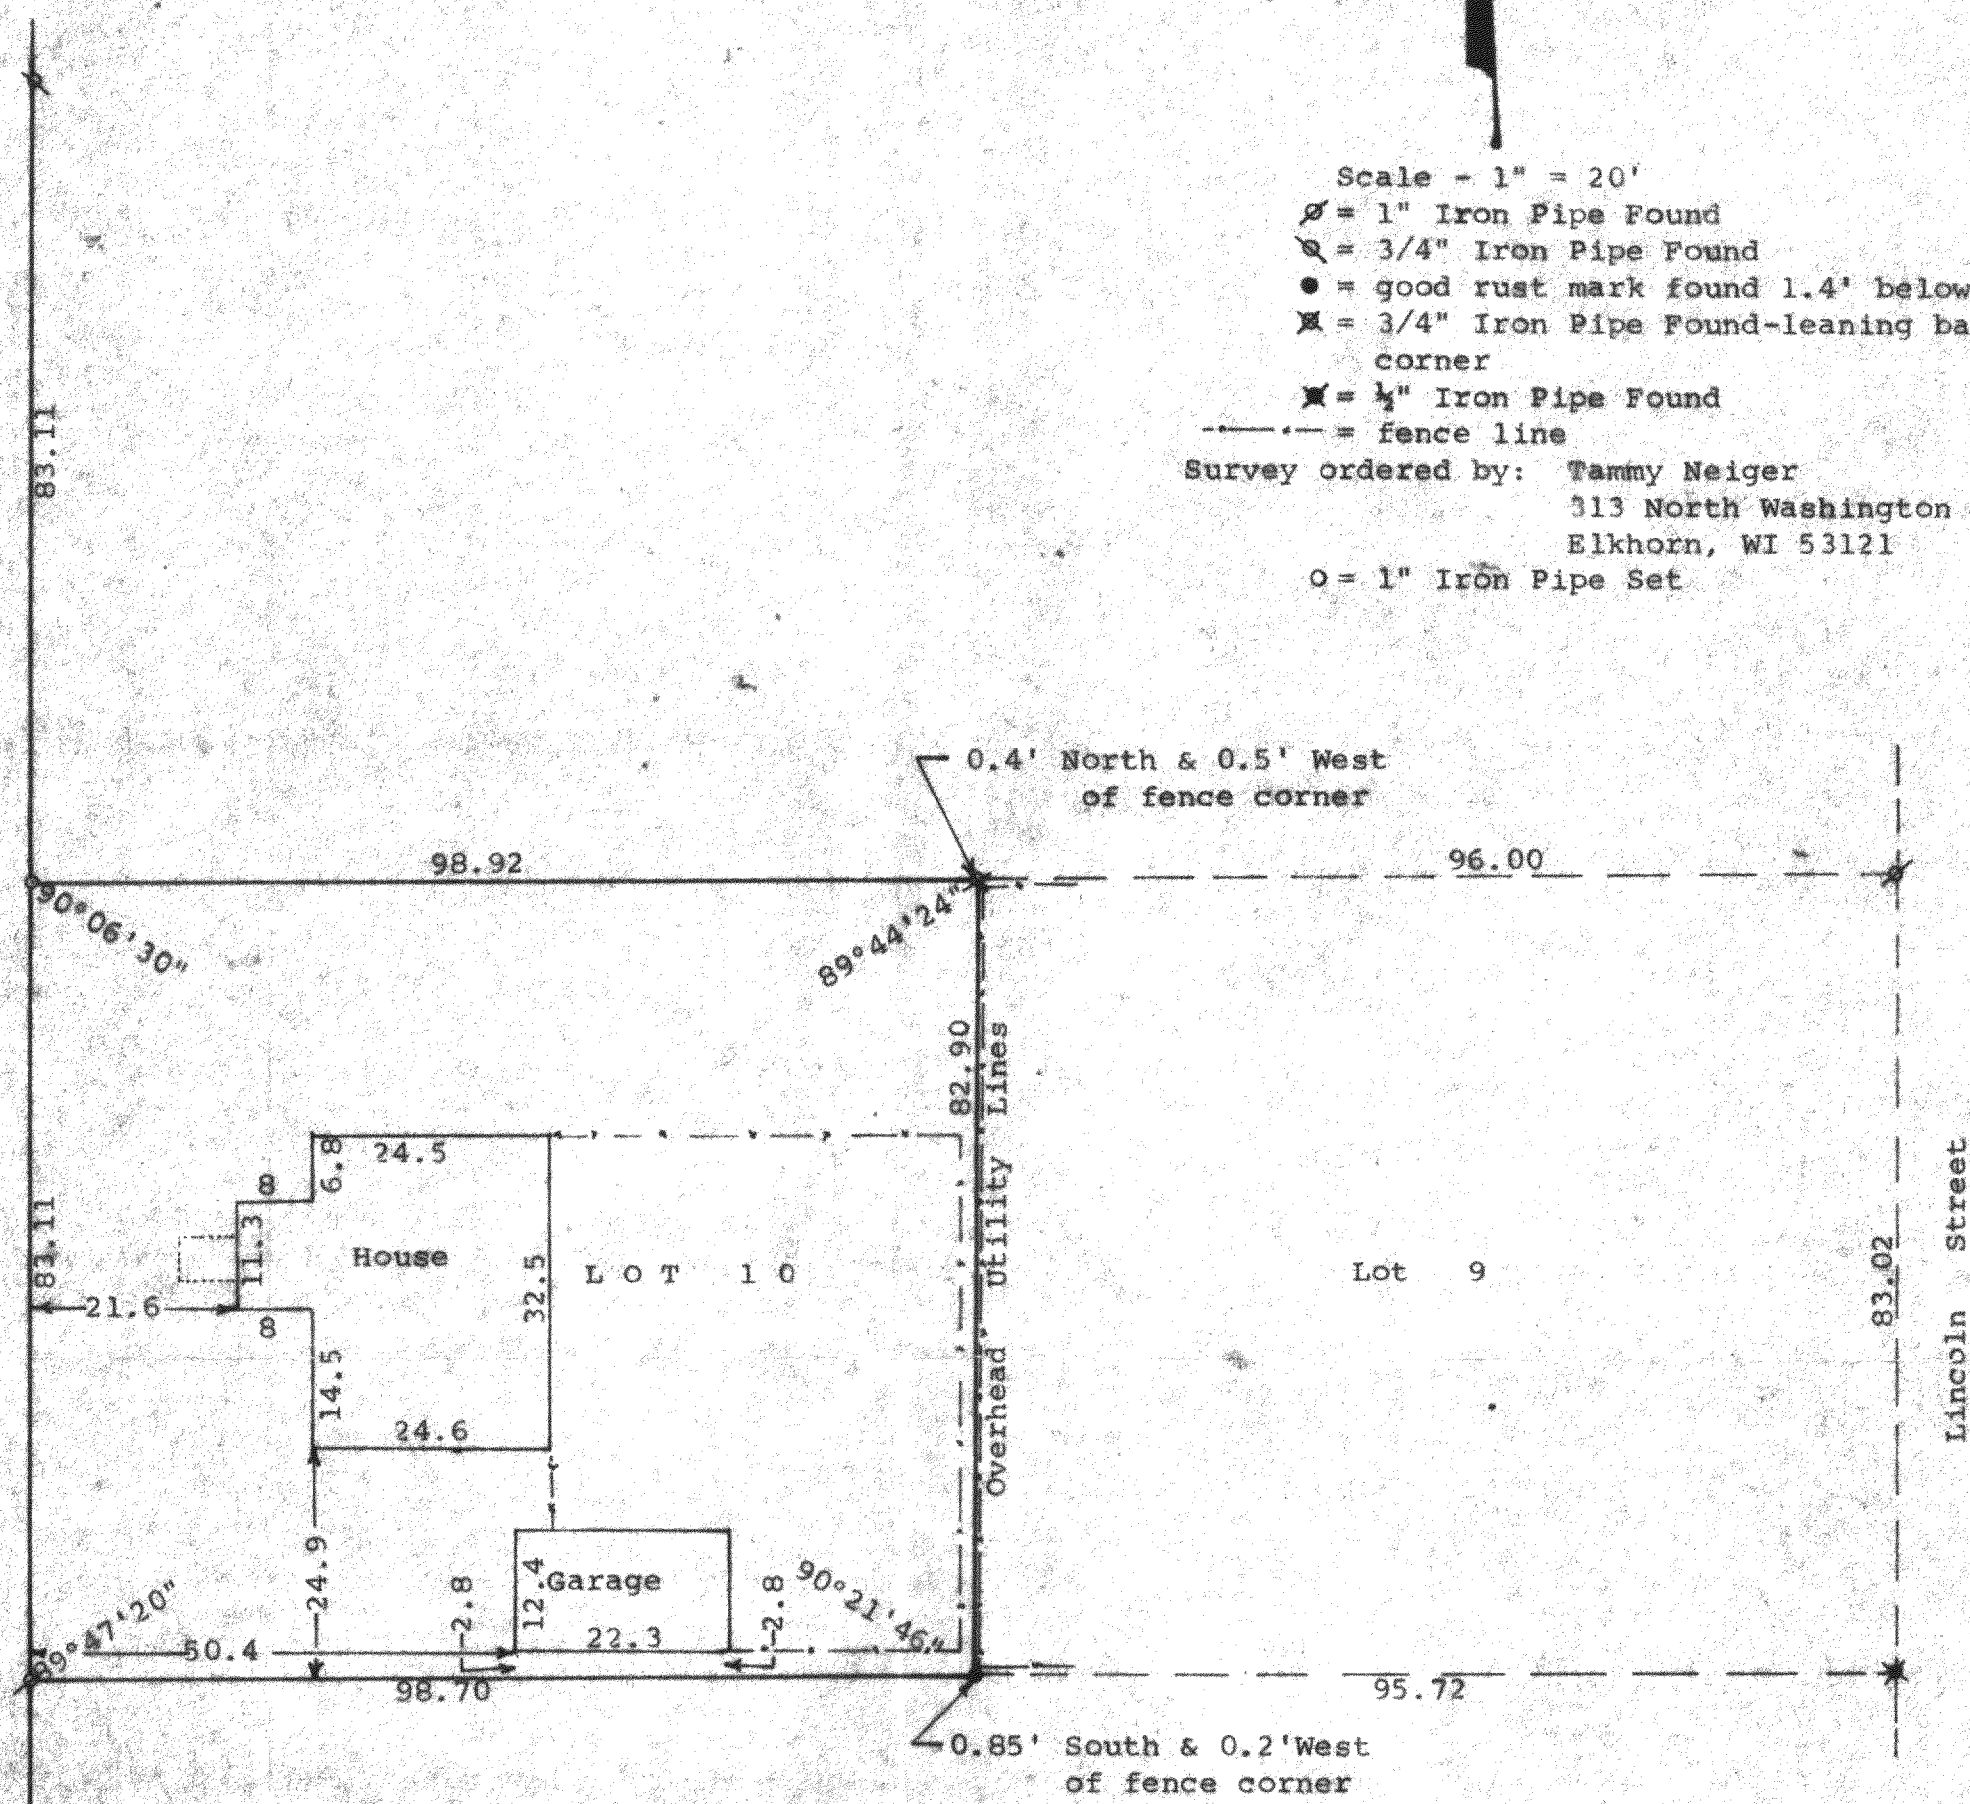

STATE OF WISCONSIN) ss
COUNTY OF WALWORTH)

I, George T. Dunham, Surveyor, certify that I have surveyed the property described as follows:
 Lot 10 in Block 35, Davis Addition to the City of Elkhorn, Walworth County, Wisconsin
 and that the plat shown hereon is a correct representation thereof and shows the size and location of the property, its exterior boundaries, the location of all visible structures and dimensions of all principal buildings thereon, boundary fences, apparent easements, roadways and visible encroachments, if any, and that I have surveyed the property hereon described, according to the official records, to the best of my knowledge and belief.
 October 31, 1997

George T. Dunham
George T. Dunham, Surveyor

