



LINCOLN STREET

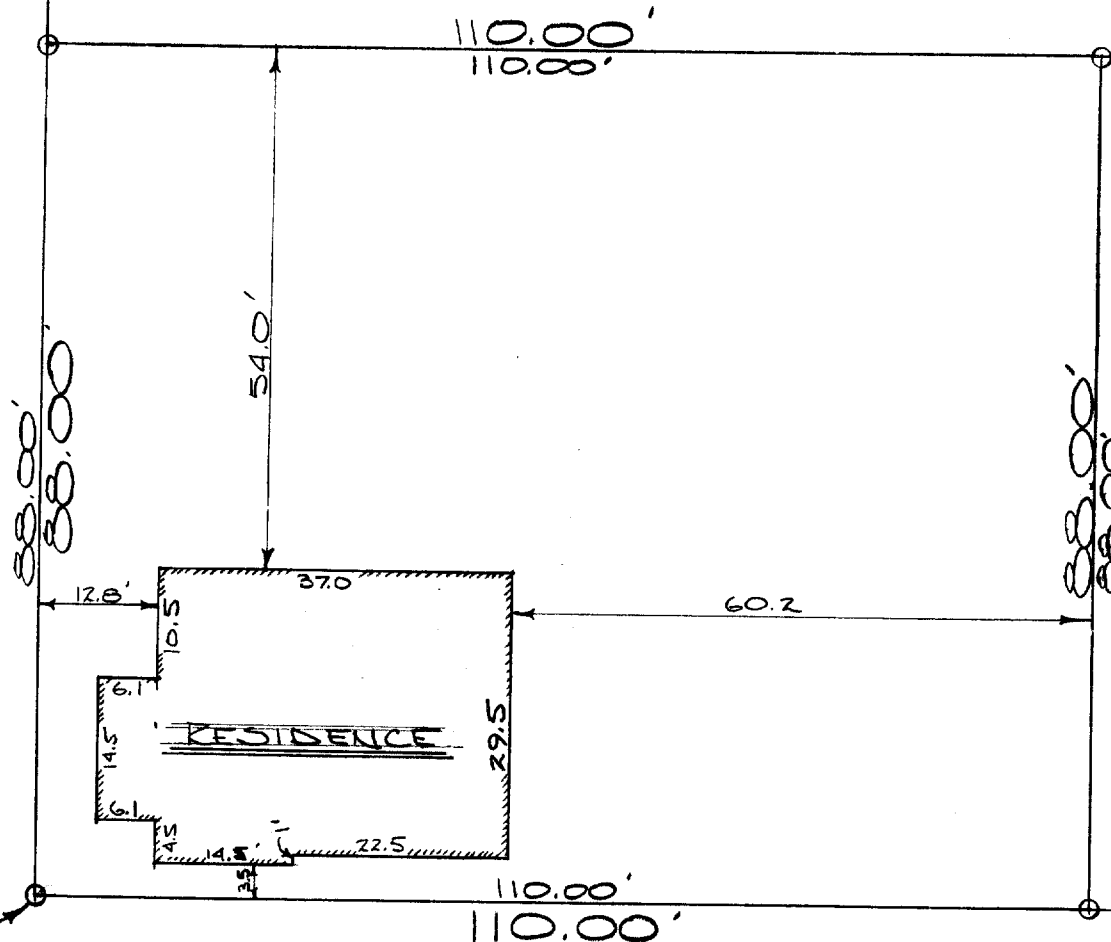

O-INDICATES IRON PIPE

SW CORNER OF BLOCK
#1 OF ROCKWELL'S ADDN
PLACE OF BEGINNING

PAGE STREET

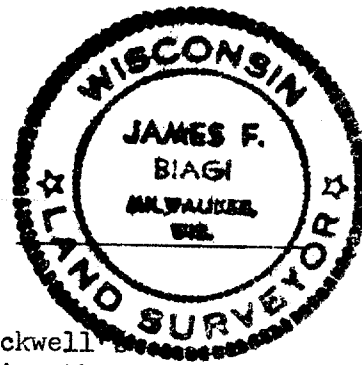

DESCRIPTION: Commencing at the SW corner of Block 1 of Rockwell's Addition to the City of Elkhorn, Walworth County, Wisconsin; thence East along the South line of said Block 110.00 feet, thence North parallel to the West line of said Block 88.00 feet, thence West parallel to the South line of said Block 110.00 feet, thence South along the West line of Block 1, 88.00 feet to the place of beginning.
CERTIFICATE: I, James F. Biagi, surveyor, do hereby certify that I have surveyed the property hereon described and that the location of the improvements are as shown.

August 20, 1966.

James F. Biagi RLS 272