


Nov. 8, 1947

Lloyd L. Jensen
COUNTY SURVEYOR

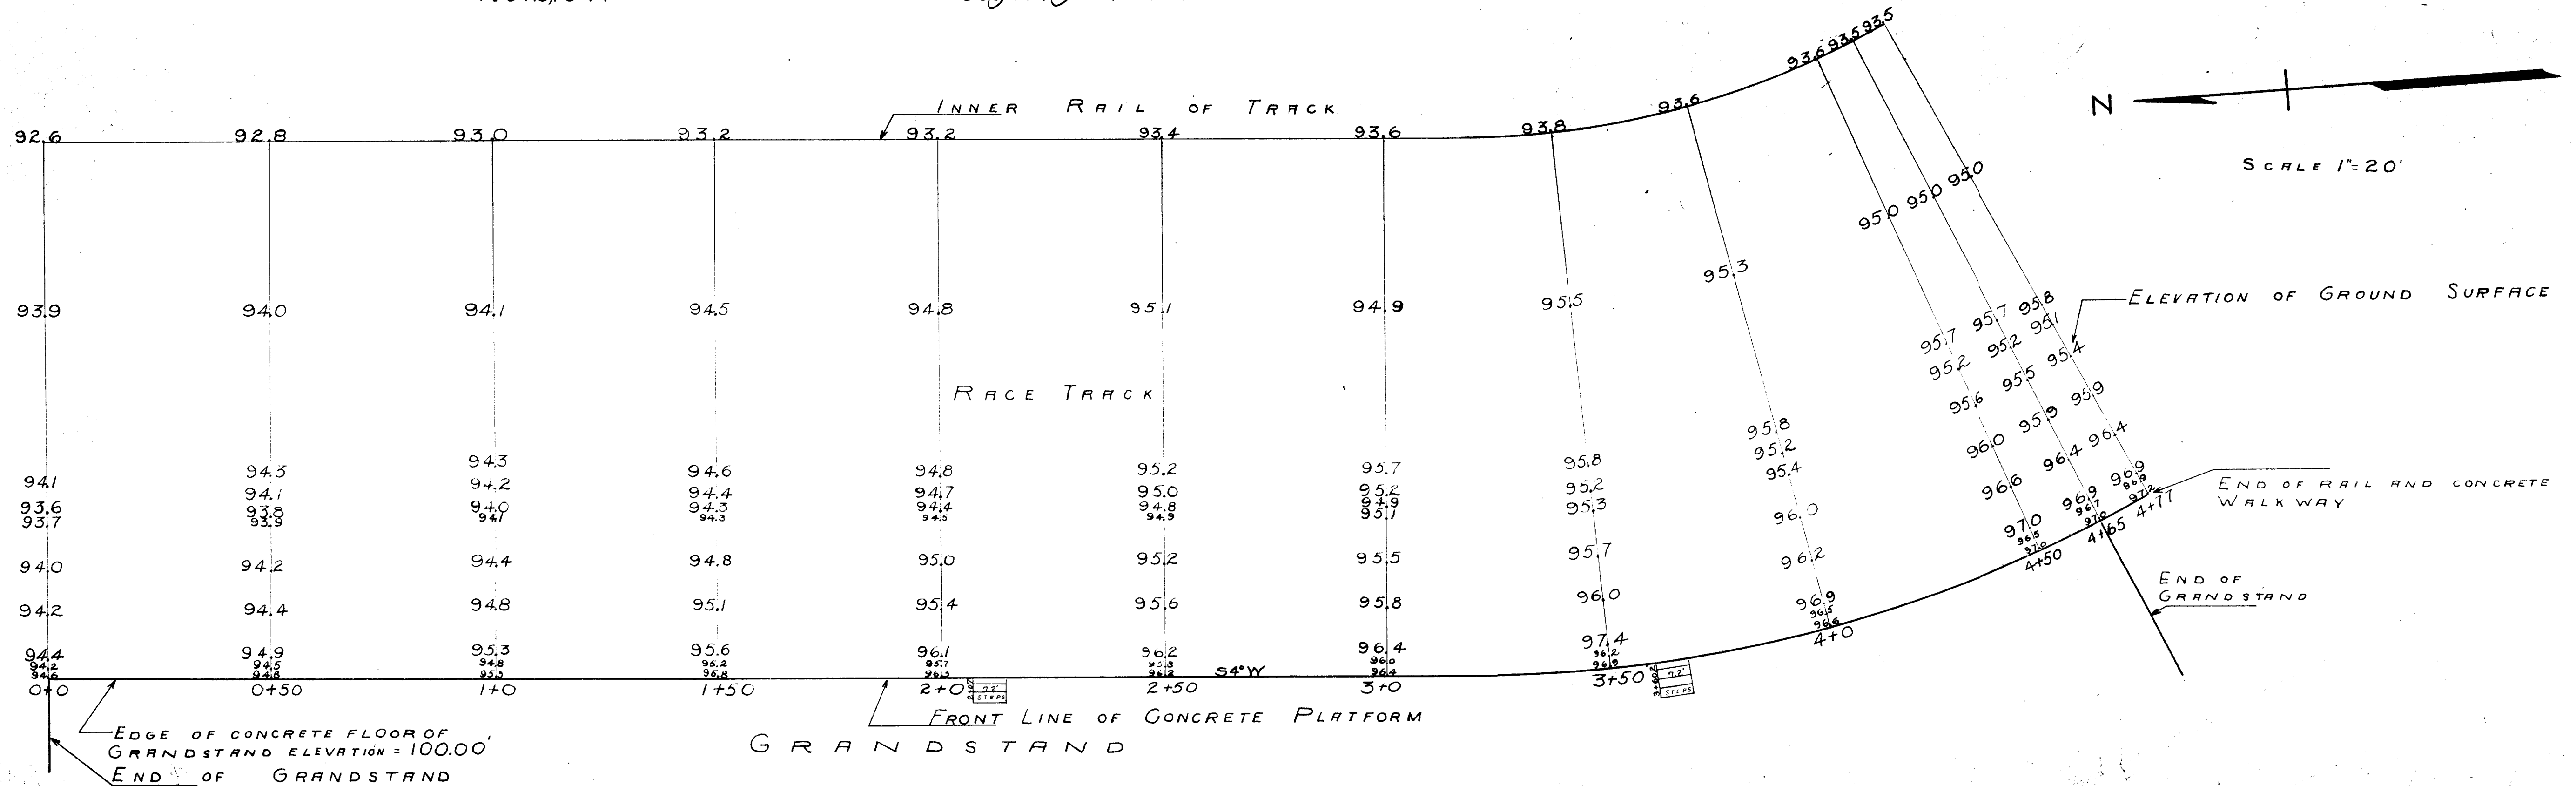

UNE-13

UNE-13. (elevation in front of grandstand)