


LOT 1, HARVEST POINTE NORTH, being all of Lot 3 of Certified Survey Map No. 3180, and located in the Northeast $\frac{1}{4}$, Southeast $\frac{1}{4}$ and Northwest $\frac{1}{4}$ of the Southwest $\frac{1}{4}$ of Section 30, Town 3 North, Range 17 East, City of Elkhorn, Walworth County, Wisconsin.

RECEIVED
AUG - 5 2003
VW

-
- SCALE 1"=30'

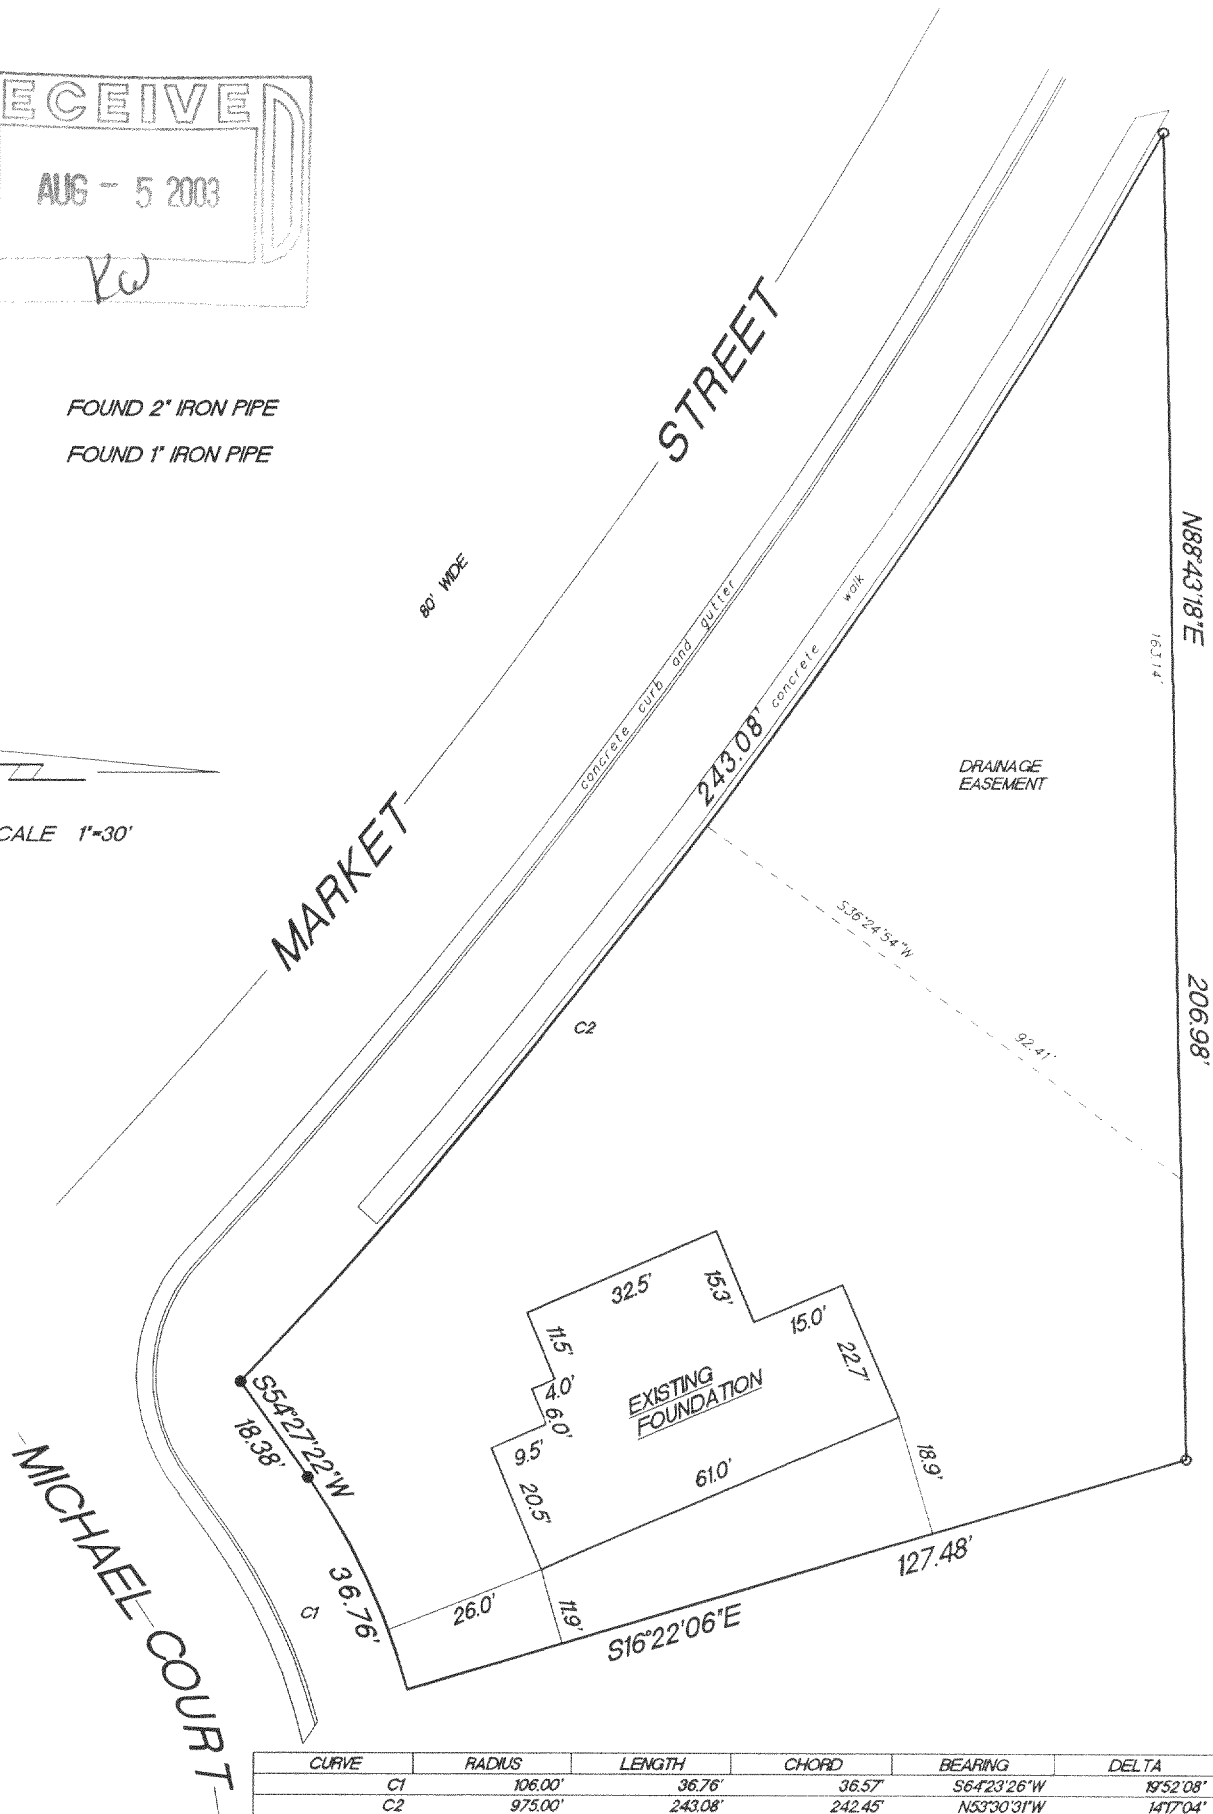

CURVE	RADIUS	LENGTH	CHORD	BEARING	DELTA
C1	106.00'	36.76'	36.57'	S64°23'26"W	19°52'08"
C2	975.00'	243.08'	242.45'	N53°30'31"W	14°17'04"

"This survey is made for the use of the present owners of the property, and also those who purchase, mortgage or guarantee the title thereto within one year from date hereof."

THIS IS NOT AN ORIGINAL SURVEY UNLESS THE SEAL IS RED.

JOB NUMBER

004-1628