
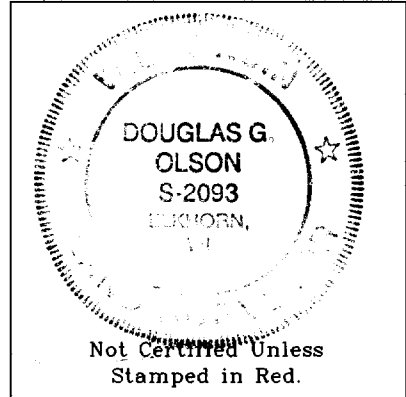
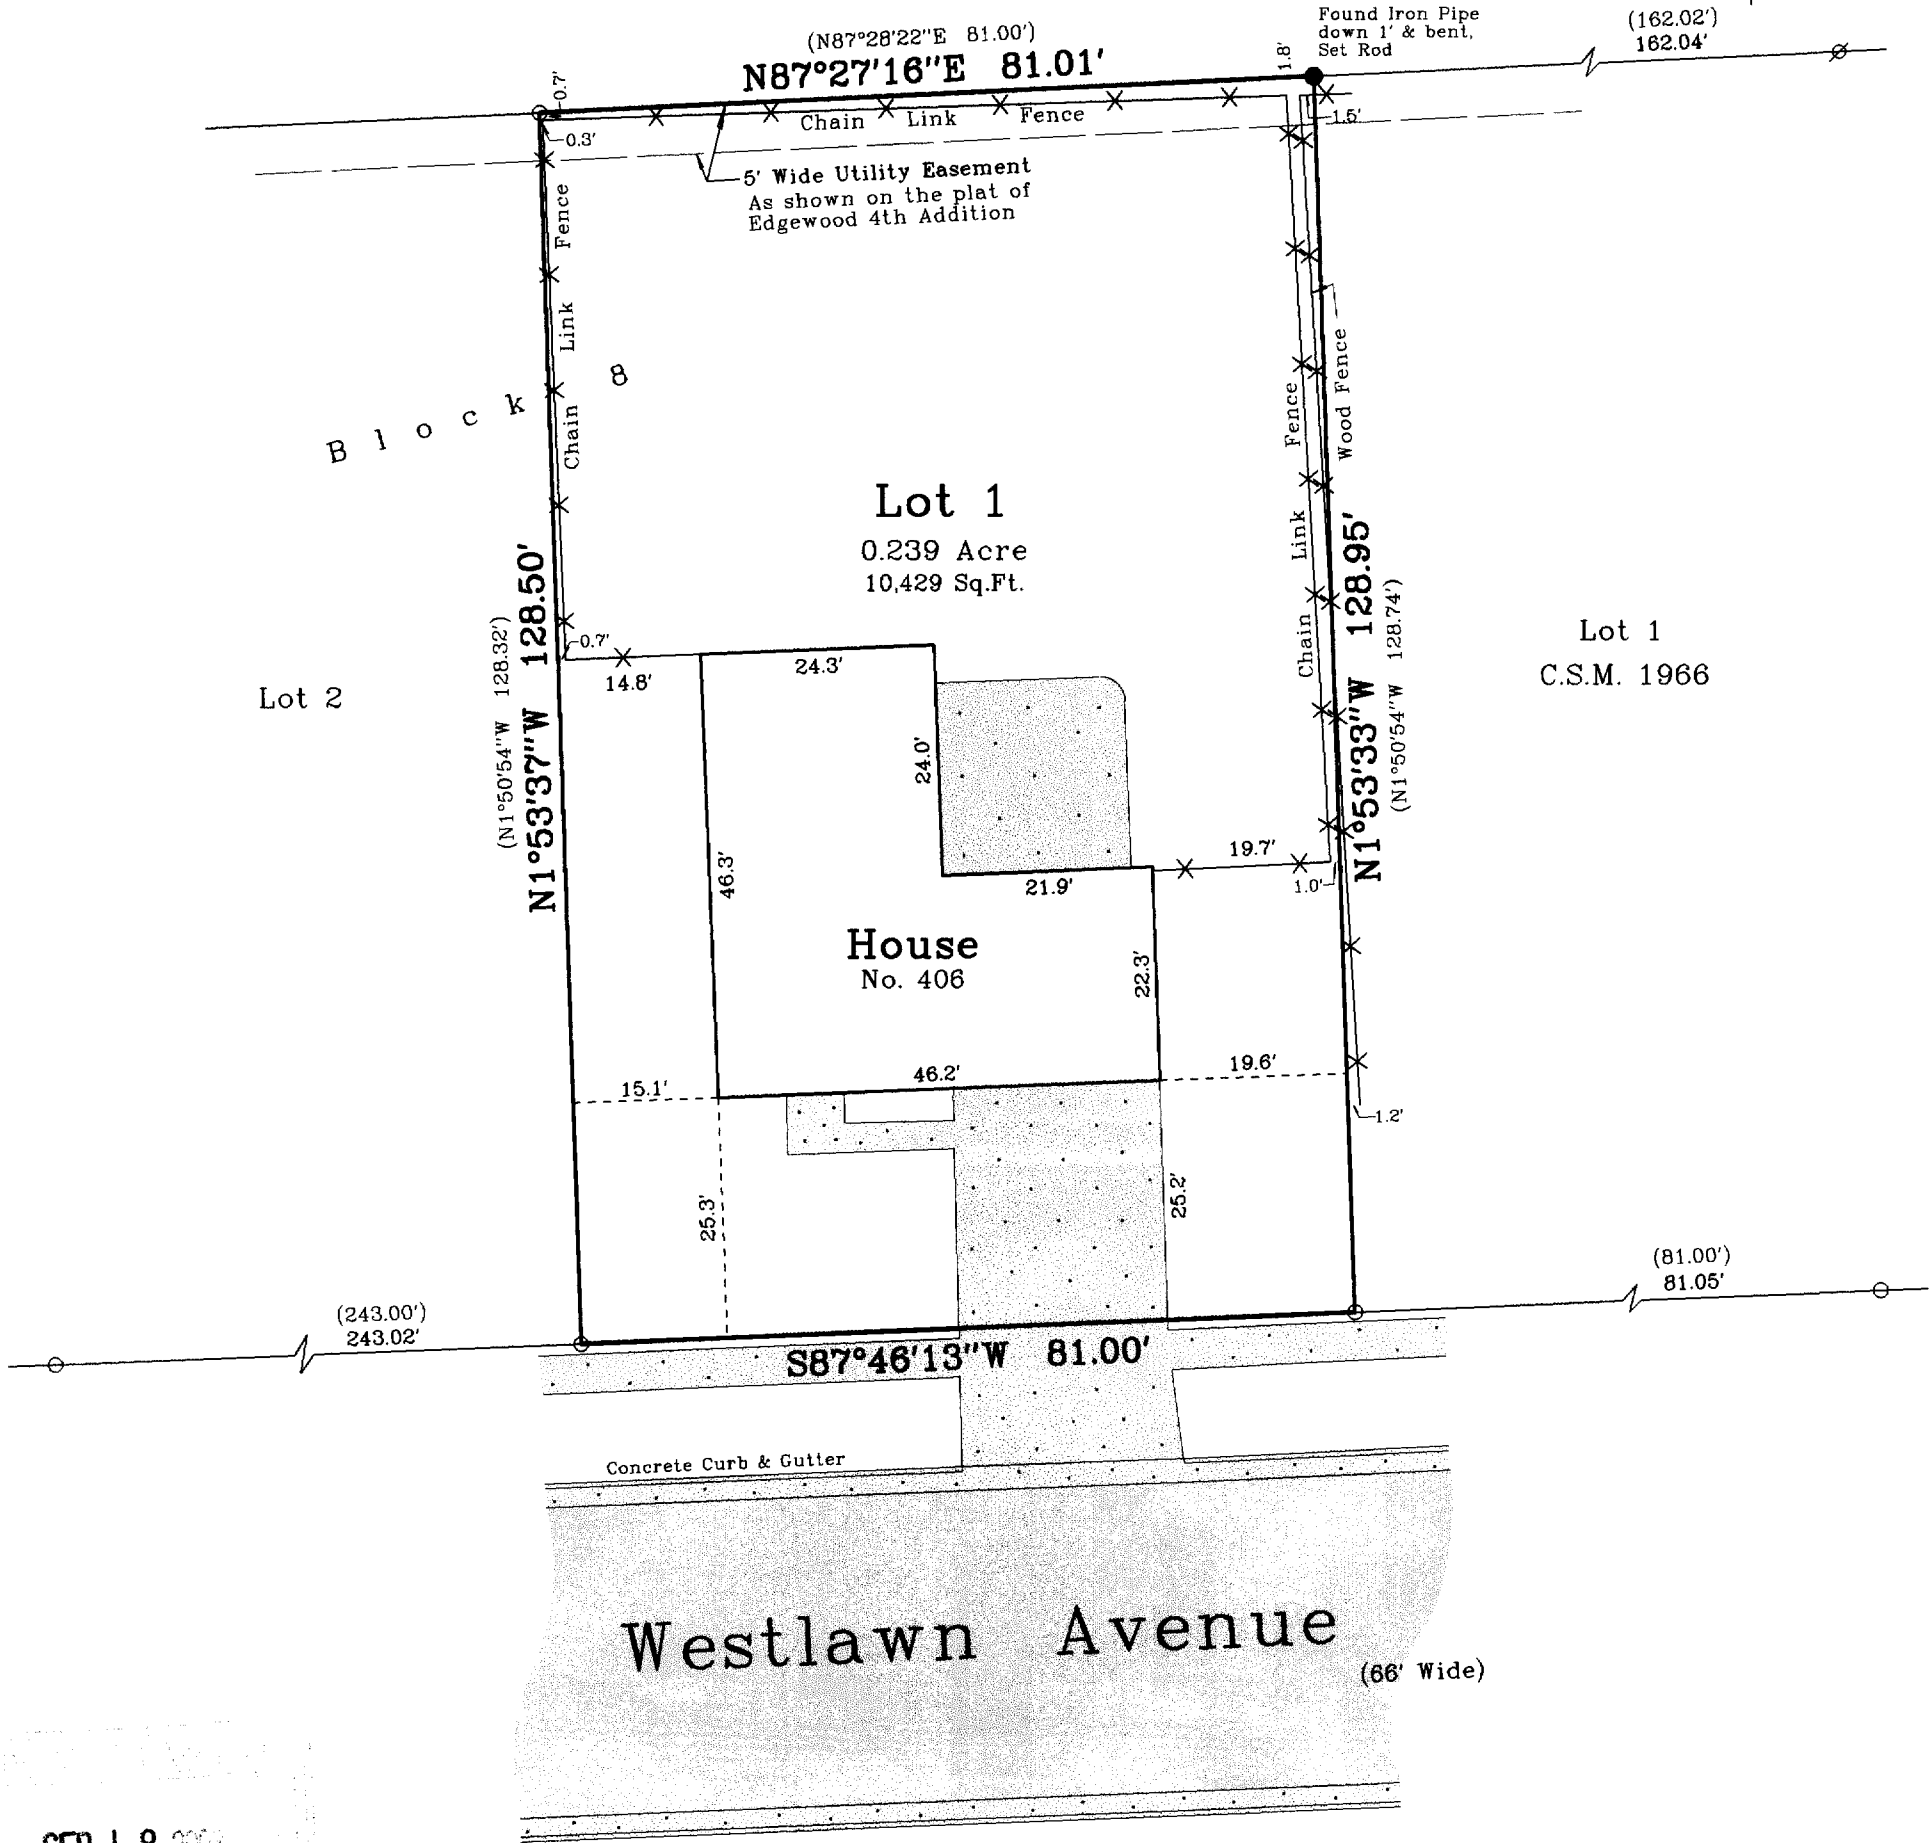


Plat of Survey

of
Lot 1 of Block 8 of Edgewood 4th Addition,
a subdivision located in the Northwest 1/4 of Section 36, Town 3
North, Range 16 East, City of Elkhorn, Walworth County, Wisconsin.

Surveyed for: **Misty Gray**
406 Westlawn Avenue
Elkhorn, Wisconsin. 53121

Tax Parcel
YUNW 00058

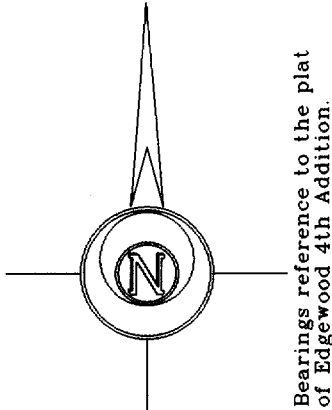

Notes:

- 1) This survey plat is not certified unless signed and sealed in red ink.
- 2) This survey is subject to Wisconsin lien laws. This Plat of Survey is the notice of intent to file lien. Lien waiver required.

Copyright c 2003 by Jensen & Olson Land Surveying, LLC.

All rights reserved. No part of this survey plat may be reproduced or transmitted in any form by any means - graphic, electronic, or mechanical, including photocopying, tracing, or information storage and retrieval systems - without permission in writing from Douglas G. Olson, Jensen & Olson Land Surveying, LLC.

I hereby certify that I have surveyed the above described property and the map hereon is correct to the best of my professional knowledge and belief and shows the size and location of the property, its exterior boundaries, the location and dimensions of all visible structures thereon, boundary fences, apparent easements and roadways and visible encroachments, if any.
This survey is made for the exclusive use of the present owners of property, and also those who purchase, mortgage or guarantee title thereto, within one year from the date hereof.

Douglas G. Olson
Wisconsin Registered Land Surveyor - 2093

- Legend
- Ø Found Iron Pipe
 - Found Iron Rod
 - Set Iron Rod, 3/4" dia.
 - () Recorded Information

Asphalt Surface
Concrete Surface

VEA4-6

Jensen & Olson Land Surveying, LLC

45 South Wisconsin Street P.O. Box 322
Elkhorn, Wisconsin. 53121
Telephone: (262) 723-3434
Facsimile: (262) 723-8044

Scale: 1" = 20'



Survey date: August 12, 2003.
Revisions:

Sheet 1 of 1 Sheets.

Job Reference Number:

004-1642 2003.120