


#139-72

4-166B

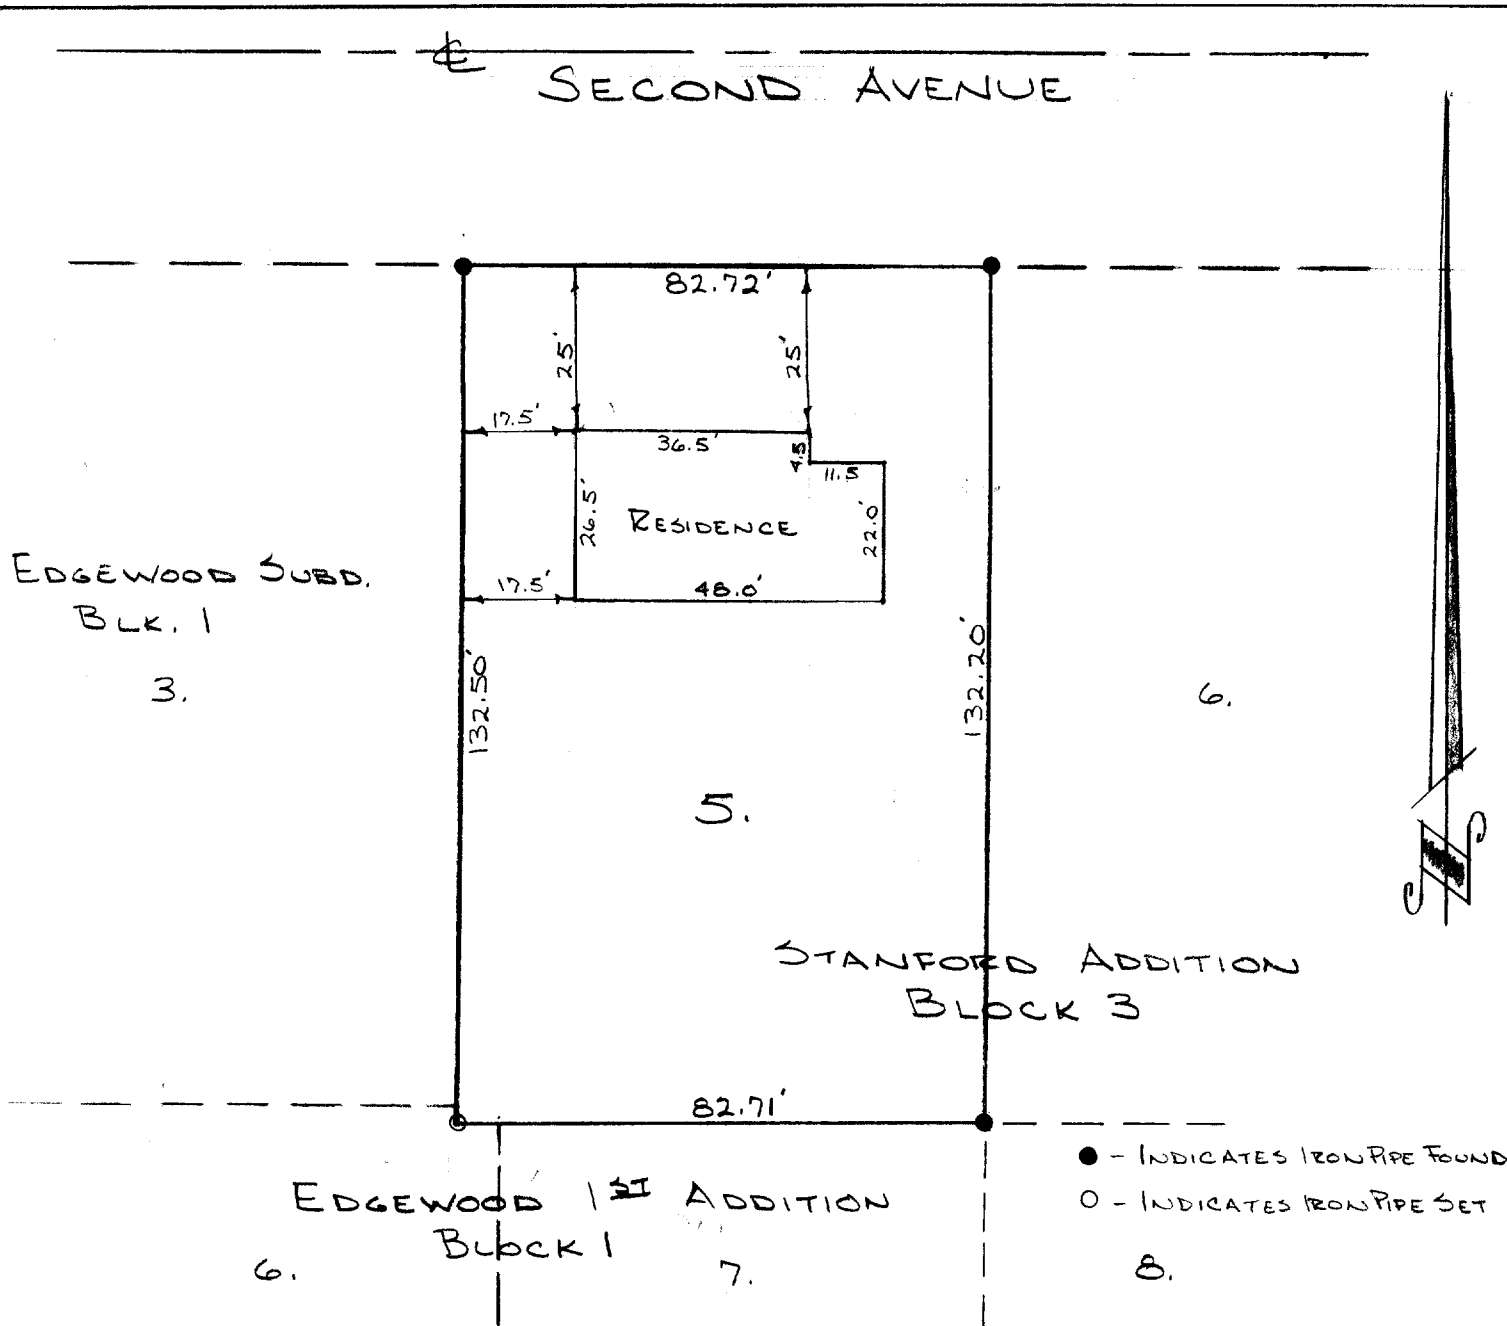

DESCRIPTION:

Lot number Five (5) of Block number Three (3) of Stanford Addition, City of Elkhorn, Walworth County, Wisconsin.

CERTIFICATE:

I, Joseph M. Biagi, surveyor, do hereby certify that I have surveyed the lands hereon described.

November 28, 1972

Joseph M. Biagi
Joseph M. Biagi RLS #12